

SERVICE CONTRACT
Janitorial & Floor Maintenance Service at Plants 1 & 2
Specification No. S-2021-1270BD

THIS CONTRACT is made and entered into as of the date fully executed below, by and between Orange County Sanitation District, with a principal place of business at 10844 Ellis Avenue, Fountain Valley, CA 92708 (hereinafter referred to as "OC San") and Gamboa Services, Inc. dba Corporate Image Maintenance with a principal place of business at 2116 S. Wright Street, Santa Ana, CA 92705 (hereinafter referred to as "Contractor") collectively referred to as the "Parties".

WITNESSETH

WHEREAS, OC San desires to temporarily retain the services of Contractor for Janitorial & Floor Maintenance Service at Plants 1 & 2 ("Services") as described in Exhibit "A"; and

WHEREAS, OC San has chosen Contractor to conduct the Services in accordance with Ordinance No. OC SAN-56; and

WHEREAS, on January 26, 2022, the Board of Directors of OC San, by minute order, authorized execution of this Contract between OC San and Contractor; and

WHEREAS, Contractor is qualified by virtue of experience, training, and expertise to accomplish such Services,

NOW, THEREFORE, in consideration of the mutual promises and mutual benefits exchanged between the Parties, the Parties mutually agree as follows:

1. Introduction

1.1 This Contract and all exhibits hereto (called the "Contract") are made by OC San and the Contractor. The terms and conditions herein exclusively govern the purchase of the Services as described in Exhibit "A".

1.2 Exhibits to this Contract are incorporated by reference and made a part of this Contract as though fully set forth at length herein.

Exhibit "A" Scope of Work
Exhibit "B" Proposal and Best and Final Cost Proposal
Exhibit "C" Determined Insurance Requirement Form
Exhibit "D" Contractor Safety Standards
Exhibit "E" Human Resources Policies

1.3 In the event of any conflict or inconsistency between the provisions of this Contract and any of the provisions of the exhibits hereto, the provisions of this Contract shall in all respects govern and control.

1.4 The provisions of this Contract may be amended or waived only by a writing executed by authorized representatives of both Parties hereto.

1.5 The various headings in this Contract are inserted for convenience only and shall not affect the meaning or interpretation of this Contract or any paragraph or provision hereof.

- 1.6 The term “days”, when used in the Contract, shall mean calendar days, unless otherwise noted as business days.
- 1.7 OC San holidays (non-working days) are as follows: New Year’s Day, Lincoln’s Birthday, Presidents’ Day, Memorial Day, Independence Day, Labor Day, Veterans Day, Thanksgiving Day, Day after Thanksgiving, Christmas Eve, and Christmas Day.
- 1.8 The term “hours”, when used in this Contract, shall be as defined in Exhibit “A”.
- 1.9 Contractor shall provide OC San with all required premiums and/or overtime work at no charge beyond the price provided under “Compensation” below.
- 1.10 Except as expressly provided otherwise, OC San accepts no liability for any expenses, losses, or actions incurred or undertaken by Contractor as a result of work performed in anticipation of purchases of said services by OC San.
2. **Compensation** Compensation to be paid by OC San to Contractor for the Services provided under this Contract shall be a total amount not to exceed Nine Hundred Sixty-one Thousand, Seven Hundred Five Dollars (\$961,705.00).
3. **California Department of Industrial Relations (DIR) Registration and Record of Wages**
 - 3.1 To the extent Contractor’s employees and/or its subcontractors will perform Work during the design and preconstruction phases of a construction contract or perform work under a maintenance contract for which Prevailing Wage Determinations have been issued by the DIR and as more specifically defined under Labor Code Section 1720 et seq, Contractor and its subcontractors shall comply with the registration requirements of Labor Code Section 1725.5. Pursuant to Labor Code Section 1771.4, the work is subject to compliance monitoring and enforcement by the DIR.
 - 3.2 The Contractor and its subcontractors shall maintain accurate payroll records and shall comply with all the provisions of Labor Code Section 1776, and shall submit payroll records to the Labor Commissioner pursuant to Labor Code 1771.4(a)(3). Penalties for non-compliance with the requirements of Section 1776 may be deducted from progress payments per Section 1776.
 - 3.3 Pursuant to Labor Code Section 1776, the Contractor and its subcontractors shall furnish a copy of all certified payroll records to OC San and/or general public upon request, provided the public request is made through OC San, the Division of Apprenticeship Standards or the Division of Labor Standards Enforcement of the Department of Industrial Relations.
 - 3.4 The Contractor and its subcontractors shall comply with the job site notices posting requirements established by the Labor Commissioner per Title 8, California Code of Regulation Section 16461(e).
4. **Payments and Invoicing**
 - 4.1 OC San shall pay, net thirty (30) days, upon receipt and approval, by OC San’s Project Manager or designee, of itemized invoices submitted monthly for Services rendered in accordance with Exhibit “A”. OC San, at its sole discretion, shall be the determining party as to whether the Services have been satisfactorily completed.
 - 4.2 Invoices shall be emailed by Contractor to OC San Accounts Payable at APStaff@OCSan.gov and “INVOICE” with the Purchase Order Number and S-2021-1270BD shall be referenced in the subject line.

5. **Audit Rights** Contractor agrees that, during the term of this Contract and for a period of three (3) years after its termination, OC San shall have access to and the right to examine any directly pertinent books, documents, and records of Contractor relating to the invoices submitted by Contractor pursuant to this Contract.
6. **Scope of Work** Subject to the terms of this Contract, Contractor shall perform the Services identified in Exhibit "A". Contractor shall perform said Services in accordance with generally accepted industry and professional standards.
7. **Modifications to Scope of Work** Requests for modifications to the Scope of Work hereunder can be made by OC San at any time. All modifications must be made in writing and signed by both Parties.
8. **Contract Term**
The Services provided under this Contract shall be for the period of one (1) year commencing on February 1, 2022 and continuing through January 31, 2023
9. **Renewals**
 - 9.1 OC San may exercise the option to renew this Contract for up to four (4) one-year periods, under the terms and conditions contained herein. OC San shall have no obligation to renew nor give reason if it elects not to renew.
 - 9.2 This Contract may be renewed by OC San Purchase Order.
10. **Extensions** The term of this Contract may be extended only by written instrument signed by both Parties.
11. **Performance** Time is of the essence in the performance of the provisions hereof.
12. **Termination**
 - 12.1 OC San reserves the right to terminate this Contract for its convenience, with or without cause, in whole or in part, at any time, by written notice from OC San of intent to terminate. Upon receipt of a termination notice, Contractor shall immediately discontinue all work under this Contract (unless the notice directs otherwise). OC San shall thereafter, within thirty (30) days, pay Contractor for work performed (cost and fee) to the date of termination. Contractor expressly waives any claim to receive anticipated profits to be earned during the uncompleted portion of this Contract. Such notice of termination shall terminate this Contract and release OC San from any further fee, cost or claim hereunder by Contractor other than for work performed to the date of termination.
 - 12.2 OC San reserves the right to terminate this Contract immediately upon OC San's determination that Contractor is not complying with the Scope of Work requirements, if the level of service is inadequate, or for any other default of this Contract.
 - 12.3 OC San may also immediately cancel for default of this Contract in whole or in part by written notice to Contractor:
 - if Contractor becomes insolvent or files a petition under the Bankruptcy Act; or
 - if Contractor sells its business; or
 - if Contractor breaches any of the terms of this Contract; or
 - if the total amount of compensation exceeds the amount authorized under this Contract.

- 12.4 All OC San property in the possession or control of Contractor shall be returned by Contractor to OC San upon demand, or at the termination of this Contract, whichever occurs first.
13. **Insurance** Contractor and all subcontractors shall purchase and maintain, throughout the life of this Contract and any periods of warranty or extensions, insurance in amounts equal to the requirements set forth in the signed Determined Insurance Requirement Form (attached hereto and incorporated herein as Exhibit "C"). Contractor shall not commence work under this Contract until all required insurance is obtained in a form acceptable to OC San, nor shall Contractor allow any subcontractor to commence service pursuant to a subcontract until all insurance required of the subcontractor has been obtained. Failure to maintain required insurance coverage shall result in termination of this Contract.
14. **Indemnification and Hold Harmless Provision** Contractor shall assume all responsibility for damages to property and/or injuries to persons, including accidental death, which may arise out of or be caused by Contractor's services under this Contract, or by its subcontractor(s) or by anyone directly or indirectly employed by Contractor, and whether such damage or injury shall accrue or be discovered before or after the termination of the Contract. Except as to the sole active negligence of or willful misconduct of OC San, Contractor shall indemnify, protect, defend and hold harmless OC San, its elected and appointed officials, officers, agents and employees, from and against any and all claims, liabilities, damages or expenses of any nature, including attorneys' fees: (a) for injury to or death of any person or damage to property or interference with the use of property, arising out of or in connection with Contractor's performance under the Contract, and/or (b) on account of use of any copyrighted or uncopyrighted material, composition, or process, or any patented or unpatented invention, article or appliance, furnished or used under the Contract, and/or (c) on account of any goods and services provided under this Contract. This indemnification provision shall apply to any acts or omissions, willful misconduct, or negligent misconduct, whether active or passive, on the part of Contractor or anyone employed by or working under Contractor. To the maximum extent permitted by law, Contractor's duty to defend shall apply whether or not such claims, allegations, lawsuits, or proceedings have merit or are meritless, or which involve claims or allegations that any of the parties to be defended were actively, passively, or concurrently negligent, or which otherwise assert that the parties to be defended are responsible, in whole or in part, for any loss, damage, or injury. Contractor agrees to provide this defense immediately upon written notice from OC San, and with well qualified, adequately insured, and experienced legal counsel acceptable to OC San.
15. **Contractor Safety Standards and Human Resources Policies** OC San requires Contractor and its subcontractor(s) to follow and ensure their employees follow all Federal, State, and local regulations as well as Contractor Safety Standards while working at OC San locations. If during the course of the Contract it is discovered that Contractor Safety Standards do not comply with Federal, State, or local regulations, then the Contractor is required to follow the most stringent regulatory requirement at no additional cost to OC San. Contractor and all of its employees and subcontractors, shall adhere to all applicable Contractor Safety Standards attached hereto as Exhibit "D" and the Human Resources Policies in Exhibit "E".
16. **Warranties** In addition to the warranties stated in Exhibit "A", the following shall apply:
- 16.1 Manufacturer's standard warranty shall apply. All manufacturer warranties shall commence on the date of acceptance by the OC San Project Manager or designee of the work as complete.

- 16.2 Contractor's Warranty (Guarantee): If within a one (1) year period of completion of all work as specified in Exhibit "A", OC San informs Contractor that any portion of the Services provided fails to meet the standards required under this Contract, Contractor shall, within the time agreed to by OC San and Contractor, take all such actions as are necessary to correct or complete the noted deficiency(ies) at Contractor's sole expense.
17. **Force Majeure** Neither party shall be liable for delays caused by accident, flood, acts of God, fire, labor trouble, war, acts of government or any other cause beyond its control, but said party shall use reasonable efforts to minimize the extent of the delay. Work affected by a Force Majeure condition may be rescheduled by mutual consent of the Parties or may be eliminated from the Contract.
18. **Freight (F.O.B. Destination)** Contractor assumes full responsibility for all transportation, transportation scheduling, packing, handling, insurance, and other services associated with delivery of all products deemed necessary under this Contract.
19. **Familiarity with Work** By executing this Contract, Contractor warrants that: 1) it has investigated the work to be performed; and 2) it understands the facilities, difficulties and restrictions of the work under this Contract. Should Contractor discover any latent or unknown conditions materially differing from those inherent in the work or as represented by OC San, it shall immediately inform OC San of this and shall not proceed, except at Contractor's risk, until written instructions are received from OC San.
20. **Regulatory Requirements** Contractor shall perform all work under this Contract in strict conformance with applicable Federal, State, and local regulatory requirements including, but not limited to, 40 CFR 122, 123, 124, 257, 258, 260, 261, and 503, Title 22, 23, and California Water Codes Division 2.
21. **Environmental Compliance** Contractor shall, at its own cost and expense, comply with all Federal, State, and local environmental laws, regulations, and policies which apply to the Contractor, its subcontractors, and the Services, including, but not limited to, all applicable Federal, State, and local air pollution control laws and regulations.
22. **Licenses, Permits, Ordinances and Regulations** Contractor represents and warrants to OC San that it has obtained all licenses, permits, qualifications, and approvals of whatever nature that are legally required to engage in this work. Any and all fees required by Federal, State, County, City and/or municipal laws, codes and/or tariffs that pertain to the work performed under the terms of this Contract will be paid by Contractor.
23. **Applicable Laws and Regulations** Contractor shall comply with all applicable Federal, State, and local laws, rules, and regulations. Contractor also agrees to indemnify and hold harmless from any and all damages and liabilities assessed against OC San as a result of Contractor's noncompliance therewith. Any provision required by law to be included herein shall be deemed included as a part of this Contract whether or not specifically included.
24. **Contractor's Employees Compensation**
- 24.1 **Davis-Bacon Act** – Contractor will pay and will require all subcontractors to pay all employees on said project a salary or wage at least equal to the prevailing rate of per diem wages as determined by the Secretary of Labor in accordance with the Davis-Bacon Act for each craft or type of worker needed to perform the Contract. The provisions of the Davis-Bacon Act shall apply only if the Contract is in excess of two thousand dollars (\$2,000.00) and when twenty-five percent (25%) or more of the Contract is funded by Federal assistance. If the aforesaid conditions are met, a copy of the provisions of the Davis-Bacon

Act to be complied with are incorporated herein as a part of this Contract and referred to by reference.

- 24.2 General Prevailing Rate – OC San has been advised by the State of California Director of Industrial Relations of its determination of the general prevailing rate of per diem wages and the general prevailing rate for legal holiday and overtime work in the locality in which the work is to be performed for each craft or type of work needed to execute this Contract, and copies of same are on file in the Engineering Department. The Contractor agrees that not less than said prevailing rates shall be paid to workers employed on this Contract as required by Labor Code Section 1774 of the State of California. Per California Labor Code 1773.2, OC San will have on file copies of the prevailing rate of per diem wages at its principal office and at each project site, which shall be made available to any interested party upon request.
- 24.3 Forfeiture For Violation – Contractor shall, as a penalty to OC San, forfeit fifty dollars (\$50.00) for each calendar day or portion thereof for each worker paid (either by the Contractor or any subcontractor under it) less than the prevailing rate of per diem wages as set by the Director of Industrial Relations, in accordance with Sections 1770-1780 of the California Labor Code for the work provided for in this Contract, all in accordance with Section 1775 of the Labor Code of the State of California.
- 24.4 Apprentices – Sections 1777.5, 1777.6, 1777.7 of the Labor Code of the State of California, regarding the employment of apprentices are applicable to this Contract and the Contractor shall comply therewith if the prime contract involves thirty thousand dollars (\$30,000.00) or more or twenty (20) working days or more; or if contracts of specialty contractors not bidding for work through the general or prime Contractor are two thousand dollars (\$2,000.00) or more or five (5) working days or more.
- 24.5 Workday – In the performance of this Contract, not more than eight (8) hours shall constitute a day's work, and the Contractor shall not require more than eight (8) hours of labor in a day from any person employed by it hereunder. Contractor shall conform to Article 3, Chapter 1, Part 7 (Section 1810 et seq.) of the Labor Code of the State of California and shall forfeit to OC San as a penalty, the sum of twenty-five dollars (\$25.00) for each worker employed in the execution of this Contract by Contractor or any subcontractor for each calendar day during which any worker is required or permitted to labor more than eight (8) hours in any one (1) calendar day and forty (40) hours in any one (1) week in violation of said Article. Contractor shall keep an accurate record showing the name and actual hours worked each calendar day and each calendar week by each worker employed by Contractor in connection with the project.
- 24.6 Record of Wages; Inspection – Contractor agrees to maintain accurate payroll records showing the name, address, social security number, work classification, straight-time and overtime hours worked each day and week, and the actual per diem wages paid to each journeyman, apprentice, worker or other employee employed by it in connection with the project and agrees to require that each of its subcontractors do the same. All payroll records shall be certified as accurate by the applicable Contractor or subcontractor or its agent having authority over such matters. Contractor further agrees that its payroll records and those of its subcontractors shall be available to the employee or employee's representative, the Division of Labor Standards Enforcement, and the Division of Apprenticeship Standards and shall comply with all of the provisions of Labor Code Section 1776, in general. Penalties for non-compliance with the requirements of Section 1776 may be deducted from project payments per the requirements of Section 1776.

25. **South Coast Air Quality Management District's (SCAQMD) Requirements** It is Contractor's responsibility that all equipment furnished and installed be in accordance with the latest rules and regulations of the South Coast Air Quality Management District (SCAQMD). All Contract work practices, which may have associated emissions such as sandblasting, open field spray painting or demolition of asbestos containing components or structures, shall comply with the appropriate rules and regulations of the SCAQMD.
26. **Governing Law** This Contract shall be governed by and interpreted under the laws of the State of California and the Parties submit to jurisdiction in the County of Orange, in the event any action is brought in connection with this Contract or the performance thereof.
27. **Breach** The waiver of either party of any breach or violation of, or default under, any provision of this Contract, shall not be deemed a continuing waiver by such party of any other provision or of any subsequent breach or violation of this Contract or default thereunder. Any breach by Contractor to which OC San does not object shall not operate as a waiver of OC San's rights to seek remedies available to it for any subsequent breach.
28. **Remedies** In addition to other remedies available in law or equity, if the Contractor fails to make delivery of the goods or Services or repudiates its obligations under this Contract, or if OC San rejects the goods or Services or revokes acceptance of the goods or Services, OC San may (1) cancel the Contract; (2) recover whatever amount of the purchase price OC San has paid, and/or (3) "cover" by purchasing, or contracting to purchase, substitute goods or Services for those due from Contractor. In the event OC San elects to "cover" as described in (3), OC San shall be entitled to recover from Contractor as damages the difference between the cost of the substitute goods or Services and the Contract price, together with any incidental or consequential damages.
29. **Dispute Resolution**
- 29.1 In the event of a dispute as to the construction or interpretation of this Contract, or any rights or obligations hereunder, the Parties shall first attempt, in good faith, to resolve the dispute by mediation. The Parties shall mutually select a mediator to facilitate the resolution of the dispute. If the Parties are unable to agree on a mediator, the mediation shall be conducted in accordance with the Commercial Mediation Rules of the American Arbitration Agreement, through the alternate dispute resolution procedures of Judicial Arbitration through Mediation Services of Orange County ("JAMS"), or any similar organization or entity conducting an alternate dispute resolution process.
- 29.2 In the event the Parties are unable to timely resolve the dispute through mediation, the issues in dispute shall be submitted to arbitration pursuant to California Code of Civil Procedure, Part 3, Title 9, Sections 1280 et seq. For such purpose, an agreed arbitrator shall be selected, or in the absence of agreement, each party shall select an arbitrator, and those two (2) arbitrators shall select a third. Discovery may be conducted in connection with the arbitration proceeding pursuant to California Code of Civil Procedure Section 1283.05. The arbitrator, or three (3) arbitrators acting as a board, shall take such evidence and make such investigation as deemed appropriate and shall render a written decision on the matter in question. The arbitrator shall decide each and every dispute in accordance with the laws of the State of California. The arbitrator's decision and award shall be subject to review for errors of fact or law in the Superior Court for the County of Orange, with a right of appeal from any judgment issued therein.
30. **Attorney's Fees** If any action at law or in equity or if any proceeding in the form of an Alternative Dispute Resolution (ADR) is necessary to enforce or interpret the terms of this

Contract, the prevailing party shall be entitled to reasonable attorney's fees, costs and necessary disbursements in addition to any other relief to which he may be entitled.

31. **Survival** The provisions of this Contract dealing with Payment, Warranty, Indemnity, and Forum for Enforcement, shall survive termination or expiration of this Contract.
32. **Severability** If any section, subsection, or provision of this Contract, or any agreement or instrument contemplated hereby, or the application of such section, subsection, or provision is held invalid, the remainder of this Contract or instrument in the application of such section, subsection or provision to persons or circumstances other than those to which it is held invalid, shall not be affected thereby, unless the effect of such invalidity shall be to substantially frustrate the expectations of the Parties.
33. **Damage to OC San's Property** Any of OC San's property damaged by Contractor, any subcontractors or by the personnel of either will be subject to repair or replacement by Contractor at no cost to OC San.
34. **Disclosure** Contractor agrees not to disclose, to any third party, data or information generated from this project without the prior written consent from OC San.
35. **Independent Contractor** The legal relationship between the parties hereto is that of an independent contractor, and nothing herein shall be deemed to make Contractor an OC San employee. During the performance of this Contract, Contractor and its officers, employees, and agents shall act in an independent capacity and shall not act as OC San's officers, employees, or agents. Contractor and its officers, employees, and agents shall obtain no rights to any benefits which accrue to OC San's employees.
36. **Limitations upon Subcontracting and Assignment** Contractor shall not delegate any duties nor assign any rights under this Contract without the prior written consent of OC San. Any such attempted delegation or assignment shall be void.
37. **Third Party Rights** Nothing in this Contract shall be construed to give any rights or benefits to anyone other than OC San and Contractor.
38. **Non-Liability of OC San Officers and Employees** No officer or employee of OC San shall be personally liable to Contractor, or any successor-in-interest, in the event of any default or breach by OC San or for any amount which may become due to Contractor or to its successor, or for breach of any obligation for the terms of this Contract.
39. **Read and Understood** By signing this Contract, Contractor represents that he has read and understood the terms and conditions of the Contract.
40. **Authority to Execute** The persons executing this Contract on behalf of the Parties warrant that they are duly authorized to execute this Contract and that by executing this Contract, the Parties are formally bound.
41. **Entire Agreement** This Contract constitutes the entire agreement of the Parties and supersedes all prior written or oral and all contemporaneous oral agreements, understandings, and negotiations between the Parties with respect to the subject matter hereof.

42. Notices All notices under this Contract must be in writing. Written notice shall be delivered by personal service or sent by registered or certified mail, postage prepaid, return receipt requested, or by any other overnight delivery service which delivers to the noticed destination and provides proof of delivery to the sender. Rejection or other refusal to accept or the inability to deliver because of changed address for which no notice was given as provided hereunder shall be deemed to be receipt of the notice, demand or request sent. All notices shall be effective when first received at the following addresses:

OC San: Darius Ghazi
Senior Buyer
Orange County Sanitation District
10844 Ellis Avenue
Fountain Valley, CA 92708

Contractor: Michael Gamboa
Vice President
Gamboa Services, Inc. dba Corporate Image Maintenance
2116 S. Wright Street
Santa Ana, CA 92705

Each party shall provide the other party written notice of any change in address as soon as practicable.

[Intentionally left blank. Signatures follow on the next page.]

IN WITNESS WHEREOF, intending to be legally bound, the Parties hereto have caused this Contract to be signed by the duly authorized representatives.

ORANGE COUNTY SANITATION DISTRICT

Dated: _____

By: _____

John B. Withers
Chair, Board of Directors

Dated: _____

By: _____

Kelly A. Lore
Clerk of the Board

Dated: _____

By: _____

Ruth Zintzun
Purchasing and Contracts Manager

**GAMBOA SERVICES, INC.
DBA CORPORATE IMAGE MAINTENANCE**

Dated: _____

By: _____

Print Name and Title of Officer

BG:CMM

Exhibit “A”

**ADDENDUM NO. 1 TO THE REQUEST FOR PROPOSALS
SCOPE OF WORK AS MODIFIED BY ADDENDUM NO. 1
APPENDICES A-1 THROUGH A-4**

September 7, 2021

ADDENDUM #1

NOTICE TO PROPOSERS

**Janitorial & Floor Maintenance Service at Plants 1 & 2
SPECIFICATION NO. S-2021-1270BD**

- **QUESTION CUT-OFF DATE: September 6, 2021 at 2:00 P.M. PT**
- **RFP SUBMITTAL DATE: September 28, 2021 at 2:00 P.M. PT**

A non-mandatory pre-proposal meeting scheduled for September 1, 2021 at 10:00 A.M. PT was held via Microsoft Teams.

The following additions, modifications, corrections, deletions, and clarifications are hereby made to the RFP document named above.

DELETIONS

Delete Section 2.12 in General Provisions, Page 5 of 16.

~~**2.12 OC San Personal Protective Equipment (PPE) Requirements**
Refer to PPE Requirements identified in Section 1 of this RFP.~~

Delete the first two sentences from Section 5.16.4 in Exhibit A, Scope of Work as it conflicts with Section 5.6:

5.16.4 Minimum Staffing, Breaks and Extraordinary Services

~~**The Contractor shall provide no less than the minimum number of staff to meet the requirements of this scope of work and to the satisfaction of the OC San Representative.**~~

~~**For this Contract, OC San requires the Contractor to provide a total of Seven (7) Full-time janitors, Three (3) Detail Porters and Two (2) Full-Time supervisors; one for each of the two (2) Plant locations.**~~

Serving:

Anaheim
Brea
Buena Park
Cypress
Fountain Valley
Fullerton
Garden Grove
Huntington Beach
Irvine
La Habra
La Palma
Los Alamitos
Newport Beach
Orange
Placentia
Santa Ana
Seal Beach
Stanton
Tustin
Villa Park
County of Orange
Costa Mesa Sanitary District
Midway City Sanitary District
Irvine Ranch Water District
Yorba Linda Water District

QUESTIONS

- 1 Question: Is this project considered a Prevailing Wage Contract?
- Answer:** **Yes, please see attached Important Notice from the State of California (Department of Industrial Relations) regarding the Prevailing Wage Rates for Janitorial services. Also attached is the General Prevailing Wage Determination for the Janitor Classification. The Notice increased the Basic Hourly Rate for the Prevailing Wage Determination to \$14.00/Hr (currently) and \$15.00/Hr (Effective 1/1/2022 with the increase of minimum wage). The Prevailing rate benefit payments as listed (Effective 5/1/2015) are still current, in effect and required to be paid by the employer in addition to the Basic Hourly Rate.**
- 2 Question: who is the current services provider? What is the contract pricing?
- Answer:** **The Current Service Provider is Corporate Image Maintenance Inc. The current Janitorial Services are billed at \$62,750.00/per month (8/1/21-12/31/21) and final month at \$66,250.00 (1/1/22-1/31/22) and \$17,900.00 for the Annual Floor Maintenance. Total Contract for the period of 8/1/21 through 1/31/22 is \$397,900.00.**
- 3 Question: How many full-time janitors are now at each plant?
- Answer:** **The current staffing level is 15 total janitors (10 Janitors, 3 detail porters and 2 Supervisors). There are one (1) Supervisor at each Plant and three (3) detail porters (two (2) at Plant 1 and one (1) at Plant 2) and 10 Janitors (between both Plants-Breakdown not available at current time). Proposers can propose alternate staffing levels to meet the requirements of the Scope of Work.**
- 4 Question: Full-time means 40 hours weekly?
- Answer:** **DIR considers Full-time employment to be 40 hours per week as defined in California Labor Code Section 515(c).**
- 5 Question: Can 29 hour schedules be accepted, (helping assure coverage)?
- Answer:** **Proposers can propose alternate staffing levels and hours other than full-time.**

- 6 Question: Are current staff safety-trained?
Answer: Yes
- 7 Question: How many OC people work at each plant?
Answer: OC San staff at Plant 1 is approximately 400 and at Plant 2 is 200.
- 8 Question: Any estimate of visitor counts?
Answer: Approximately 50 visitors per day for both plants combined.
- 9 Question: Will any remote staff be in-plant?
Answer: On average approximately 40% of the approximate 600 OC San Staff are working remotely on any given day (Monday-Friday). However, OC San plans to bring all staff back in plant as OC San Management/ CDC Regulations allow.
- 10 Question: Are there vaccination / mask / testing requirements?
Answer: Currently, there are only mask requirements. OC San continues to comply with the Cal-OSHA Covid-19 Emergency Temporary Standard as well as Federal, State and local public health guidance.
- 11 Question: Are there temperature or other checks done for each entry to either plant?
Answer: Currently No.
- 12 Question: Is there a current Janitorial service at work- What is the company name?
Answer: Yes, the Current Service Provider is Corporate Image Maintenance Inc.
- 13 Question: Is there any known CBA?
Answer: No
- 14 Question: Are you happy with current company?
Answer: Yes, they are providing a satisfactory service.
- 15 Question: Did you say in the meeting that there is assigned parking?
Answer: No

- 16 Question: Does the awarded company pay for their parking and badges?
Answer: No
- 17 Question: Are you happy with your current crew?
Answer: Yes
- 18 Question: The USMGI EMR is between 1.01 and 1.25. Exhibit I, page 2, requires "A completed Workers' Compensation Experience Rating Form (also referred to as an Experience Rating Worksheet)." There appears no such form in the RFP Or exhibits, apparently.
Answer: Please refer to Exhibit J, Safety Declaration of Contractor, Question #3
- 19 Question: Can a copy of the prevailing wage information shown in today's meeting be provided?
Answer: Please see answer to Question 1 above.
- 20 Question: What is the current monthly price for the janitorial services?
Answer: Please see answer to Question 2 above.
- 21 Question: Who is the incumbent and total value of current contract?
Answer: Please see answer to Question 2 above.
- 22 Question: How many employees are there at each of the locations?
Answer: Please see answer to Question 7 above.
- 23 Question: What is the total annual fees for the services based on the existing contract you have?
Answer: Please see answer to Question 2 above.
- 24 Question: What are last years or the year previous' bid results?
Answer: All the previous bid results and details can be viewed through Planetbids portal under Bid Specification No. S-2020-1189BD.
- 25 Question: Is there a dumpster area on site where we will be able to dump trash?
Answer: Yes

Darius Ghazi, C.P.M.
Contract, Purchasing & Materials Management

DEPARTMENT OF INDUSTRIAL RELATIONS
Office of the Director - Research Unit
455 Golden Gate Avenue, 9th Floor
San Francisco, CA 94102

MAILING ADDRESS:
P. O. Box 420603
San Francisco, CA 94142-0603



January 1, 2021

**IMPORTANT NOTICE
TO AWARING BODIES AND INTERESTED PARTIES REGARDING
THE PREVAILING WAGE RATES BELOW THE CALIFORNIA MINIMUM WAGE**

In accordance with Public Utilities Code Section 465(d), the Director of the Department of Industrial Relations is responsible for determining the prevailing wage rates for custodial or janitorial employees in accordance with the standards set forth in Section 1773 of the Labor Code. Under Labor Code Section 1773.9, the prevailing rate is defined as the basic hourly rate being paid to a majority of workers engaged in a particular craft, classification or type of work within the locality and in the nearest labor market.

Effective on January 1, 2021, the Director's prevailing wage determinations shall not be below the California minimum wage of \$14.00 per hour. Each employer is required to pay at least the California minimum wage, \$14.00, for the basic hourly rate in all cases where the published prevailing wage rate is below the California minimum wage. Any and all employer payments required by these determinations must also be paid.

If the California minimum wage is increased in the future to an amount above that shown in a prevailing wage determination, the basic hourly rate in that determination automatically increases to the new minimum wage.

GENERAL PREVAILING WAGE DETERMINATION MADE BY THE DIRECTOR OF INDUSTRIAL RELATIONS PURSUANT TO CALIFORNIA PUBLIC UTILITIES CODE, SECTIONS 465, 466 AND 467

Determination: ORA-2014-1
Issue Date of Determination: June 21, 2014

Reference: 22-1877-14
Supersedes Det: ORA-2008-1

Expiration Date of Determination: April 30, 2016* Effective until superseded by a new determination issued by the Director of Industrial Relations. Contact the Office of the Director – Research Unit at (415) 703-4774 for new rates after 10 days from the expiration date, if no subsequent determination is issued.

Locality: Orange County

Current Basic Hourly Rate:
\$14.00/Hr

Effective 1/1/2022 Basic Hourly Rate:
\$15.00/Hr

Craft: Janitor/Cleaner

Wage Rates: Classification
 Janitor

Basic Hourly Rate
\$10.85

Effective 5/1/2015
\$11.10

Employer Payments: (Public Utilities Code Section 465)

Health & Welfare: \$4.37 per hour worked after six (6) months of service.

Paid Holidays: Eight (8) holidays per year or \$0.33 per hour. (New Year's Day, Presidents' Day, Memorial Day, 4th of July, Labor Day, Thanksgiving Day, Day After Thanksgiving, and Christmas Day)

Paid Vacation: Five (5) days after 0-24 months of service or \$0.21 per hour; Ten (10) days after 25-84 months of service or \$0.42 per hour; Fifteen (15) days after 84 months of service or \$0.63 per hour

Paid Sick Leave: Four (4) days per year or \$0.17 per hour after one (1) year of service.

Training: \$0.03 per hour worked.

Others: \$0.06 per hour worked (LMCT).

Effective 5/1/2015:

Health & Welfare: \$4.47 per hour worked after six (6) months of service.

Paid Holidays: Eight (8) holidays per year or \$0.34 per hour. (New Year's Day, Presidents' Day, Memorial Day, 4th of July, Labor Day, Thanksgiving Day, Day After Thanksgiving, and Christmas Day)

Paid Vacation: Five (5) days after 0-24 months of service or \$0.21 per hour; Ten (10) days after 25-84 months of service or \$0.43 per hour; Fifteen (15) days after 84 months of service or \$0.64 per hour

Paid Sick Leave: Five (5) days per year or \$0.21 per hour worked after one (1) year of service.

Training: \$0.03 per hour worked.

Others: \$0.06 per hour worked (LMCT).

e. Bereavement Leave is two (2) days paid leave of absence for worker employed for at least 12 months and covers family members (mother, father, spouse, children).

Effective 5/1/2015 through present day: This is the current prevailing rate benefit payments required to be paid by the employer in addition to the Basic Hourly Rate

Recognized Holidays: New Year's Day, Presidents' Day, Memorial Day, 4th of July, Labor Day, Thanksgiving Day, Day After Thanksgiving, and Christmas Day. If a holiday falls on a Saturday, it shall be observed on the preceding Friday. If a holiday falls on a Sunday, it shall be observed on the following Monday.

Straight-time Hours: Eight (8) hours per day. Five (5) consecutive days a week.

Overtime Rate: One and one-half (1½) times the basic straight time hourly rate is paid for all hours worked in excess of eight (8) hours in any day or forty (40) hours in any week. One and one-half (1½) times the basic straight time hourly rate plus regular day's pay is paid for work on holidays.

Travel and Subsistence: In accordance with Labor Code Sections 1773.1 and 1773.9, contractors shall make travel and/or subsistence payments to each worker to execute the work. Travel and/or subsistence requirements for each craft, classification or type of worker may be obtained from the Prevailing Wage Unit at (415) 703-4774.

EXHIBIT A
SCOPE OF WORK/TECHNICAL SPECIFICATIONS
Janitorial & Floor Maintenance Service at Plants 1 & 2
SPECIFICATION NO. S-2021-1270BD

1. Summary

The Contractor shall provide Janitorial and Floor Maintenance Services at OC San Plant 1 Facilities, 10844 Ellis Avenue, Fountain Valley, California, and Plant 2 Facilities, 22212 Brookhurst Street, Huntington Beach, California. There are approximately 650 employees/Contract employees at OC San.

2. Project / Work Elements

The Contractor shall furnish all labor, materials, transportation, equipment and other services necessary to provide complete janitorial maintenance and stripping and waxing of floors in accordance with this Scope of Work. Janitorial maintenance Services shall be provided 7 days per week with night shift coverages within the process areas located at each plant location.

For this Contract, OC San requires the Contractor to provide Full-time janitors, Detail Porters, and Two (2) dedicated onsite Full-Time supervisors, one for each of the two (2) Plant locations.

The Contractor shall furnish the following supplies at no additional cost to OC San. OC San Does Not Track Janitorial Supplies Usage.

- Facial Tissue for restrooms
- Rolled Paper Towels or Multi Fold paper towels for kitchens
 - DublNature Multifold Towel Product # 48140 or equal
- Toilet paper (2-ply)
- Toilet Seat Protectors
- Waterless Urinal Cartridge (Falcon or equal – OC San to provide)
- Feminine Products (tampons and sanitary pads)
- All Waste Receptacle Liners
- 7 oz. Water Cups (all Water Cooler locations)
 - Solo Product # R7N or equal
- Sanitizing Wipes (all Water Cooler locations)
 - Sparoom Product # S03910-S or equal
- Tork Matic Hand Towel Roll Dispenser – with Intuition Sensor (Article 5511282)
 - Batteries for auto paper dispenser
- Tork Matic Advanced Matic hand towel roll 700 ft, 1 ply (Article 290089)

- Tork Foam Skincare Soap Dispenser (Article 571508)
- Tork Skincare Soap Refill (Article 401211)
- Stoko Kresto 87044 High Performance Hand Cleaner 2,000 ML Bottle Refills or equal
- Tork S4 Foam Skincare Automatic Hand Sanitizer Dispenser (Article 571600)
 - Batteries for battery operated Tork hand sanitizer dispensers
- Tork S4 Alcohol Foam Hand Sanitizer Refill (Article 400217)
- Stoko Refresh Foaming Instant Hand Sanitizer 1,000 ML Auto Dispenser Refills or equal
 - Batteries for battery operated Stoko hand sanitizer dispensers
- Contractor shall provide and install body wash/shampoo dispensers and provide refills for all showers.
- Shower curtains (semi-annually)

Dispensers shall be stocked at all times and shall be checked throughout the day to ensure adequate quantities are available. Contractor shall also check and replace the batteries for battery operated dispensers at no additional cost to OC San. Furthermore, the Contractor shall ensure that all supplied dispensers are operable and replace within 1 business day if necessary.

The Administration lobby, lobby restrooms, board and meeting rooms are areas of high usage during the entire day, and at times in the evening. Special attention is required to service these areas both at the start and at the end of each day, therefore the Contractor shall be required to provide coverage to work in the Administration Building at our Plant 1 facilities from 5:00 a.m. to 4:30 p.m., Monday through Friday. The lobby restrooms are to be cleaned/refreshed by no later than 4:30 p.m. on committee/board meeting evenings (every Wednesday and the 1st Thursday of each month) and the following mornings (prior to 6:00 a.m.) the committee/board room(s), lobby restrooms and kitchen are to be cleaned. In addition, the conference rooms and the lobby restrooms shall be cleaned, and supplies refilled immediately following public tours.

OC San operates twenty-four (24) hours per day, seven (7) days per week, and most areas will be occupied during the janitorial and floor cleaning Services. The janitorial staff shall be flexible and attentive to an area's special needs or special requirements. The janitorial staff shall not service the restrooms, kitchens, and break rooms during OC San lunch hours, and morning or afternoon breaks. OC San employees will make a reasonable effort to minimize use of an area while they are being cleaned and serviced.

The Contractor shall be aware of current meeting schedules and other work routines within the facility and conduct its work in such a manner as to cause minimal interference with the execution of OC San business or staff.

Contractor shall not be allowed to work on the following OC San observed Holidays:

- New Year's Day
- Lincoln's Birthday
- President's Day
- Memorial Day
- Independence Day
- Labor Day
- Veteran's Day
- Thanksgiving Day
- Day after Thanksgiving
- Day before Christmas
- Christmas Day

If a Holiday falls on a Saturday, it is observed the previous Friday. If the Holiday falls on a Sunday, it is observed the following Monday.

The following locations shall be cleaned and maintained in the following order and frequency. All equipment and materials shall be used per manufacturer's directions for each application. For additional detailed explanation of terms used in the Scope of Work to describe the work required in the following locations, see "Definition of Terms", Exhibit A, Section 5.0.

2.1 Locations

See Exhibits A-1, A-2, A-3 and A-4 for a detailed list of locations, square footage, stalls, urinals, showers, sinks, dispensers, refrigerators, microwave ovens, etc.

2.1.1 Restrooms and Restroom Entry Areas

All OC San **men's** restrooms shall be cleaned and maintained by male workers and all OC San **women's** restrooms shall be cleaned and maintained by female workers.

Water used in a mop bucket shall be discarded following each restroom cleaning.

2.1.1.1 Daily:

- Check, refill as necessary and clean all soap, toilet paper, paper towel, including feminine napkin dispensers (money from feminine product dispensers shall be collected and used by the Contractor for the cost of supplies).
- Check, refill as necessary OC San supplied hand sanitizer
- Empty, clean and disinfect (as needed) all trash receptacles and insert new liners

- Disinfect all washbasins (sinks), counters, and fixtures with non-abrasive disinfectant cleanser
 - Tile, grout and caulking shall be free of mold, mildew and stains
- Disinfect all door handles, light switches, handrails, and elevator push buttons
- Disinfect and clean inside and outside of urinals and toilets
- Disinfect toilet seats, fixtures and outside surfaces of urinals and toilets
- Clean all mirrors and mirror's chrome
- Clean stainless-steel fixtures
- Sweep entire restroom/entry area floors
- Damp mop entire restroom floor, including entry areas, with disinfectant

2.1.1.2 Weekly:

- Clean and polish all doors (including kick plates), door jambs (clean only), walls, toilet stall partitions (inside and out), mirrors, chrome, and stainless steel fixtures and remove any marks, stains or graffiti (polish subject to approval of OC San Representative)
- Pour a large bucket of fresh water down all floor drains

2.1.1.3 Monthly:

- Scrub resilient and hard surface floors (non-waxed surfaces) with appropriate cleaner
- Dust and remove cobwebs from light fixtures, skylights and openings
- Clean HVAC grilles, vents and registers
- Install OC San supplied Waterless Urinal Cartridge or as instructed by OC San
- Install monthly "Digester" flyer in holders above all urinals and inside all toilet stalls on the first working day of each month (OC San shall provide)

2.1.1.4 Quarterly:

- Spray buff resilient and hard surface floors
- Wash/scrub and disinfect wall tile and partitions

2.1.2 Showers, Shower Entry Areas and Locker Rooms

2.1.2.1 Daily:

- Check, refill as necessary and clean all soap, paper towel dispensers
- Check, refill as necessary OC San supplied sanitizer for dispensers.
- Empty, clean and disinfect (as needed) all trash receptacles and insert new liners
- Disinfect all door handles, light switches, and applicable handrails
- Dust mop/sweep entire floors
- Damp mop floors with disinfectant cleaner
- Dust and spot clean lockers and benches (Benches shall be left dry)
- Spot clean all doors, locker room walls, partitions, mirrors and other surfaces
- Clean shower drains of hair, soap and all other materials
- Scrub and disinfect with anti-fungal cleanser and de-scaler, all shower surfaces including doors, floors, mats associated with showers, baseboards, walls, shower stalls/partitions and fixtures so that all surfaces are free of mold, soap scum, body oils, mineral deposits, stains and odors
- Scrub shower entrances and walk ways with deck scrub brush and disinfectant cleanser

2.1.2.2 Weekly:

- Clean shower curtains so that all surfaces shall be free of soap scum, body oils, mold and mineral deposits

2.1.2.3 Monthly:

- Machine scrub resilient and hard surface floors with appropriate cleaner (non-waxed surfaces)
- Clean and disinfect exterior of all lockers. (Do not allow water to drip into lockers)
- Dust and remove cobwebs from light fixtures, skylights and openings
- Clean HVAC grilles, vents and registers

2.1.2.4 Quarterly:

- Spray buff resilient and hard surface floors (waxed areas only)

2.1.2.5 Semi Annually:

- Replacement of shower curtains

2.1.3 Entryways (exterior and interior), Lobbies, Hallways, Corridors, Traffic Areas and Stairs

2.1.3.1 Daily:

- Vacuum or sweep wiper/scrapper mats at entrances to buildings (interior and exterior)
- Dust mop/sweep hard surface floors then damp mop (Interior only)
- Empty and clean trash receptacles and replace liners
- Disinfect all door handles, light switches, and applicable handrails
- Damp wipe handrails outside building entrances (Non-process areas)
- Sweep outside entryways, decks, stairs, and stairway landings
- Immediately remove/spot clean spills from hard floor surfaces and carpet in accordance with Carpet and Rug Institute (CRI) directives and certified products

2.1.3.2 Weekly:

- Clean doors, door jambs, door glass, frames and kick plates
- Sweep and/or vacuum and damp mop interior stairways
- Vacuum all carpet

2.1.3.3 Monthly:

- Dust and remove cobwebs from light fixtures skylights and openings
- Wipe clean: partitions, walls, baseboards, counters, cabinets, trophy cases and all other horizontal (Accessible) surfaces (or as requested)

2.1.3.4 Quarterly:

- Remove cigarette butts and ashes from outdoor ashtrays (keep ashtrays & sand urns 20ft from building entrances)
 - Replenish sand as needed
- Spray buff resilient and hard surface floors

2.1.4 Offices, Cubicles, Meeting and Conference Rooms

2.1.4.1 Daily:

- Wipe down conference room tables with appropriate cleaner
- Sweep or dust mop and damp mop hard surface floors with appropriate cleaner
- Immediately remove debris/spot clean spills from floor surfaces and carpet
- Empty and clean trash receptacles (disinfect as needed) and replace liners
- Empty small, paper recycle receptacles (as needed) and place in 15-gallon paper recycle bins
- Empty paper shredder receptacles and place in designated, outside recycling dumpsters
- Disinfect all door handles, and light switches
- Arrange chairs in orderly fashion

2.1.4.2 Bi-Weekly:

- Empty 15-gallon paper recycle bins throughout Plants 1 & 2 into designated centrally located recycling dumpsters. Quantities and locations to be determined.
Bin sizes/quantities are subject to minor size and quantity changes.

2.1.4.3 Weekly:

- Vacuum all carpets
- Dust and spot clean doors, frames, walls, counters, windowsills, baseboards and partitions
- Clean doors, door jambs, door glass, frames and kick plates
- Clean workstation and partition glass/Plexiglas

2.1.4.4 Monthly:

- Dust all desks, tables, office furniture, chairs, partitions, tops of all cabinets and picture frames with a treated dust cloth. Do not move or disturb any paperwork or property
- Clean HVAC grilles, vents and registers

- Dust and remove cobwebs from light fixtures skylights and openings
- Vacuum fabric on upholstered furniture

2.1.4.5 Quarterly:

- Spray buff resilient and hard surface floors
- Clean window blinds and return to previous position (Do Not Disturb decorations on windows)

2.1.5 Lunchrooms, Kitchens, Break Rooms, Vending and Patio Areas

Lunch area/ eating area cleaning time - Lunch areas/ eating areas are to be cleaned at the end of OC San staff lunch period. Cleaning should NOT occur during OC San staff break times:

- **9:30am to 9:45am**
- **2:00pm to 2:15pm**

2.1.5.1 Daily:

- Check, refill as necessary and clean all soap, paper towel dispensers
- Check, refill as necessary OC San supplied sanitizer for dispensers.
- Empty and clean trash receptacles (disinfect as needed) and replace liners
- Sweep and/or dust mop then damp mop floors with appropriate cleaner
- Damp wipe tables and chairs with appropriate cleaner and replace in orderly fashion
- Clean and disinfect counter tops, sinks, exteriors of appliances and fixtures
- Spot clean doors, glass, door frames, walls, partitions, sills, and baseboards
- Disinfect all door handles and light switches
- Damp wipe interiors of microwave ovens with appropriate cleaner

2.1.5.2 Weekly:

- Vacuum all carpets
- Clean outside surfaces of all kitchen appliances, including but not limited to freezers, refrigerators, microwave and conventional ovens

- Clean interiors of microwave and conventional ovens

2.1.5.3 Monthly:

- Clean HVAC grilles, vents and registers
- Dust and remove cobwebs from light fixtures and skylights and openings
- Vacuum fabric on upholstered furniture
- Clean window blinds and return to previous position (Do Not Disturb decorations on windows)
- Clean interior of refrigerators and freezers (Post notice on front of refrigerator / freezer seven (7) days prior to cleaning)
 - Cleaning of certain refrigerators may occasionally be postponed

2.1.5.4 Quarterly:

- Spray buff resilient and hard surface floors

2.1.6 Elevators

2.1.6.1 Daily:

- Sweep then damp mop resilient floors with appropriate cleaner
- Immediately remove debris/spot clean spills from floors
- Disinfect elevator control panel push buttons
- Remove smudges, fingerprints and graffiti from walls, rails and doors

2.1.6.2 Weekly:

- Clean thresholds and door tracks of dirt and debris
- Polish all chrome and stainless steel
- Vacuum carpet
- Spot clean carpeted floors

2.1.6.3 Monthly:

- Dust and remove cobwebs from light fixtures

2.1.6.4 Quarterly:

- Spray buff resilient and hard surface floors

2.1.7 Fuel Station Plant 1

2.1.7.1 Daily:

- Pick up litter and sweep when necessary
- Empty trash containers and insert new liners

2.1.8 Plant 1 and Plant 2 Cart Barn

2.1.8.1 Weekly:

- Contractor is responsible for sweeping the area
- Empty trash cans and replace with new liners

2.1.9 Other Services

2.1.9.1 Daily:

- Contractor is responsible to supply 7 oz. cups at all water cooler locations and re-fill supply as necessary
- Contractor is responsible to supply sanitizing alcohol wipes at all water cooler locations and re-fill supply as necessary
- Clean water coolers with damp, disinfectant cloth, including trays (no chemicals shall be used)

2.1.9.2 As Needed:

- Provide water extractor response for water spills / leaks
- Plunge plugged or backed-up toilets, urinals and sinks when observed or requested (disinfect before returning to service). If unsuccessful, Contractor shall notify the OC San Representative

Toilet Plunger shall never be used on sinks

- Wet wipe surfaces to remove ants (no chemicals shall be used) when observed or requested
- Deep cleaning of offices/cubicles upon personnel moves (OC San Representative will provide the Contractor with a list of offices that will require deep cleaning).
- Contractor shall notify the OC San Representative of any items needing repair, including but not limited to:
 - Leaks

- Broken fixtures
- Roof leaks
- Clean up small, biohazard (blood) spills. Contact OC San Representative for disposal. Biohazard (blood) spill cleanup kits and their disposal shall be provided by OC San.

2.1.10 Floor Coverings

Floor coverings vary in each building. They may include, but are not limited to; carpet, vinyl, VCT, terrazzo, concrete, and ceramic tile. The Contractor shall be responsible for performing the prescribed and appropriate cleaning and polishing method for each type of floor covering. Special attention shall be given to reduce the generation of dust while sweeping concrete surfaces. The use of a sweeping compound for this surface is encouraged.

2.1.10.1 Carpeted Floors and Floor Mats

- Vacuum the entire carpeted area, including under chairs, tables and other easily moved items, and around furniture legs. Return moved items to their original position. Pick up staples and other hard to remove items by hand if necessary. Vacuum hard to reach areas such as behind desks and furniture as needed. The carpet shall be free of visible dirt, litter, and soil.
- Inspect carpet for new spots and stains from spills and remove spots and stains immediately. Remove spots and stains with an appropriate industrial grade spot removing solution using the manufacturer's recommended techniques. Report any tears, burns or unraveling to OC San representative. Carpet cleaning and shampooing is not part of this Contract.

2.1.10.2 Resilient and Hard Surface Floors

- Put out wet floor warning signs (at all affected entrances) while work is in progress and until floor is dry
- All resilient and hard surface floors shall be swept then damp mopped daily
- Inspect floors for new spots and stains from spills and remove immediately
- Chairs, trash containers, and other easily movable items shall be moved, cleaned underneath and placed back in an orderly fashion
- Upon completion, the entire surface shall be free of litter, soil, dust, hair, stains, streaks, film, standing water, and splash marks

- Spray buff floors quarterly with floor machine and an all-cotton-buffing pad
- Dust and damp mop floor then apply a thin film of spray polish then buff while moist to remove black marks, scuffs, stains, and scratches
- Dust mop the floor when spray buffing is completed

2.1.10.3 Annual Floor Maintenance (stripping & waxing of floors)

Shall not be performed during normal work hours

The following work is to be performed on all resilient and hard surface floors (excluding concrete) once every year:

- Contractor shall only be paid upon approval by OC San Representative or his / her designee; and after all annual floor maintenance service has been completed to the satisfaction of the OC San Representative.
- Contractor shall provide a work schedule one month prior to the start of the annual floor maintenance as well as a 2-week notice as conformation to advise staff of impending work scheduled for their work location.
- Contractor shall meet with OC San staff at least three days prior, on-site to arrange specific work times and work areas.
- Stripping and waxing of floors shall not be scheduled during normal work hours. Contractor shall sign in at the Control / Operations Center then contact the Operations Supervisor to inform him / her about the work location(s) and the need to unlock or provide access to any secured locations. Contractor shall be responsible to sign out (log out of the facility) upon completion of work just prior to leaving the facility.
- Contractor shall place “NO ADMITTANCE” signs at all entrance and exits to work areas. The signage shall show the times that the floors will be reopened for use.
- Minimum procedures shall consist of stripping entire floor including corners and edges until all waxes, sealers and cleaning agents are removed. Rinse floor until clean and then dry. Inspect floor to be sure all wax, sealant, dirt, cleaning agents and stains are removed. Baseboards, furniture legs, door bottoms, and corners should be cleaned as well as the floor.

Strippers shall be non-ammoniated

- Apply a minimum of three coats of wax and high speed buff the final coat. Floor finish shall be clear in color, with no streaks or lint, and resist dirt and soil.
 - **The Contractor is responsible to move small furniture, tables, chairs, chair mats, carts, and trashcans out of the work location to be stripped, waxed, and returned to their original position upon the completion of the job.**
 - ***NOTE: Failure to perform the Annual Floor Maintenance in accordance with the above required specifications may result in the termination of the Contract, in whole or in part.***

3. Additional Disinfecting Tasks

3.1 Dedicated staff identifiable through blue vest shall have the following daily tasks, including nights and weekends (reference section 5.15 for specific hours):

3.1.1 Disinfection through the use of electrostatic sprayer on all commonly touched surfaces, such as light switches, elevator buttons, stairway rails, refrigerator handles, microwaves, door handles, and common area tables and counter tops.

3.1.2 Surfaces shall be wiped of debris prior to spraying.

4. Resources Available

4.1 Power

OC San shall provide the Contractor and their subcontractors, free of charge during the term of this Contract, 120 volts, 60-hertz, maximum 20 ampere electrical service. All other utilities shall be provided by the Contractor at its sole expense.

4.2 Water

OC San shall furnish to the Contractor, free of charge, during the course of the Contract, city (potable water).

5. Project Management

5.1 Equipment & Facilities Inspection

OC San reserves the right to inspect and evaluate the suitability of all proposed equipment and Proposer's facilities that shall be used to perform Services in accordance with the Scope of Work.

5.2 Qualification and Training of Employees

- Contractor shall submit, prior to the commencement of work under this contract, a complete list of all employees assigned to work under this Contract.

- OC San may require the dismissal of employee(s) OC San has determined to be incompetent, careless or otherwise objectionable to the public interest.
- When in the opinion of OC San, an employee does not perform satisfactorily; their employment on this Contract shall be denied.
- All of the Contractor's employees shall be required to wear a company uniform, identifying the Contractor and the employee's name. No shorts are allowed.
- Contractor shall notify OC San's Representative or designee immediately in writing of any change in contract personnel by submitting the name, and effective date of termination of the employee and employment date of the replacement employee.
- Contractor shall have an on-site training program (on a monthly basis at a minimum) during the duration of this Contract and it shall include, but not be limited to the following:
 - General Cleaning
 - How to perform each task
 - Hard floor maintenance
 - Safety Training
 - Proper handling and dispensing of chemicals
 - Hazard communication
 - QA/QC issues
 - Customer Service issues
 - Contractor shall provide up to date documentation that its staff has been trained in the above whenever requested by OC San.
- The on-site training program is to provide the Contractor's personnel the training required for the thorough understanding and ability to demonstrate proficiency in effectively cleaning the items mentioned in this scope of work. In addition, the personnel shall meet ISSA Cleaning Industry Training Standard (CITS), Cleaning Management Institute (CMI) or another industry recognized standard.

5.3 Workmanship, Materials & Equipment

- 5.3.1** The Contractor shall consistently furnish a high quality and level of labor, materials and equipment for satisfactory Contract performance. OC San reserves the right to reject any cleaner, supplies or equipment that does not meet its needs or performs at an unacceptable level of cleanliness or quality. OC San shall not bear any additional costs if any or all restroom or cleaning supplies are deemed unacceptable for OC San use, and upgrades are required.

5.3.2 Prior to the start of the Contract, OC San may request samples of supplies or products in order to evaluate the acceptability for use at OC San facilities.

5.3.3 Vacuum Cleaners shall:

- have the Carpet and Rug Institute (CRI) Seal of Approval (SOA) and shall meet the gold or silver performance standard
- be certified for commercial use
- have a rotating cylindrical brush, not a beater bar

5.3.4 When not specifically identified in the specifications, such materials and equipment shall be of suitable type and grade for that purpose. Each item or article shall be subject to inspection and / or test and approved by the OC San Representative or Representative when so required. All workmanship shall be subject to the inspection and approval of the OC San Representative or designee.

5.3.5 All necessary cleaning equipment including power driven, floor scrubbing, waxing and polishing machines, industrial-type vacuum cleaners, etc., that is needed to perform the work on this Contract, shall be furnished by the Contractor. Such equipment shall be of the size and type customarily used in work similar to this Contract and shall meet the approval of the OC San Representative or designee.

Equipment deemed by the OC San Representative or designee to be of improper type or inadequate for the purpose intended shall be replaced at no additional cost to OC San.

5.3.6 Contractor shall be responsible for maintenance and repair of its supplies and equipment such as vacuum cleaners, mops, brooms, notification signage, bicycles, carts, etc.

5.4 Changes

OC San may at any time, by giving fifteen (15) days written notice, delete or add to the Scope of Work as set forth in these specifications.

A change in the Contract amount may be amended or waived through the purchase order process.

5.5 Supervisory Staff

5.5.1 The Contractor shall provide two (2) dedicated onsite Full-Time Supervisors (Monday – Friday) for on-site supervision of its employees (Janitors and Detail Porters) performing the Contract work. One (1) Supervisor at the Fountain Valley location and One (1) Supervisor at the Huntington Beach location.

5.5.2 The Contractor shall provide the work schedule of the janitorial staff to the OC San Representative or designee.

- 5.5.3** The Supervisors shall be available at all times during the day while the Contract work is in progress to respond to instructions from the OC San Representative or designee regarding janitorial issues that need immediate attention.
- 5.5.4** The Contractor Supervisors shall be equipped with a cell phone and the number provided to OC San Representatives.
- Supervisors shall respond immediately after being contacted by voice or text message.
- 5.5.5** The Contractor's Supervisors shall be fully experienced and adequately trained in both cleaning and supervision and shall meet the approval of the OC San Representative or designee.
- 5.5.6** Contractor's Supervisors shall be required to perform daily Inspections (QA/QC) of all buildings serviced under this Contract.
- 5.5.7** The Supervisors shall be able to communicate in English, both orally and in writing.
- 5.5.8** In the absence of the Supervisor(s), Contractor shall notify OC San in advance or as soon as possible of Supervisor's absence and provide OC San with name and cell phone number of substitutes.
- Substitute shall be able to communicate in English, both orally and in writing
- 5.5.9** Contractor's employees shall not be accompanied in their work area by acquaintances, family members or any other person unless said person is an authorized employee of the Contractor.

5.6 Non-Supervisory Staff

- 5.6.1** The Contractor shall provide Ten (10) Full-Time Janitors and Three (3) Full-Time Detail Porters to perform the contract work at the Fountain Valley and Huntington Beach locations.
- The Ten (10) Full-Time Janitors shall perform mainly the daily work tasks and other work tasks as directed by his/her Supervisor.
 - The Three (3) Full-Time Detail Porters shall perform mainly the weekly, bi-weekly, monthly, quarterly work tasks and other work tasks as directed by his/her Supervisor. The Detail Porters shall ensure that the detailed work as listed (in the Scope of Work) but not limited to the weekly, bi-weekly, monthly, quarterly work tasks are satisfactorily completed in a high quality and professional standard.

5.7 Inspection of Premises

- 5.7.1** The Contractor Supervisors shall be required to sign all "Verification of Services Performed Log" (supplied by OC San) on a daily basis by the end of each workday. This log is to be used daily to document all work completed. The logs shall be

submitted to OC San Representative(s) at the end of each week. SEE Exhibit A-5 for a sample of the "Verification of Services Performance Log".

- 5.7.2 The Contractor Supervisors shall be responsible on a daily basis to inspect and rate the level of services performed by his/her staff on the "Verification of Services Performed Log".
- 5.7.3 The Contractor Supervisors shall be required to perform on-site physical Inspection (QA/QC) for the satisfactory completion of the Janitorial services (based on the timeline) as prescribed in the Scope of Work to be completed on a daily, weekly, bi-weekly, monthly, quarterly basis. On-site inspections are to ensure scope of work compliance. The Contractor Supervisors shall inspect based on the timeline as prescribed in the Scope of Work. Work discovered as unsatisfactory during the inspections shall be discussed/relayed to the Contractor Janitor(s)/ Detail Porter(s) and request the service to be corrected and not to re-occur. Repeated under performance/poor quality service by the Janitor(s) or Detail Porter(s) shall be cause for the removal and replacement of the Janitor/ Detail Porter. When in the opinion of OC San, a Supervisor does not perform satisfactorily in their inspection and corrective process; their employment on this contract shall be denied and the Supervisor shall be replaced immediately.
- 5.7.4 The Contractor shall submit a monthly invoice per Exhibit B. The Contractor's monthly invoice shall not be submitted prior to the last week of each month and shall not be approved for payment until the OC San Representative or designee rate the overall performance of the Contractor as "satisfactory".
- 5.7.5 The Contractor's on-site Supervisor(s) shall also accompany the OC San Representative on scheduled and non-scheduled inspection tours of the buildings and sites when requested by OC San.

5.8 Safety, Equipment Protection & Damage

- 5.8.1 The Contractor shall be responsible for the protection of all existing equipment and facilities and shall, at its own expense, repair or restore any damage caused by the actions or negligence of its employees, within a 24-hour period. **If the Contractor fails or refuses to make such repairs or restorations, OC San may have the work performed and deduct the repair cost from the monthly invoice.**
- 5.8.2 All Contractor employees shall receive blood-borne pathogen training annually and the Contractor shall have training records available upon request.
- 5.8.3 OC San's Risk Management Division must approve all chemicals used. All chemicals shall have proper identifying labels affixed to them as well as secondary containers (i.e., spray bottles). Any chemical used in performing the contract work shall have the appropriate Material Safety Data Sheet (MSDS) in a labeled safety binder in each area / closet in which they are stored.
- 5.8.4 Contractor's staff shall comply with any and all safety requirements and don all personal protective equipment as called out by the instructions on the chemical labels.

5.8.5 Copies of all MSDS sheets for each building shall be supplied to OC San at the start of the contract as well as during the duration of the contract prior to the introduction of any additional materials.

- Failure to comply shall result in the immediate removal of said product(s) / Chemical(s) by the Contractor.
- Liquid soap shall be non-alcohol based.

5.9 Storage Space

OC San will assign a limited amount of secured storage space if available in buildings for the storage of the Contractor's supplies and equipment. Contractor shall keep this space in a neat and orderly condition. Contractor shall keep electrical panels, fire extinguishers, interior access doors and water heater areas clear of materials and supplies. OC San shall not be responsible for damage or loss to the Contractor's stored supplies, equipment or personal belongings. **Materials in large volumes (5 gallons or more) shall not be stored on OC San property. No flammable materials shall be brought on-site.**

5.10 Conduct of Work

5.10.1 The Contractor shall prohibit its employees from disturbing papers on desks, opening desk drawers and cabinets, using telephones, radio equipment, and any other equipment provided for official OC San use.

5.10.2 No OC San equipment shall be unplugged without OC San's prior approval.

5.11 Security

5.11.1 Electronic identification badges shall be issued to all janitorial staff by OC San.

5.11.2 All exiting doors are to remain closed and locked. Do not prop open exiting doors for any reason. Do not assist entry to anyone. Close and lock all exterior windows. When Janitorial staff gains entrance to a locked room / office, they shall lock the room / office upon exiting.

5.12 Energy Conservation

Contractor shall instruct all employees performing janitorial work within the facility to utilize energy conserving work methods, which shall maximize energy conservation. If they turn on the lights to clean, they shall turn off the lights when finished. Janitorial Staff shall turn off lights upon exiting an unoccupied room.

5.13 Cleaning Quality Requirements/Expectations

5.13.1 Services performed under this contract shall be subject to inspection and approval of the Contractor Supervisors and the final approval of OC San's Representative or designee. Consistent, first quality cleaning shall be required.

5.13.2 Unsatisfactory work shall be called to the attention of the Contractor Supervisors at the discretion of OC San's Representative(s) and the Contractor shall be

required to correct the work deficiencies within one (1) hour to the satisfaction of OC San's Representative or designee.

5.13.3 Contractor shall respond to the work site within one (1) hour should unsatisfactory work causes an emergency condition as determined by OC San. Failure by the Contractor to comply with such requests will force OC San to use any means necessary to correct the problem. Associated costs shall be deducted from the monthly invoice. Repeated failures to respond may be cause for the termination of the contract.

5.13.4 Notification of unsatisfactory work shall be deemed given as soon as OC San leaves a Voicemail, text or E-mail message, notifying the Contractor Supervisor(s) or Management of deficient performance. Contractor shall provide telephone, Email address, and cell phone numbers for this purpose, and shall provide a 24-hour telephone number for emergencies and shall respond within 30 minutes with a return phone call.

5.14 Cleaning Schedule(s)

Contractor shall furnish OC San's Representative or designee with a routine work schedule(s) of all cleaning tasks that are not performed on a daily basis. The Contractor shall provide this schedule(s) to OC San not later than 30 days after contract is awarded.

5.15 Work Hours and Locations of Services

The majority of the janitorial work shall be performed between the hours of 6:00 A.M. and 4:30 P.M, Monday through Friday. OC San will also require the Contractor to perform Janitorial services for the Operational areas (as indicated in Exhibit A-5) on Saturday and Sunday between the hours of 6:00 A.M. and 4:30 P.M. In addition to the daily day-time Janitorial services, the Contractor shall also perform evening/Night shift services between the hours of 4:30 P.M. through 9:30 P.M. Monday through Sunday for the specified Operational areas (as indicated in Exhibit A-5). A list of building locations and servicing hours are noted in Exhibit A-5.

5.16 Exceptions:

5.16.1 Administration Building-Plant 1

- Contractor shall be required to provide coverage to work from 5:00 a.m. to 4:30 p.m. Routine weekday services shall be provided Monday through Friday.
- Lobby restrooms are to be cleaned/refreshed by no later than 4:30 p.m. on Committee / Board meeting evenings (every Wednesday and the 1st Thursday of each month). On the mornings following meeting nights, prior to 6:00 a.m., the Committee / Board room(s), lobby restrooms and kitchen are to be cleaned.
- Contractor shall have the staff flexibility to also provide requested services for cleanup and housekeeping during special events (typically a few hours per event) that may occur five (5) to ten (10) times per year at no additional cost to OC San (Mondays through Saturdays).

5.16.2 Annual Floor Maintenance (stripping and waxing of floors)

Shall not be scheduled during normal work hours

5.16.3 Recyclable Materials

The Contractor shall be required to deposit all recyclable paper, cans, and all other recyclables in the appropriate containers for that facility.

5.16.4 Minimum Staffing, Breaks and Extraordinary Services

- **The Contractor shall provide no less than the minimum number of staff to meet the requirements of this Scope of Work and to the satisfaction of the OC San Representative.**

For this Contract, OC San requires the Contractor to provide a total of Ten (10) Full-time janitors, Three (3) Detail Porters and Two (2) Full-Time supervisors; one for each of the two (2) Plant locations.

- Contractor may be required to re-clean areas that were already cleaned due to accidents, spills, etc. This occurs infrequently. Cost shall be included in this contract.
- Contractor may be required to re-disinfect areas that were already disinfected. This may occur occasionally. Cost shall be included in this contract.
- Contractor's staff shall take regular, pre-determined breaks (break times shall be agreed upon by Contractor and OC San Representative).
- Contractor's staff shall not take breaks in janitor closets/rooms
 - OC San shall notify Contractor of areas that its staff can use for breaks. Such areas are subject to change.
- Contractor's staff shall perform duties during entire shift with the exception of regularly scheduled breaks
- Contractor's staff shall not use personal communication devices during work time.
- OC San shall compensate four (4) hours of pay in the event one of Contractor's employee's reports for work as scheduled but is denied work without any prior notification.
- Should a Contractor employee fail to report to work or go on vacation, the Contractor shall provide a substitute person to cover that person's cleaning responsibilities by the start of the second workday.
- **OC San shall be the sole judge of any performance discrepancies.**

6. Definition of Terms

The following definitions apply unless otherwise noted:

OC San: Shall mean the Orange County Sanitation District

OC San Representative/Project Manager: Shall mean the OC San employee who is the main point of contact for all issues related to this Contract.

Daily: Shall mean once per day, Monday through Friday, excluding Holidays

Weekly: Shall mean once per week

Monthly: Shall mean once per calendar month

Quarterly: Shall mean once per every three months

Annual: Shall mean once per year (contract year)

As Needed: Shall be determined by OC San Representative

Ceramic Tile Sealer: Apply protective sealer finish that adds luster but does not build up

Clean: Remove all dirt, mold, mildew, grime, stains and marks with approved cleaner and applicator

Damp Mop: Remove all surface dirt and stains with a mop and warm water containing detergent or floor cleaner as required; and rinse

Damp Wipe: Remove all surface dirt with a damp cloth

Deep Cleaning: extensive and thorough cleaning including but not limited to scrubbing, vacuuming, wiping, dusting, and disinfecting surface areas.

Disinfect: Clean with a disinfecting agent

Dust: Remove all loose dirt and debris. Treated cloths shall be used.

Dust Mop: Use an all-cotton push mop sprayed with a chemical dust attractant to remove all dirt and debris

Hi-Speed Buffing: Hi-speed buffing machine shall be used to apply protective sheen on wax floors where specified.

Scrub: Remove all dirt, stains and marks with an approved cleaner using a floor machine equipped with scrubbing pads

Signage: "Caution, Warning, No Admittance, Wet Floor, Closed, Slippery" etc. signs

Spray-Buff: Use floor machine equipped with an all-cotton bonnet-polishing pad. Apply solution and buff until dry.

Strip: Remove accumulations of old floor finish, all surface dirt, stains and marks. Rinse and dry.

Sweep: Remove all dirt, debris, and litter with a broom

Vacuum: Remove all surface and embedded dirt with a high efficiency filter suction cleaner with cylindrical brush.

Wax: Apply appropriate number of coats of approved floor finish

Appendix A-1
AREAS REQUIRING JANITORIAL SERVICES AT PLANTS 1 & 2
For
Janitorial & Floor Maintenance Service at Plants 1 & 2

Appendix A-1

AREAS REQUIRING JANITORIAL SERVICES AT PLANTS 1 & 2

A. PLANT 1

1. **MAIN GUARD SHACK** -restroom and office
2. **WASTE HAULER DUMP STATION-** restroom and office
(DO NOT CLEAN SINKS AND COUNTERS IN LAB)
3. **M&D BUILDING** - restroom and control room
4. **ADMINISTRATION BUILDING** -restrooms, offices, cubicles, kitchens, conference rooms
5. **ENVIRONMENTAL LAB** – offices, cubicles, kitchen, restrooms, conference rooms,
West Mechanical Room **(DO NOT CLEAN SINKS AND COUNTERS IN LABS)**
6. **HUMAN RESOURCES BUILDING** – offices, cubicles, kitchen, restrooms, conference room
7. **FLEET SERVICES** – offices, lunchroom, kitchen, restroom, locker room
8. **PURCHASING/ WAREHOUSE BLDGS** – offices, cubicles, restrooms, conference rooms, kitchenette
9. **BUILDINGS 5 & 6** – offices, cubicles, restrooms, locker rooms, kitchen, shop lunch areas, kitchen,
break room
10. **BUILDING A** – offices, cubicles, break rooms, restroom/locker rooms, shop areas
11. **BUILDING B** – office, computer room, break room, kitchen, locker room
12. **CONTROL CENTER & CART BARN** – offices, cubicles, conference rooms, kitchens,
restrooms/locker rooms, sweep floor and trashcan liner replacement for cart barn
13. **CENTRAL GENERATION BLDG** – offices, cubicles, break rooms, restrooms (not the engine area)
14. **BLOWER BUILDING 1** – control room, restroom
15. **THICKENING & DEWATERING FACILITY** - control room, lobby, locker room, restrooms, shower,
break room, laboratory
16. **SOLIDS STORAGE AND TRUCKLOADING FACILITY** – control room, restroom
17. **DAF THICKENERS** - restrooms, control room, lab room, offices
18. **ENGINEERING TRAILERS (A, B, E & F)** – offices, cubicles, conference rooms, kitchen, restrooms


19. **POWER BUILDING 3A FLOOR – ANNUAL FLOOR WAXING (ONE TIME PER YEAR)**
NO OTHER MTCE. REQUIRED
20. **DIGESTER CONTROL ROOM – ANNUAL FLOOR WAXING**
(ONE TIME PER YEAR) and trashcan liner replacement
21. **P1-37 RESTROOM** – Rooftop of Primary Clarifier restroom
22. **PLANT WATER STATION – ANNUAL FLOOR WAXING**
(ONE TIME PER YEAR) NO OTHER MTCE. REQUIRED
23. **POWER BUILDING 6 – ANNUAL FLOOR WAXING**
(ONE TIME PER YEAR) NO OTHER MTCE. REQUIRED
24. **RAS PUMP STATION LAB** – floor and trash can
25. **BLOWER BUILDING 2** – entry, hall, control room, restroom, sampling room
26. **GARFIELD PORTABLE GUARD SHACK** – office
27. **POWER BUILDING 4 – ANNUAL FLOOR WAXING**
(ONE TIME PER YEAR) NO OTHER MTCE. REQUIRED

B. **PLANT 2**

1. **MAINTENANCE BUILDING** - offices, cubicles, conference rooms, kitchen, restrooms/locker rooms, shop areas
2. **OPERATIONS CENTER & CART BARN** - offices, cubicles, conference rooms, kitchen, restrooms/locker rooms, gym, sweep floor and trashcan liner replacement for cart barn
3. **WAREHOUSE** – offices, cubicles, restrooms, kitchenette
4. **CENTRAL GENERATION/OOBS** – offices, cubicles, break rooms, restrooms/locker rooms, kitchen, (not the engine area)
5. **ENGINEERING/CONSTRUCTION MANAGEMENT TRAILERS** - offices, cubicles, conference rooms, kitchens, restrooms
6. **SAFETY TRAILERS** - offices, cubicles, conference rooms, kitchens, restrooms
7. **P2 MAIN ENTRANCE GUARD SHACK** – restroom and office
8. **SOLIDS STORAGE & TRUCKLOADING FACILITY** – control room, restroom, office
9. **WEST RAS** – office
10. **EAST RAS** – office and restroom
11. **PDF BUILDING** – two restrooms
12. **OXYGEN BUILDING** – hallway, control room & restroom

13. **CENTRIFUGE BUILDING** - control room, restrooms, break area
14. **FINAL SAMPLER BUILDING** - floors and trash can
15. **DISTRIBUTION CENTER H** – restroom and control room
16. **DISTRIBUTION CENTER J** – restroom and Lab
17. **BUSHARD PORTABLE GUARD SHACK** – office
18. **BANNING PORTABLE GUARD SHACK** – office
19. **DAFT BUILDING** – restroom, single stall

Appendix A-2
JANITORIAL SERVICE AREA MAPS
For
Janitorial & Floor Maintenance Service at Plants 1 & 2

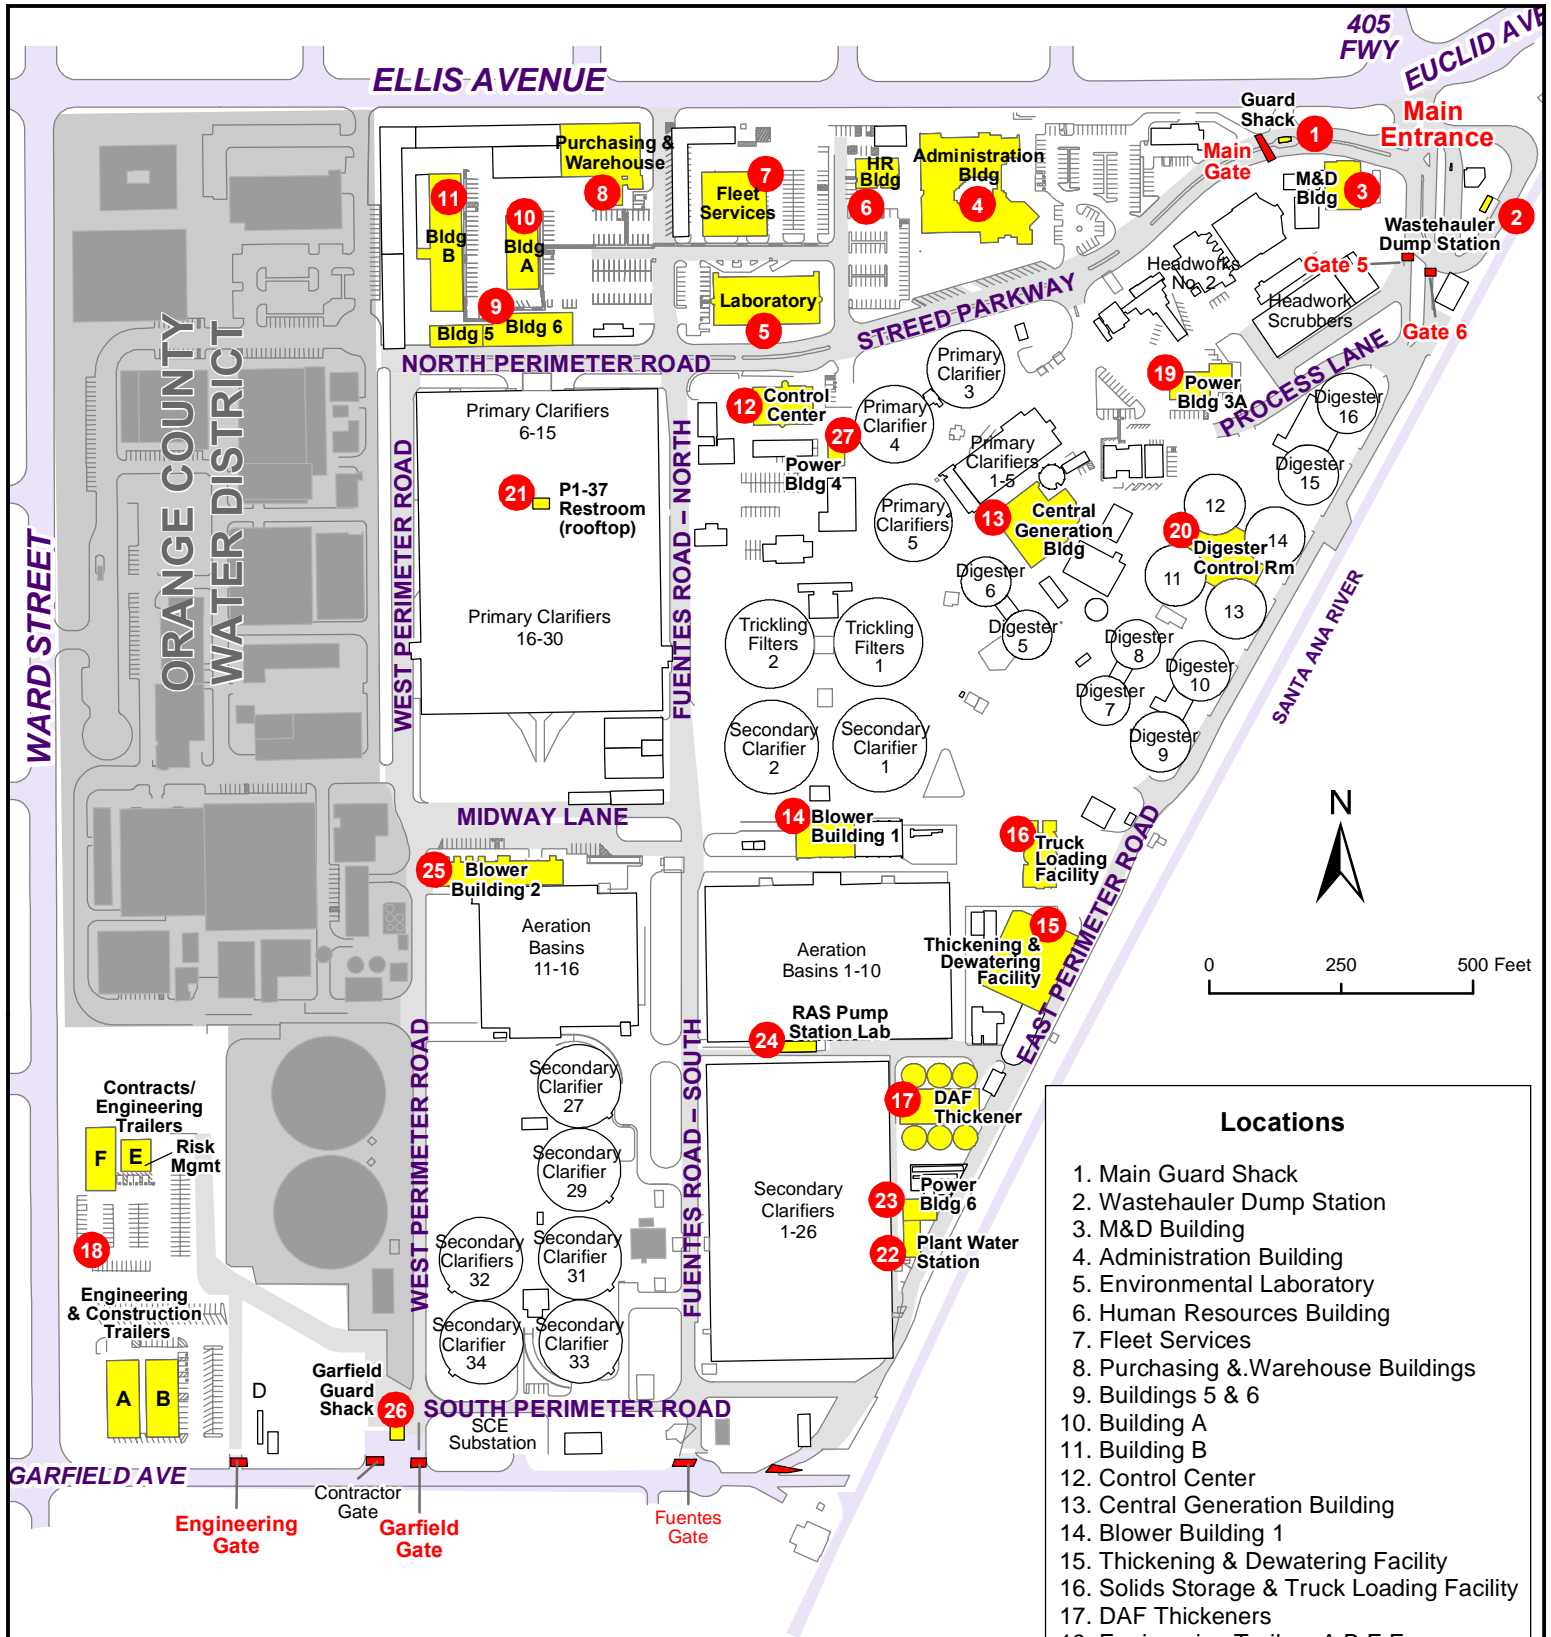


- Locations**
1. Main Guard Shack
 2. Wastehauler Dump Station
 3. M&D Building
 4. Administration Building
 5. Environmental Laboratory
 6. Human Resources Building
 7. Fleet Services
 8. Purchasing & Warehouse Buildings
 9. Buildings 5 & 6
 10. Building A
 11. Building B
 12. Control Center
 13. Central Generation Building
 14. Blower Building 1
 15. Thickening & Dewatering Facility
 16. Solids Storage & Truck Loading Facility
 17. DAF Thickeners
 18. Engineering Trailers A,B,E,F
 19. Power Building 3A
 20. Digester Control Room
 21. P1-37 Restroom (Rooftop of Primary Clarifiers)
 22. Plant Water Station
 23. Power Building 6
 24. RAS Pump Station Lab
 25. Blower Building 2
 26. Garfield Portable Guard Shack
 27. Power Building 4



Janitorial Service Locations

Reclamation Plant No. 1

10844 Ellis Avenue, Fountain Valley, CA 92708

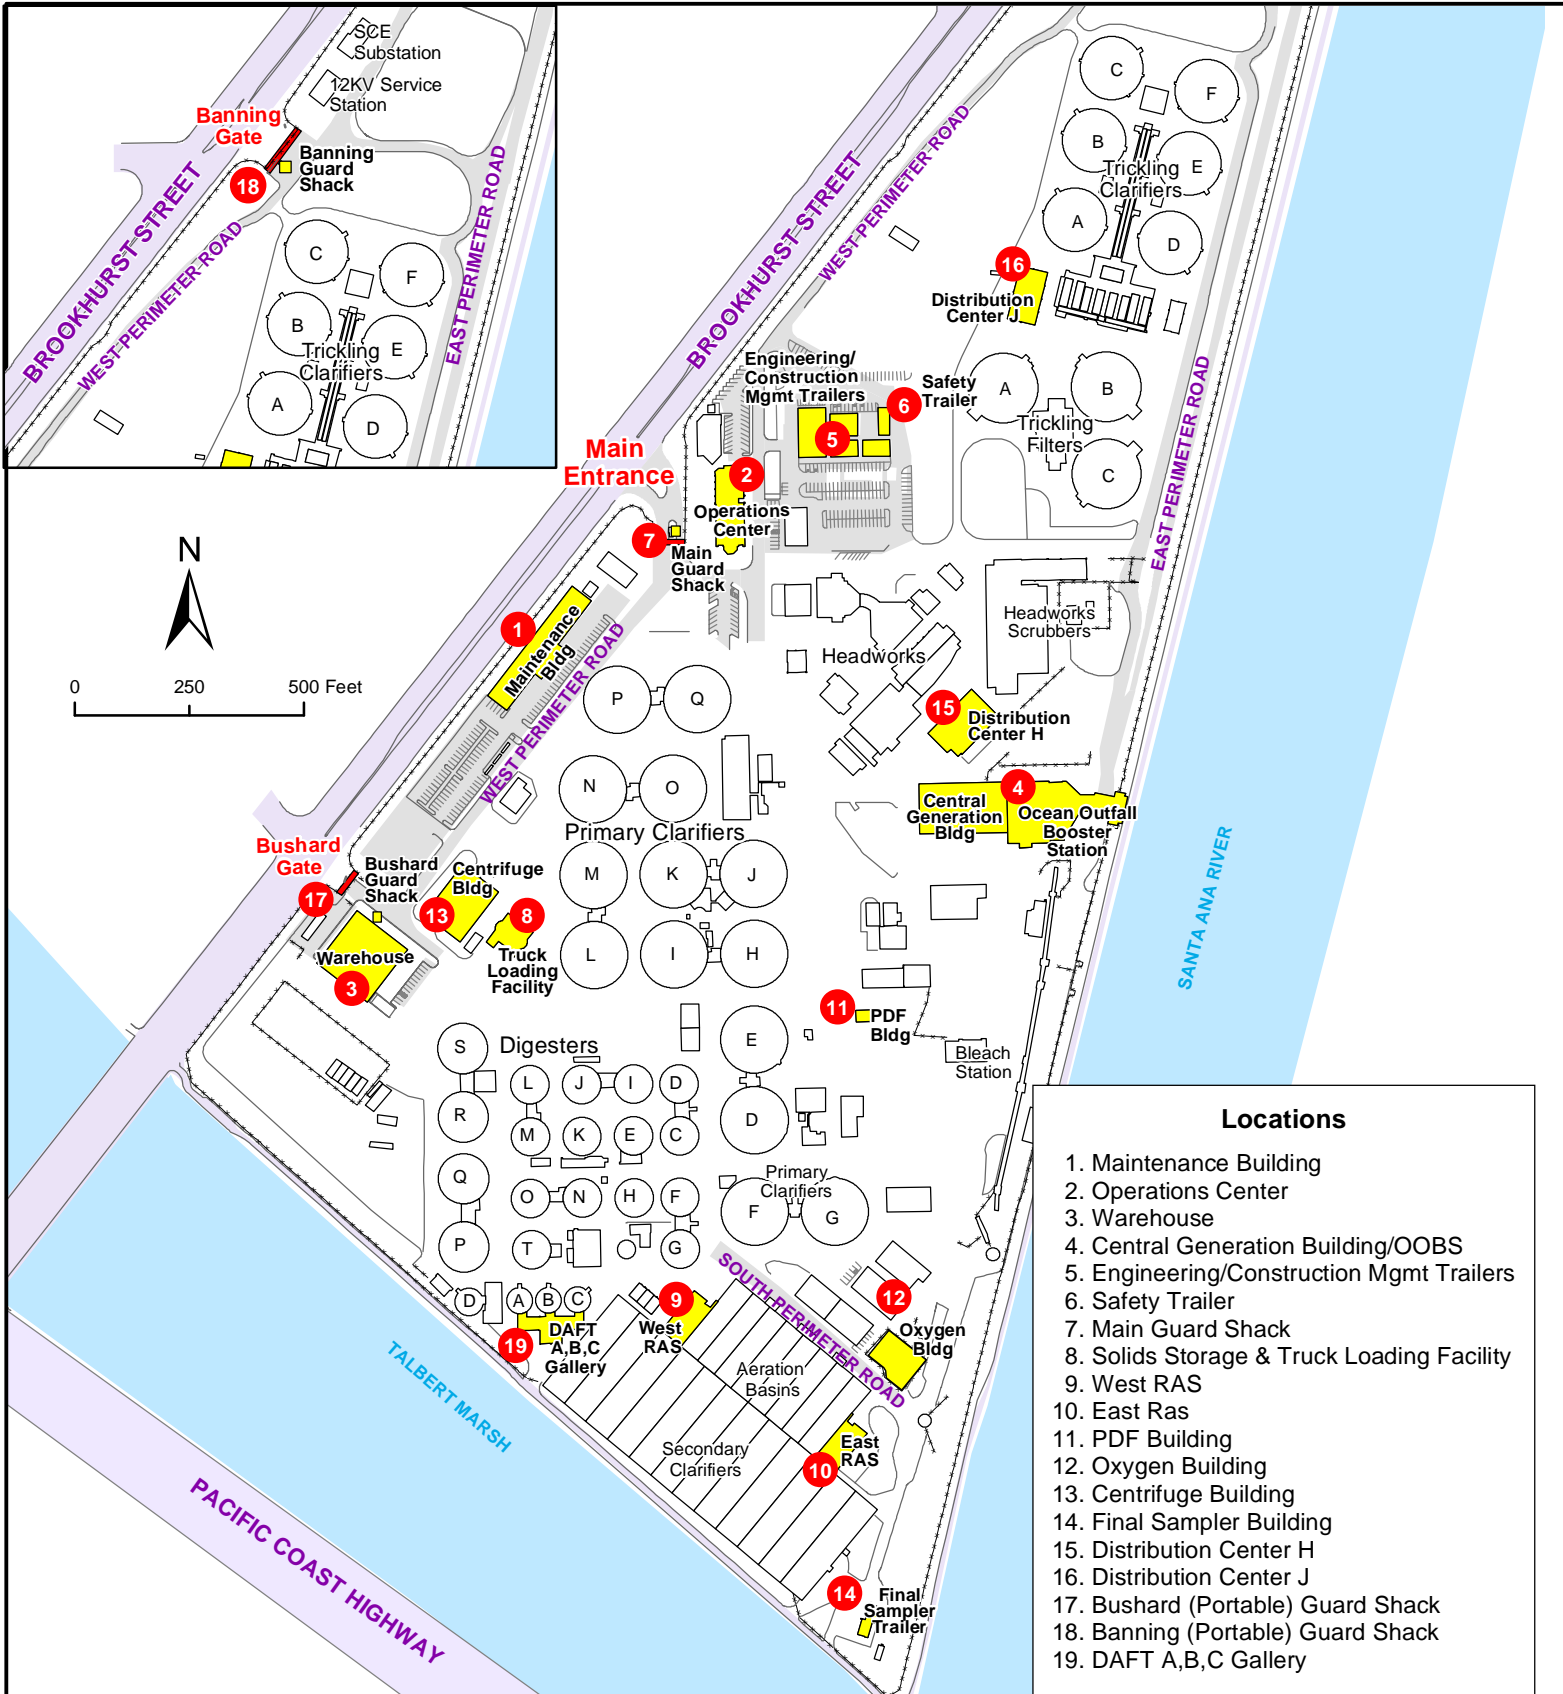

Revision 8/5/21



Janitorial Service Locations


Treatment Plant No. 2

22212 Brookhurst Street, Huntington Beach, CA 92646

Appendix A-3
JANITORIAL SERVICE FLOOR PLANS
For
Janitorial & Floor Maintenance Service at Plants 1 & 2

ADMINISTRATION BUILDING - NORTH FIRST FLOOR

LOOP TAG NUMBER 19BROOM _____

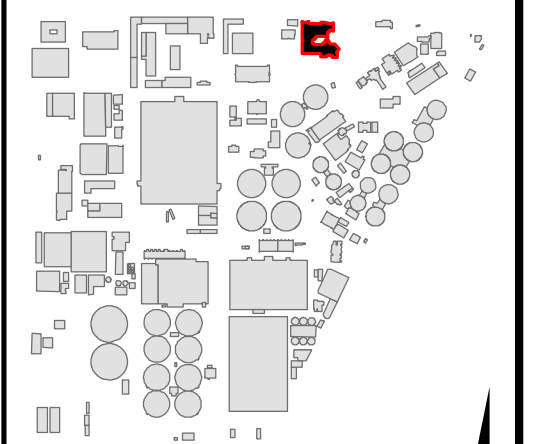

KEY MAP
NTS

DIVISION

- 120
- 210
- 220
- 250
- 710
- 740
- Water Dispenser
- USB Scanning Station
- Fire Extinguisher
- First Aid Kit

ADDITIONS OR REVISIONS TO THIS FLOOR PLAN SHOULD BE MARKED UP AND RETURNED TO DIVISION 250 - ENTERPRISE INFORMATION MANAGEMENT. EGIS@OCSD.COM




ORANGE COUNTY
SANITATION DISTRICT

19BSTRC001

ADMINISTRATION BUILDING - SOUTH FIRST FLOOR

LOOP TAG NUMBER 19BROOM_____

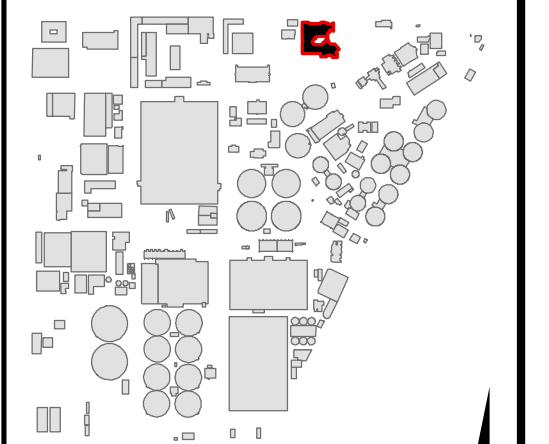

KEY MAP
NTS

DIVISION

- 110, 120, 140
- AED
- Fire Extinguisher
- First Aid Kit
- Pull Station
- Water Dispenser

ADDITIONS OR REVISIONS TO THIS FLOOR PLAN SHOULD BE MARKED UP AND RETURNED TO DIVISION 250 - ENTERPRISE INFORMATION MANAGEMENT. EGIS@OCSD.COM




ORANGE COUNTY
SANITATION DISTRICT

19BSTRC001


ADMINISTRATION BUILDING SECOND FLOOR

LOOP TAG NUMBER 19BROOM_____

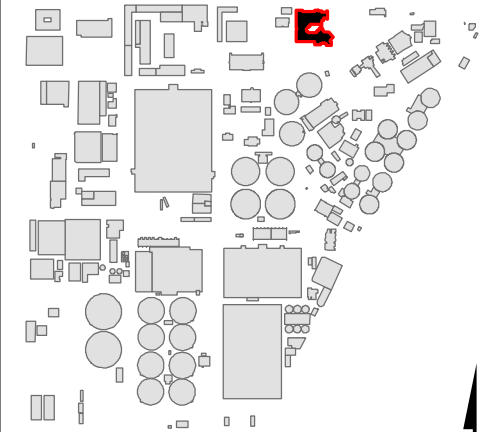

KEY MAP
NTS

N

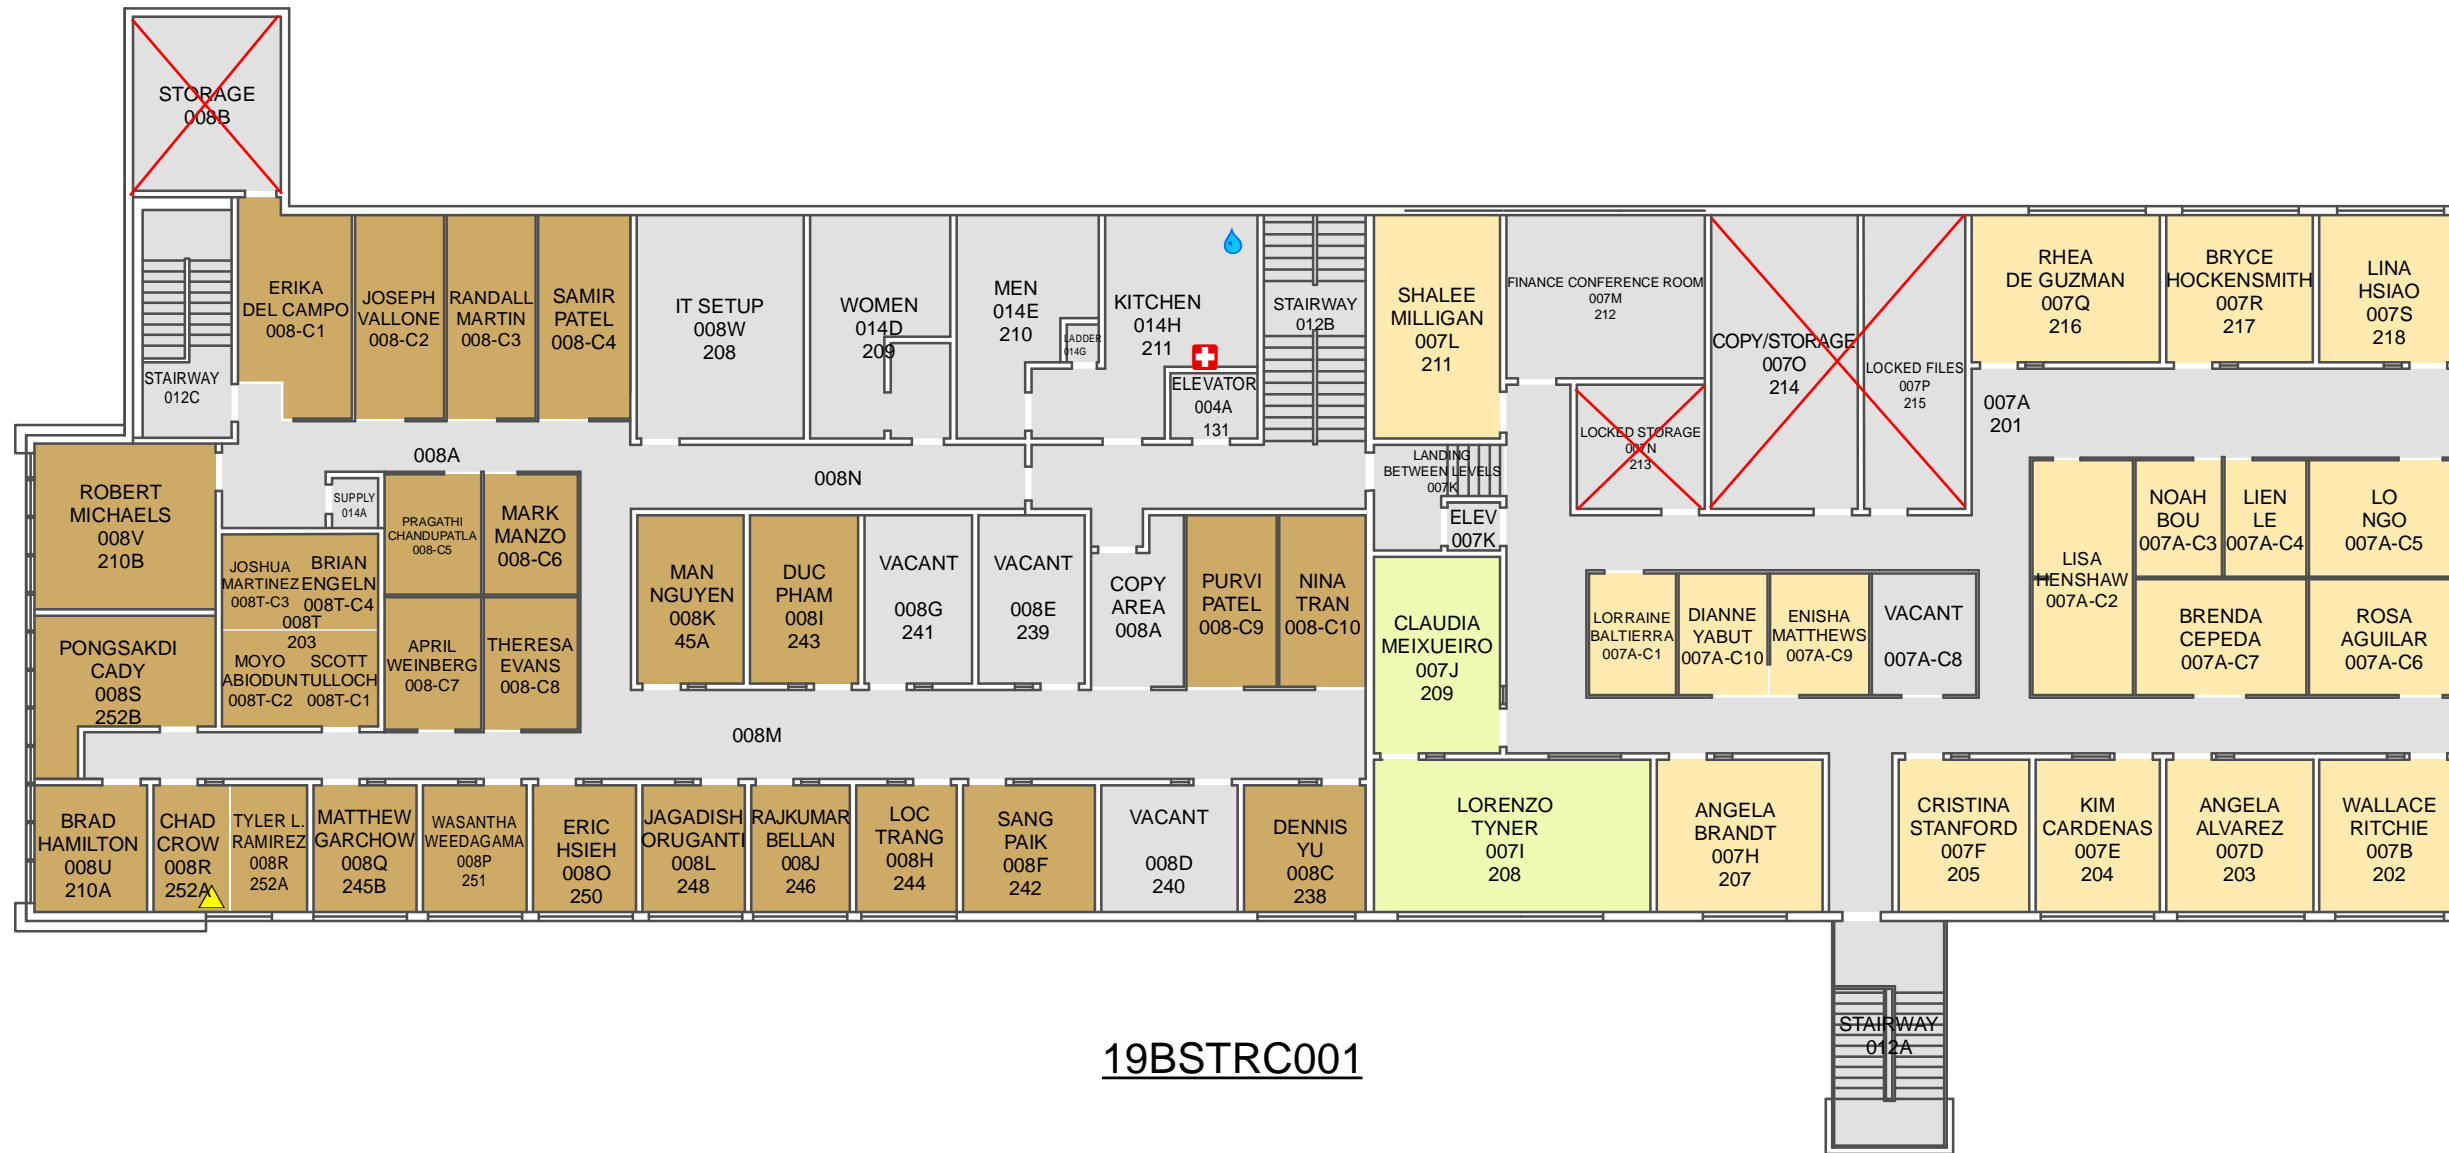

19BSTRC001

DIVISION

- 210
- 220
- 250

- Fire Extinguisher
- + First Aid Kit
- Water Dispenser
- USB Scanning Station

ADDITIONS OR REVISIONS TO THIS FLOOR PLAN SHOULD BE MARKED UP AND RETURNED TO DIVISION 250 - ENTERPRISE INFORMATION MANAGEMENT. EGIS@OCS.D.COM





ORANGE COUNTY
SANITATION DISTRICT



BUILDING 5 - FIRST FLOOR

LOOP TAG NUMBER 19RROOM_____

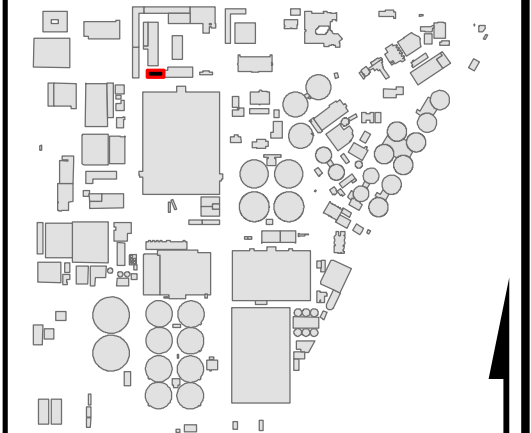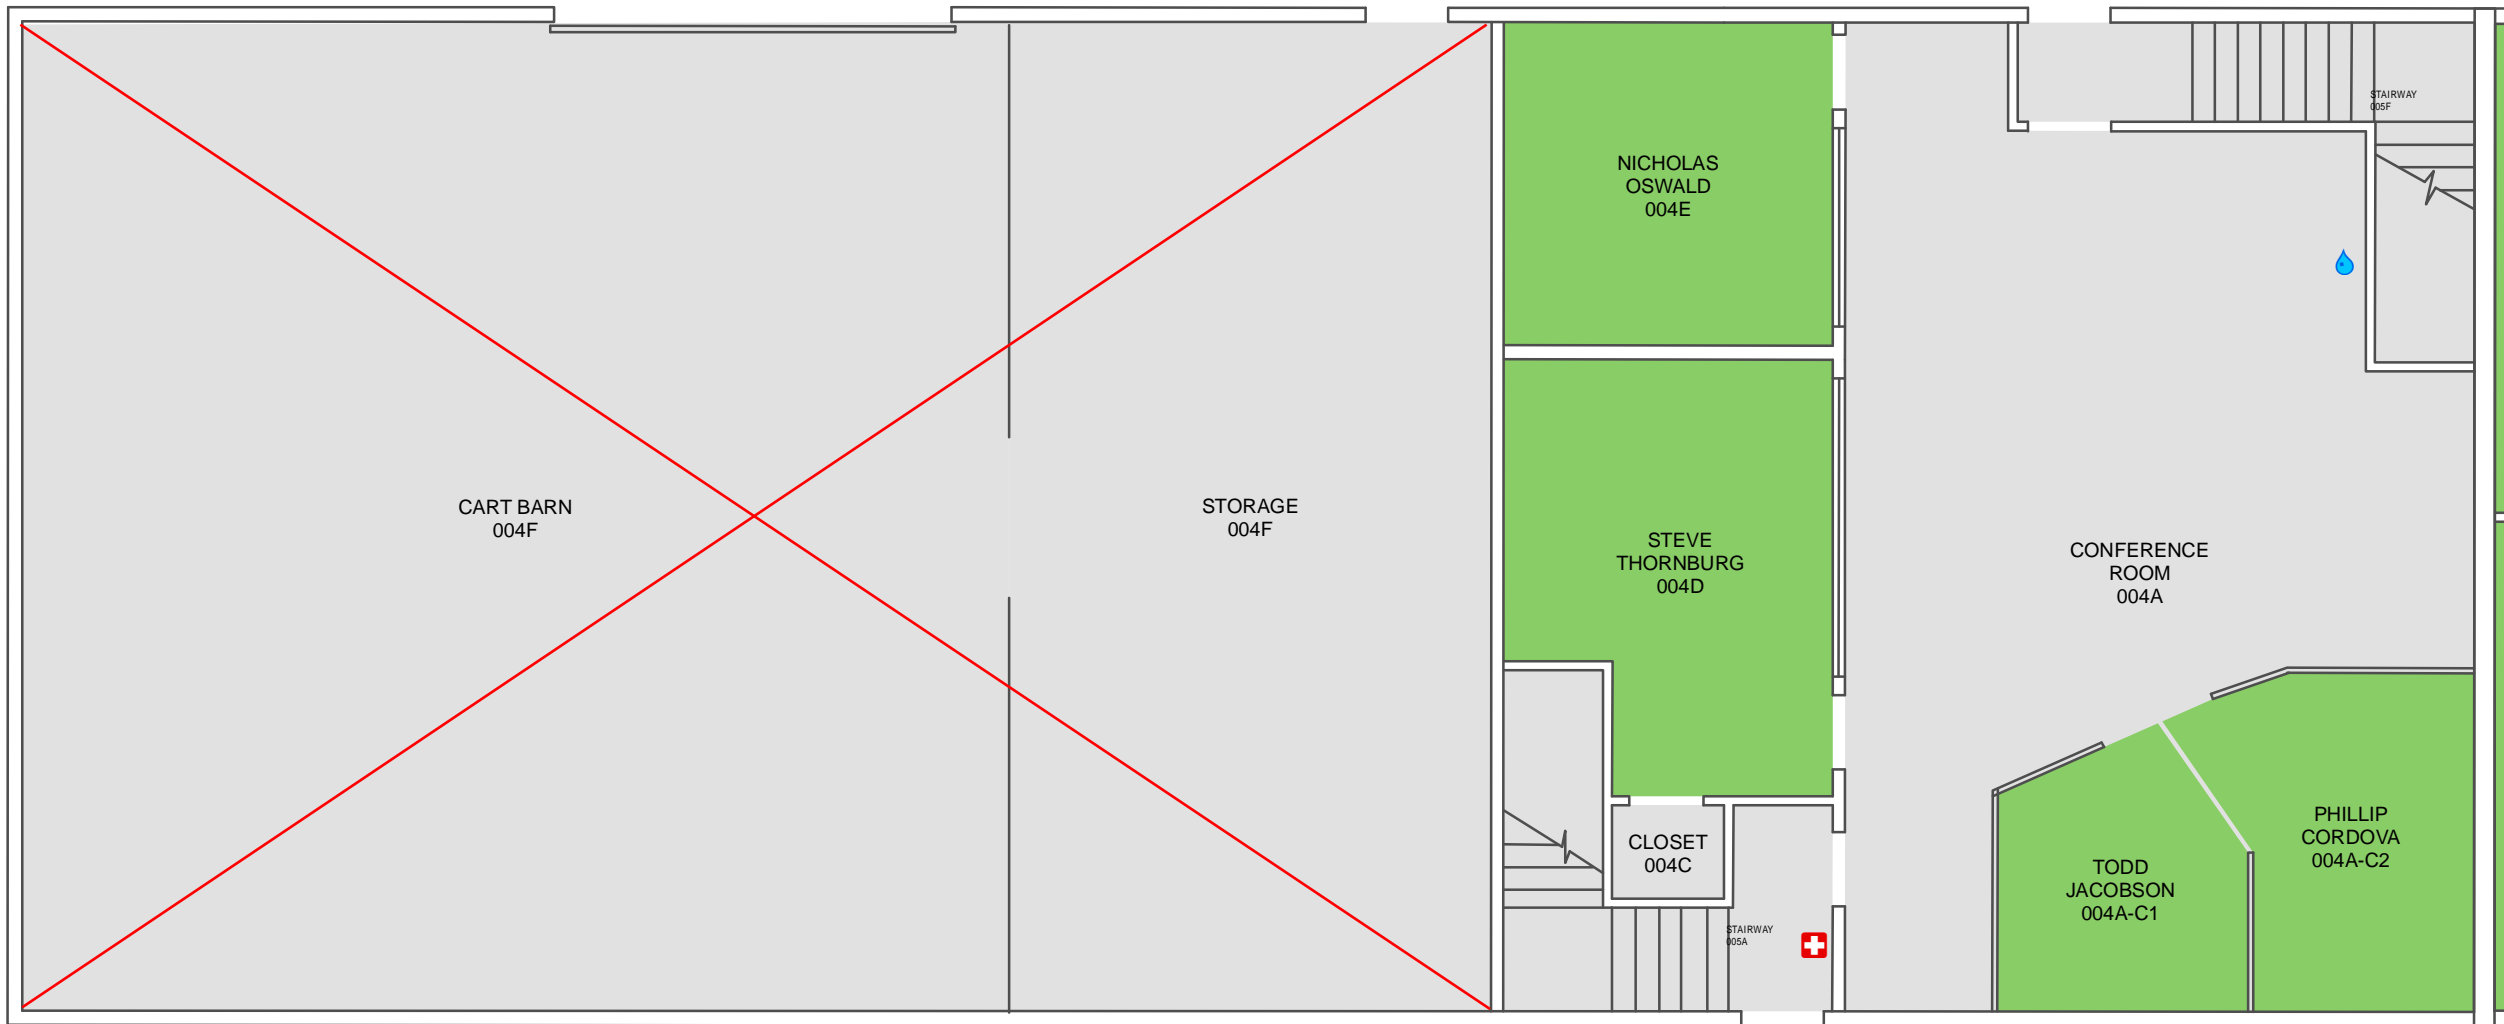

KEY MAP
NTS

DIVISION

- 870
- Water Dispenser
- Fire Extinguisher
- First Aid Kit
- Pull Station


ADDITIONS OR REVISIONS TO THIS FLOOR PLAN SHOULD BE MARKED UP AND RETURNED TO DIVISION 250 - ENTERPRISE INFORMATION MANAGEMENT. EGIS@OCSD.COM



ORANGE COUNTY
SANITATION DISTRICT

BUILDING 5 - SECOND FLOOR

LOOP TAG NUMBER 19RROOM_____

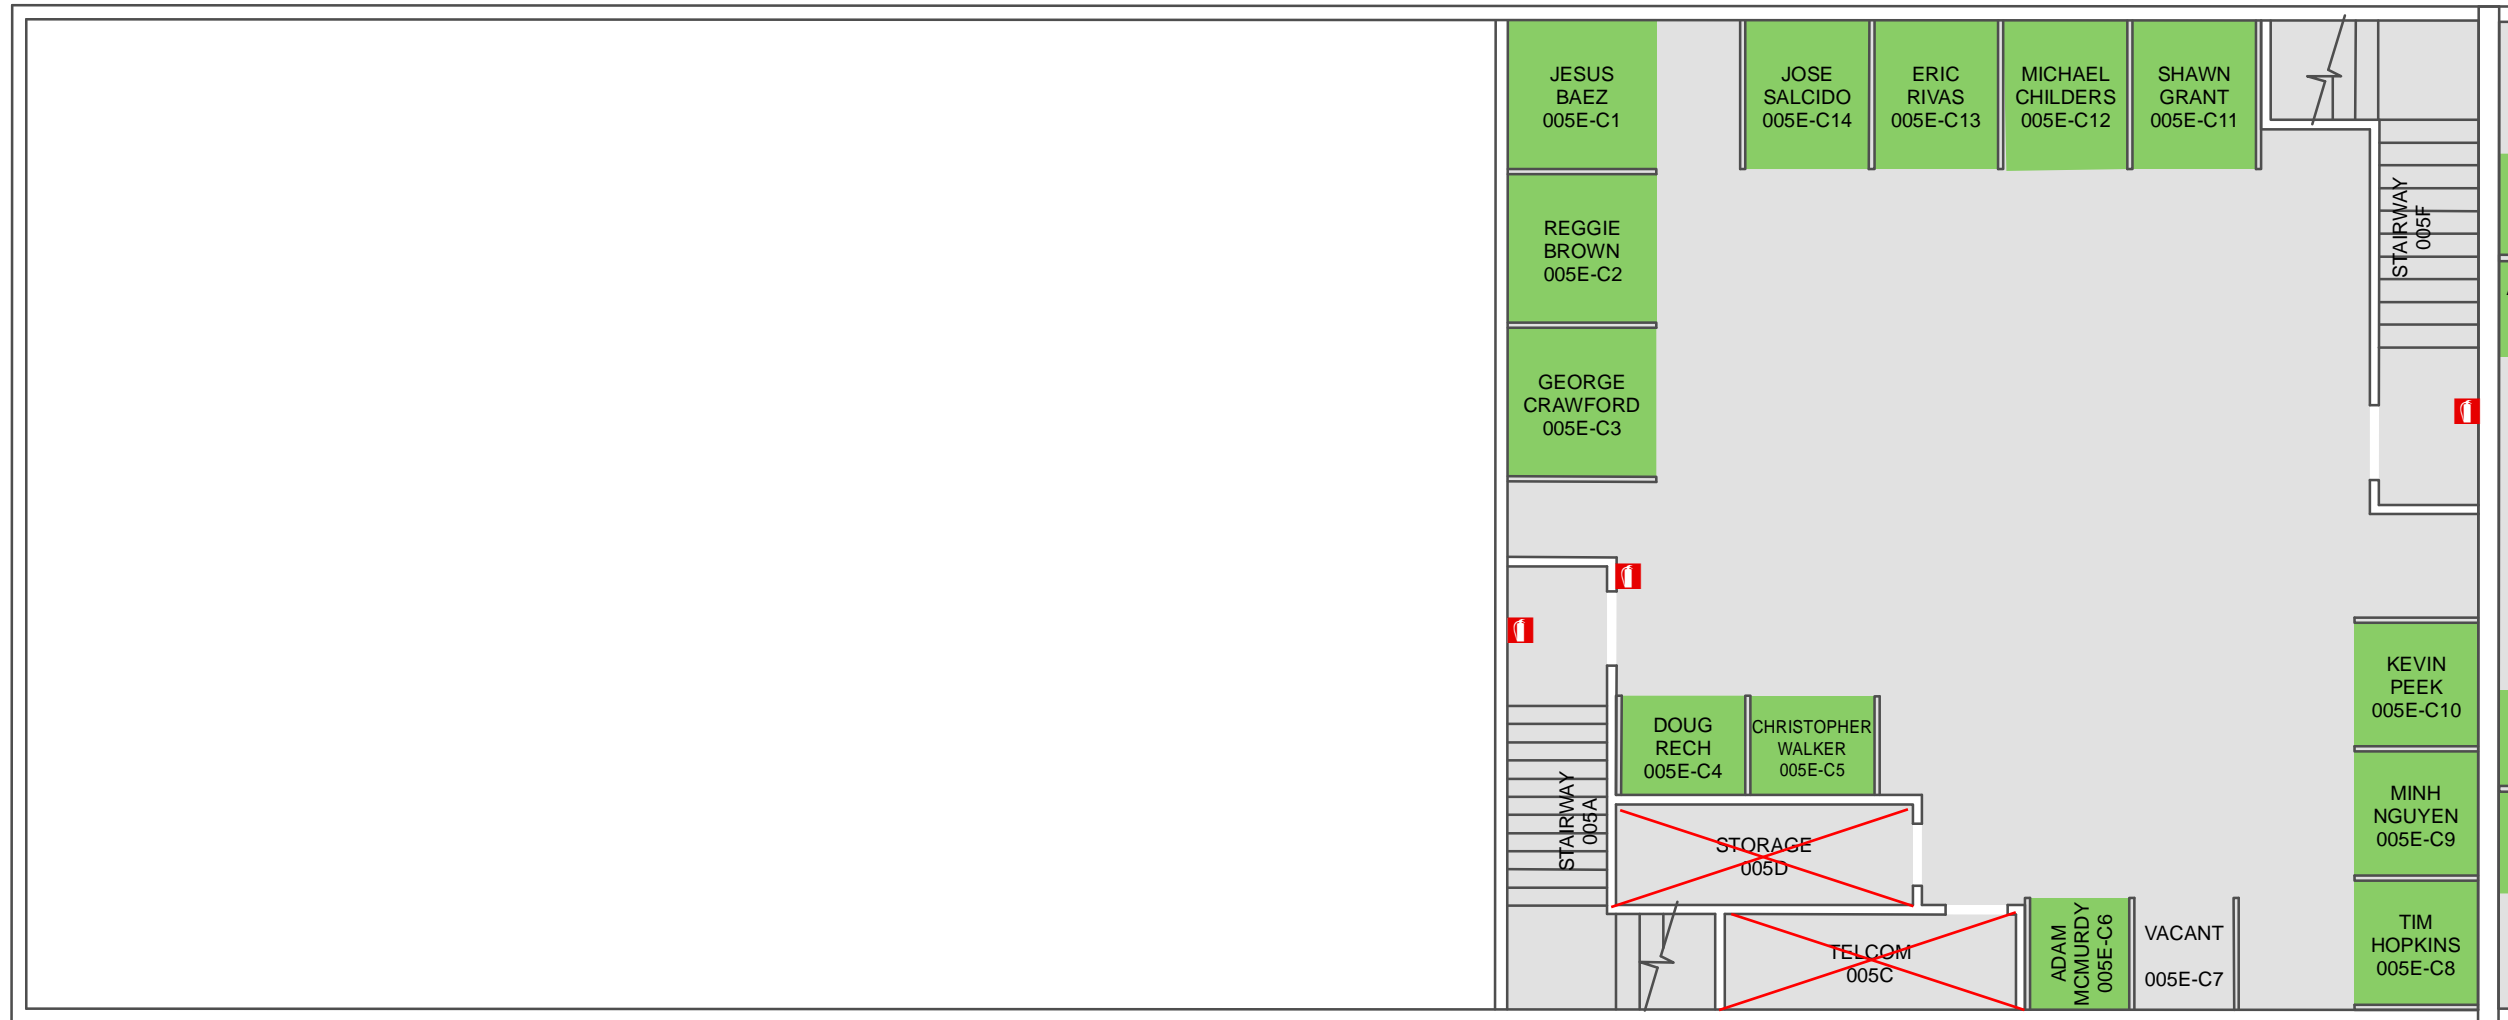

KEY MAP
NTS

DIVISION

- 870
- Fire Extinguisher
- P Pull Station



19RSTRC002

ADDITIONS OR REVISIONS TO THIS FLOOR PLAN SHOULD BE MARKED UP AND RETURNED TO DIVISION 250 - ENTERPRISE INFORMATION MANAGEMENT. EGIS@OCSD.COM



BUILDING 6 - FIRST FLOOR

LOOP TAG NUMBER 19RROOM_____

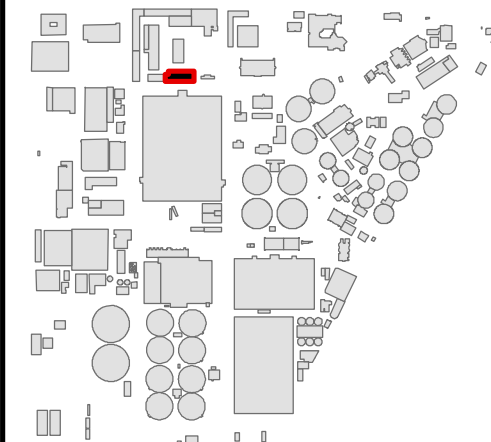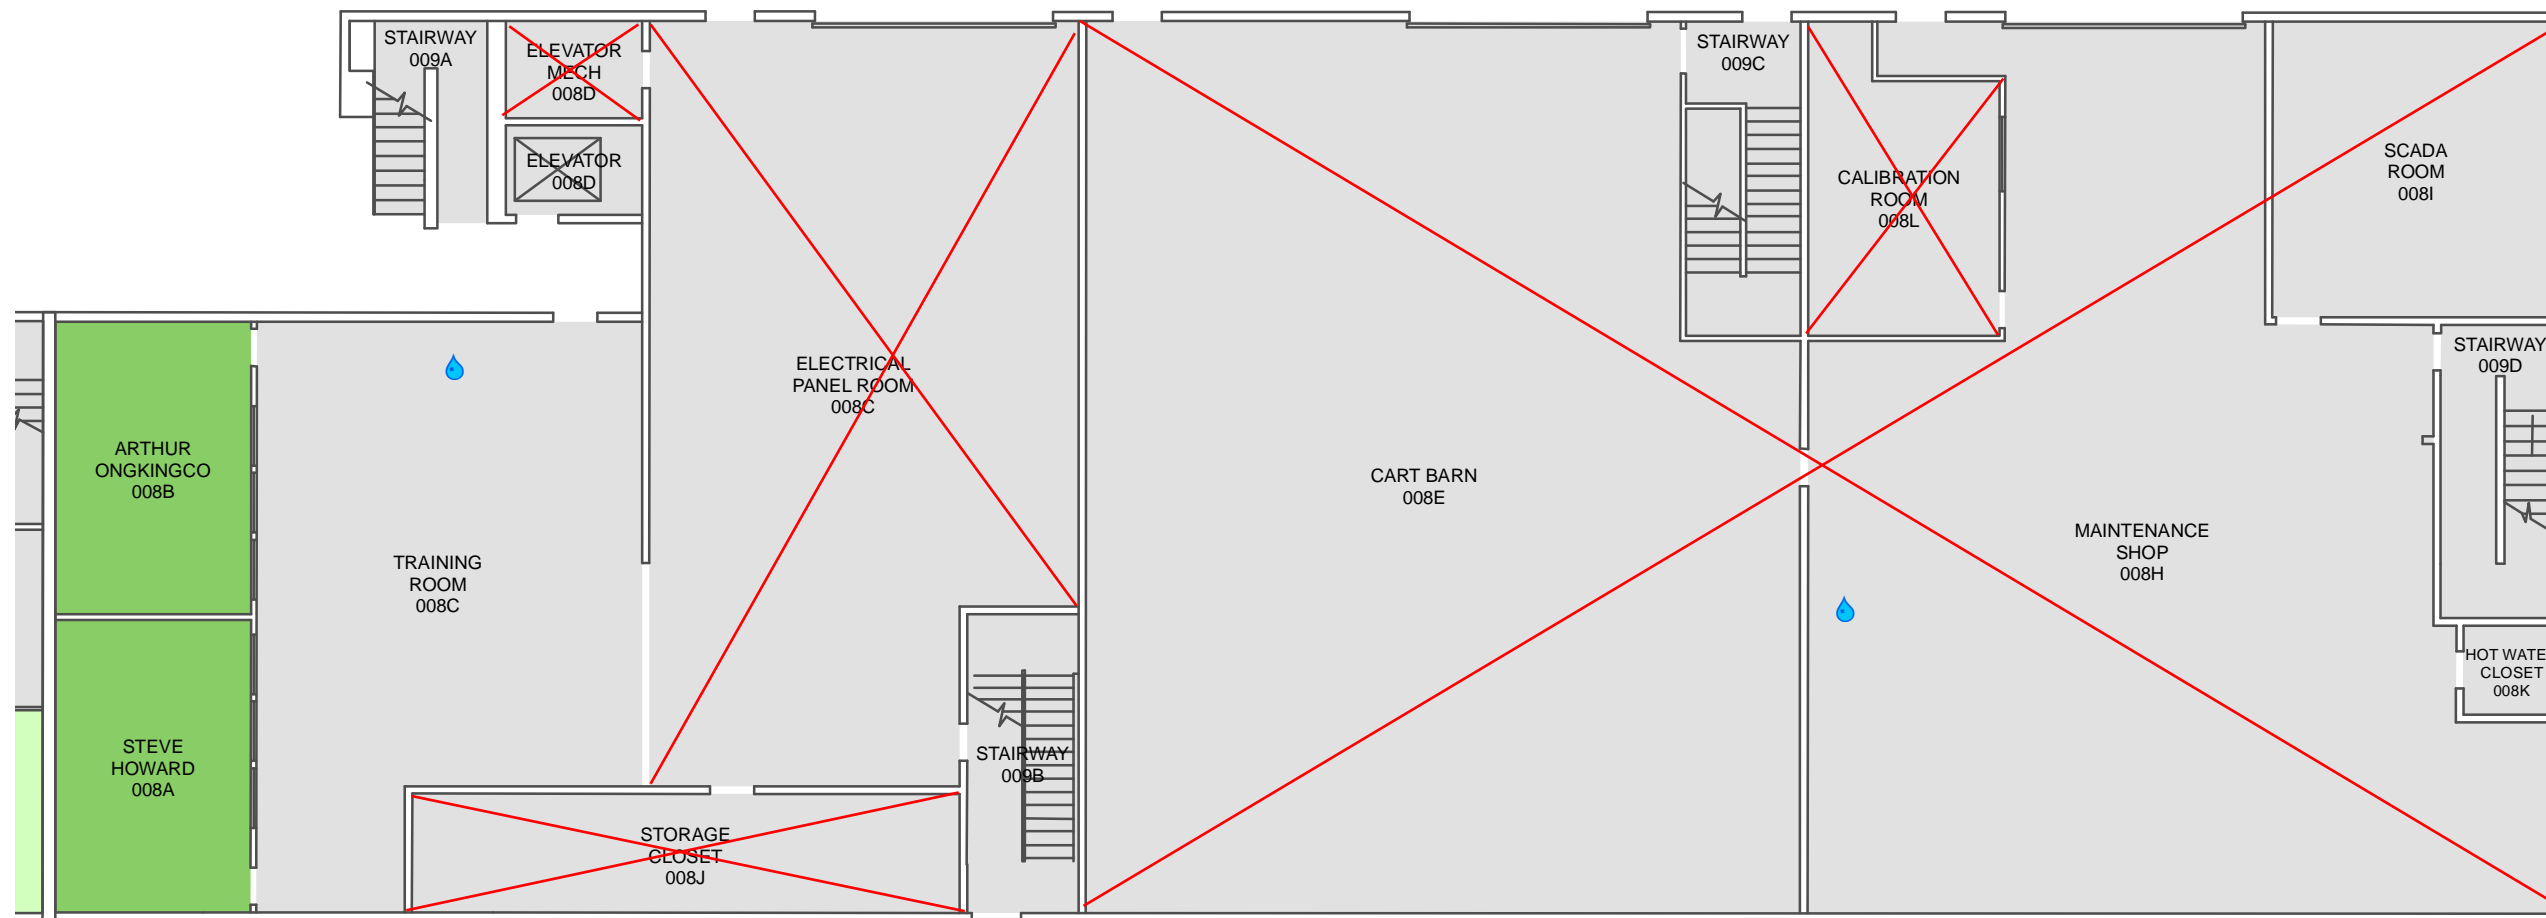

KEY MAP
NTS



DIVISION

- 870
- Water Dispenser
- Fire Extinguisher
- Pull Station

ADDITIONS OR REVISIONS TO THIS FLOOR PLAN SHOULD BE MARKED UP AND RETURNED TO DIVISION 250 - ENTERPIRSE INFORMATION MANAGEMENT. EGIS@OCS.D.COM




ORANGE COUNTY
SANITATION DISTRICT




BUILDING 6 - SECOND FLOOR

LOOP TAG NUMBER 19RROOM_____

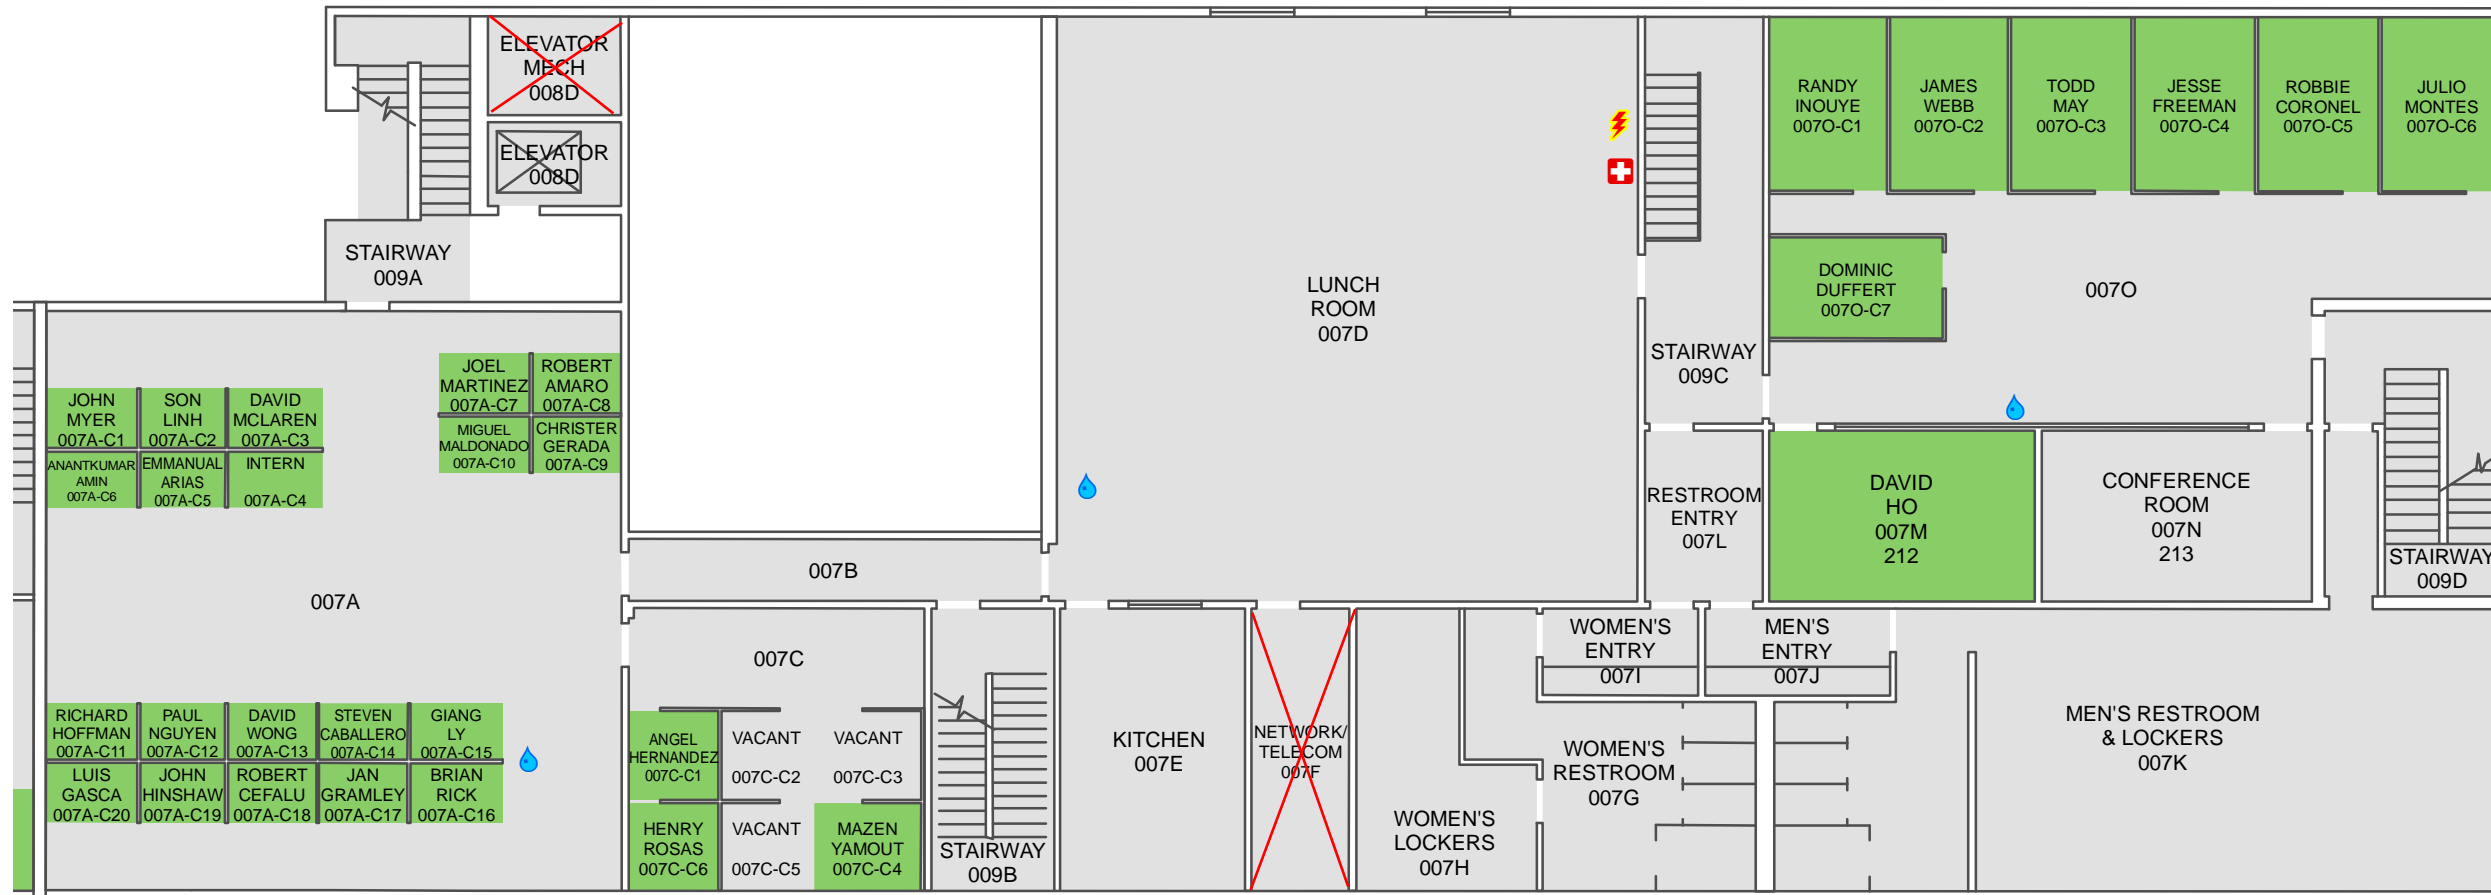

19RSTRC003

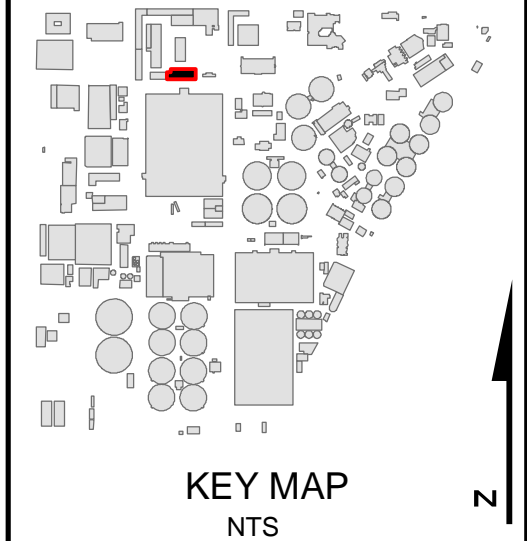

DIVISION

- 870
- Water Dispenser
- AED
- Fire Extinguisher
- First Aid Kit
- Pull Station


ADDITIONS OR REVISIONS TO THIS FLOOR PLAN SHOULD BE MARKED UP AND RETURNED TO DIVISION 250 - ENTERPRISE INFORMATION MANAGEMENT. EGIS@OCS.D.COM



ORANGE COUNTY
SANITATION DISTRICT

BUILDING A - FIRST FLOOR

LOOP TAG NUMBER 19DROOM _____

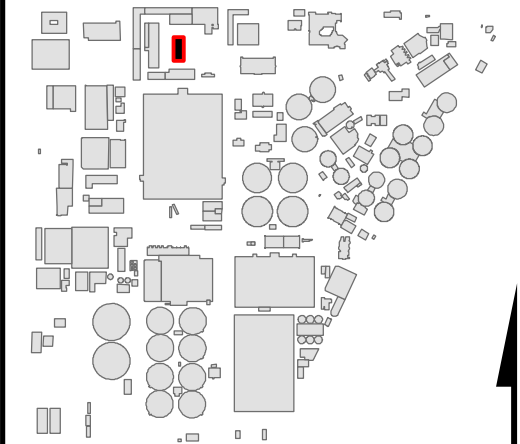

KEY MAP
NTS


DIVISION

- 870
- Water Dispenser
- AED
- Fire Extinguisher
- First Aid Kit
- Pull Station

ADDITIONS OR REVISIONS TO THIS FLOOR PLAN SHOULD BE MARKED UP AND RETURNED TO DIVISION 250 - ENTERPRISE INFORMATION MANAGEMENT. EGIS@OCS.D.COM



ORANGE COUNTY
SANITATION DISTRICT

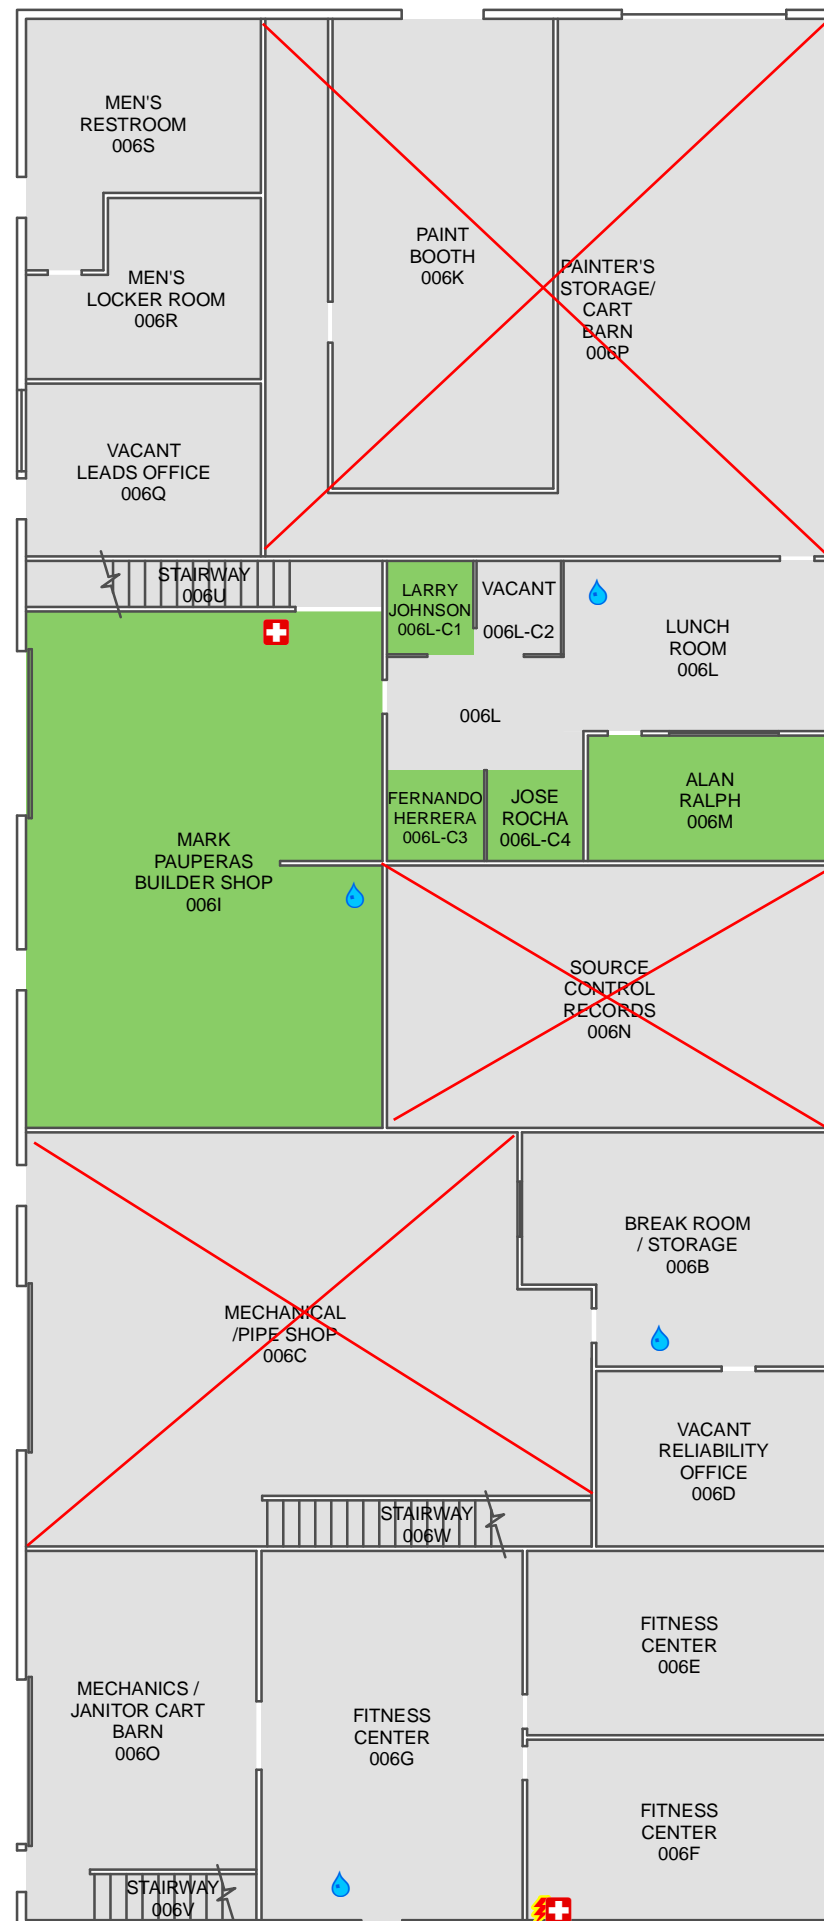

BUILDING B & 3 - FIRST FLOOR

LOOP TAG NUMBER 19DROOM_____



KEY MAP
NTS



DIVISION

- 870
- Water Dispenser
- Fire Extinguisher
- + First Aid Kit
- P Pull Station


ADDITIONS OR REVISIONS TO THIS FLOOR PLAN SHOULD BE MARKED UP AND RETURNED TO DIVISION 250 - ENTERPIRSE INFORMATION MANAGEMENT. EGIS@OCS.D.COM



ORANGE COUNTY
SANITATION DISTRICT




Only areas that are cleaned. The other desks do not get cleaned but the trash cans are to be emptied.

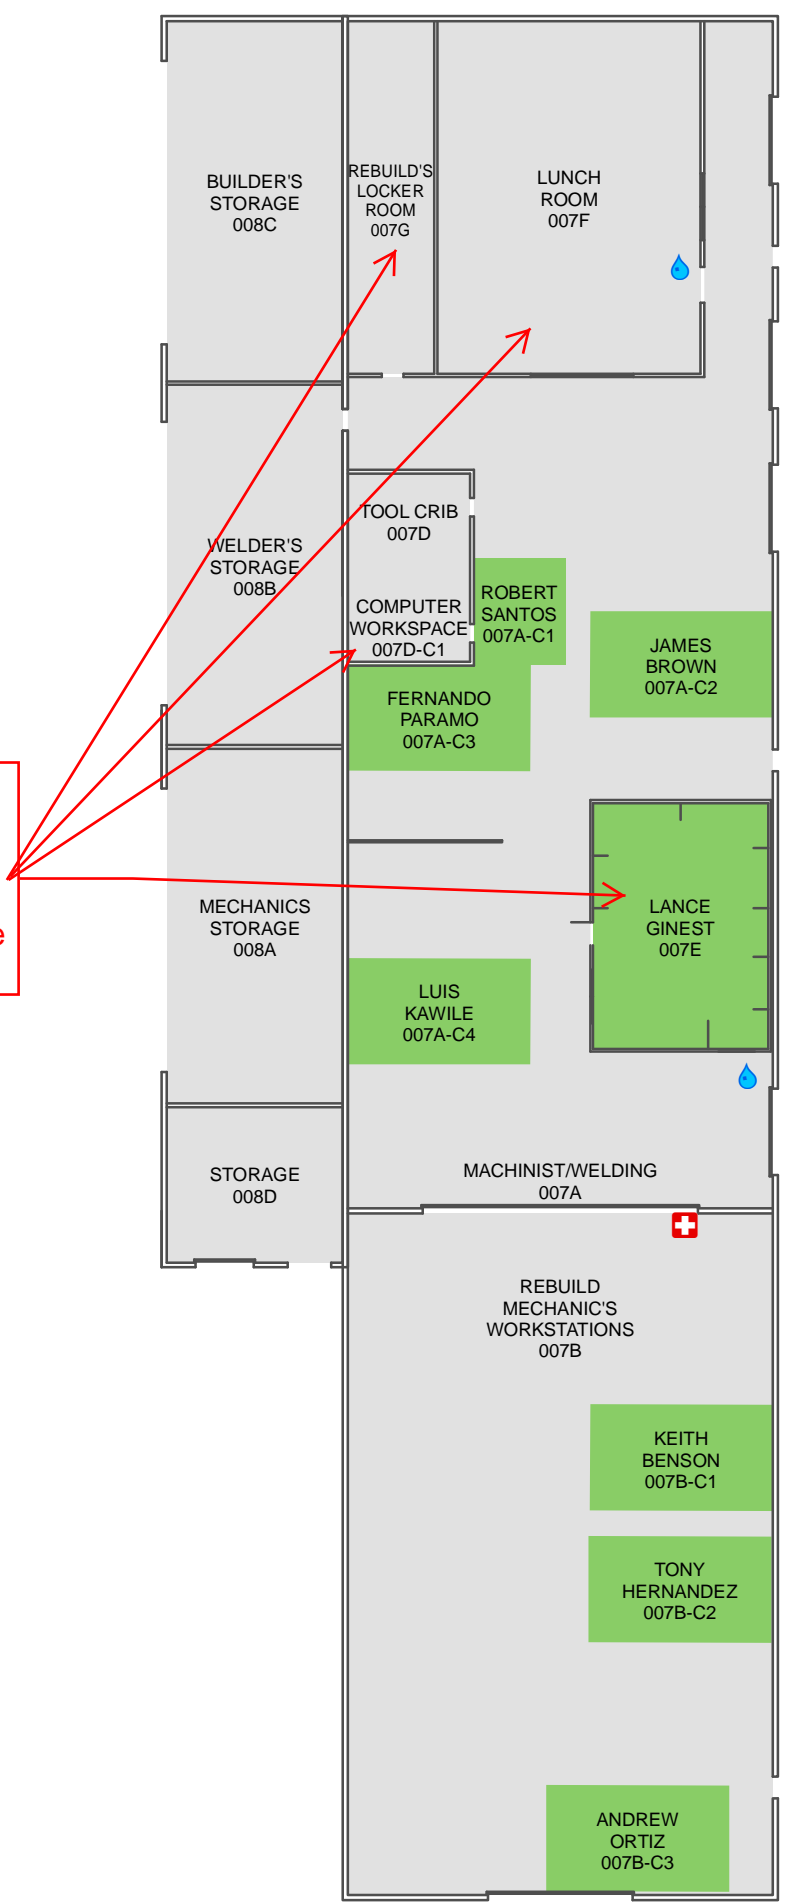


LOOP TAG LOCATION
12CROOM ____

Refer to Appendix
A-4 for Detail. Only
area in this
building.

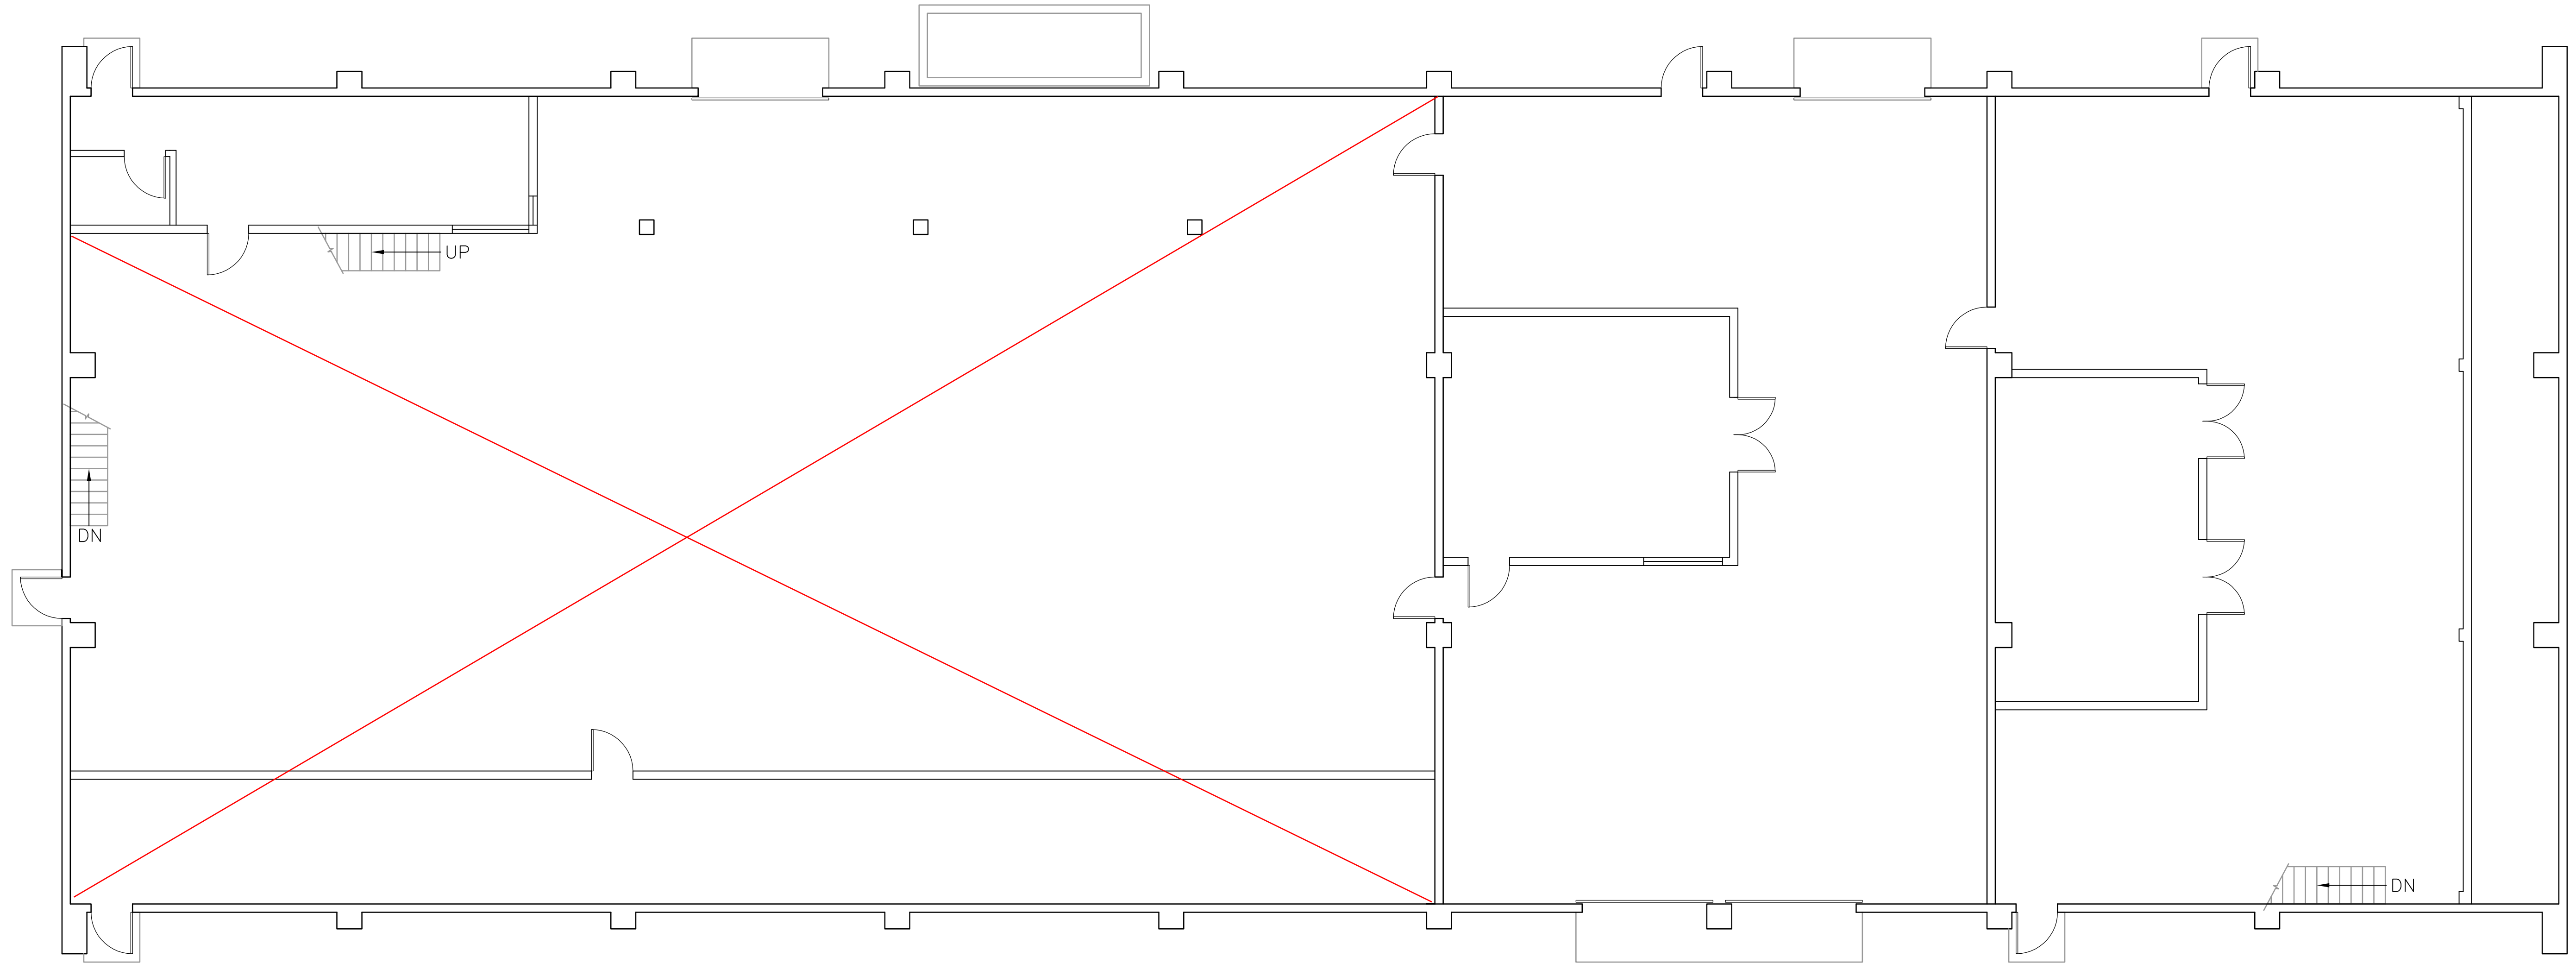

BLOWER BUILDING

NTS

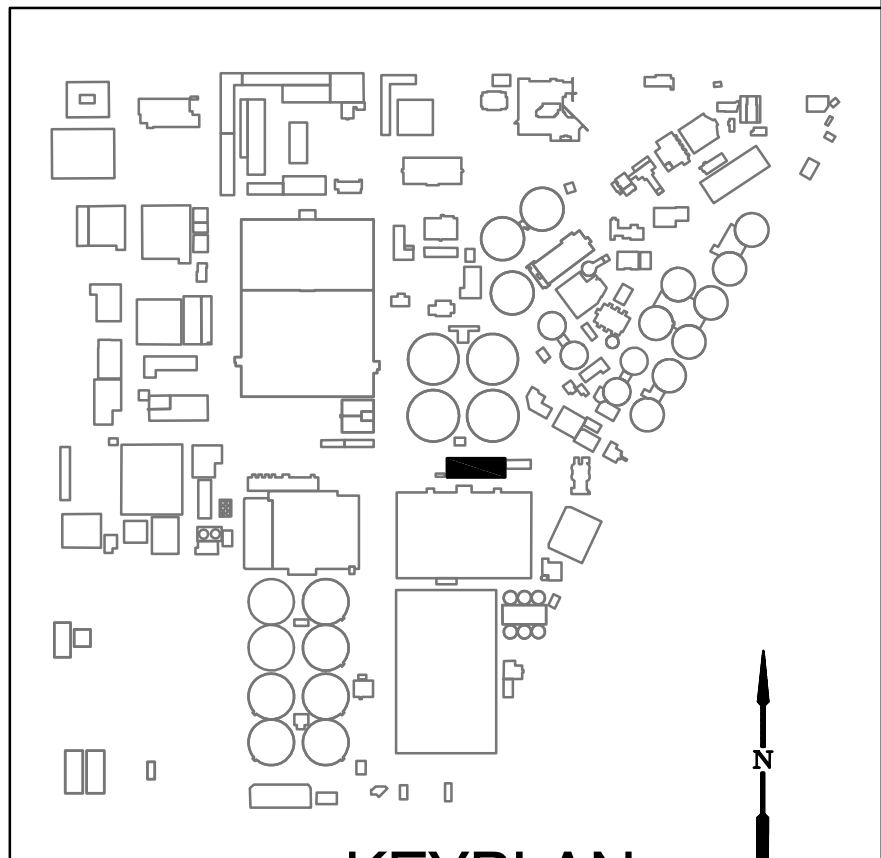

KEYPLAN


NTS

ANY ADDITIONS OR REVISIONS TO THIS
FLOOR PLAN SHOULD BE MARKED UP AND
RETURNED TO DIVISION 250 - ENTERPRISE
INFORMATION MANAGEMENT. EGIS@OCSD.COM

DWG: J:\Facility Models\Architectural\Plant 1\FINAL FLOOR PLANS\DWG\P1-00-A-FLOOR-BLWR-01.dwg
 DATE: Feb 20, 2014 7:37am
 USER: wrfide
 XREFS: BASELINE-GUDDK

MARK	DESCRIPTION	DATE	APPR.

DESIGNED BY: _____
 DRAWN BY: RT 06/13
 CHECKED BY: _____
 LINE IS 2 INCHES
 AT FULL SIZE
 (IF NOT 2" - SCALE ACCORDINGLY)

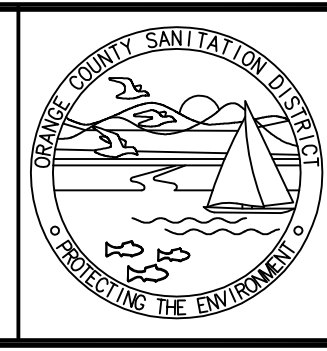

**ORANGE COUNTY
SANITATION DISTRICT**


PLANT NO. 1
BASELINE BUILDING FLOOR PLAN

**BLOWER BUILDING
LAYOUT PLAN**


PROJECT NO. BASELINE

DRAWING NO. _____
OF _____

LOOP TAG LOCATION
16AROOM__

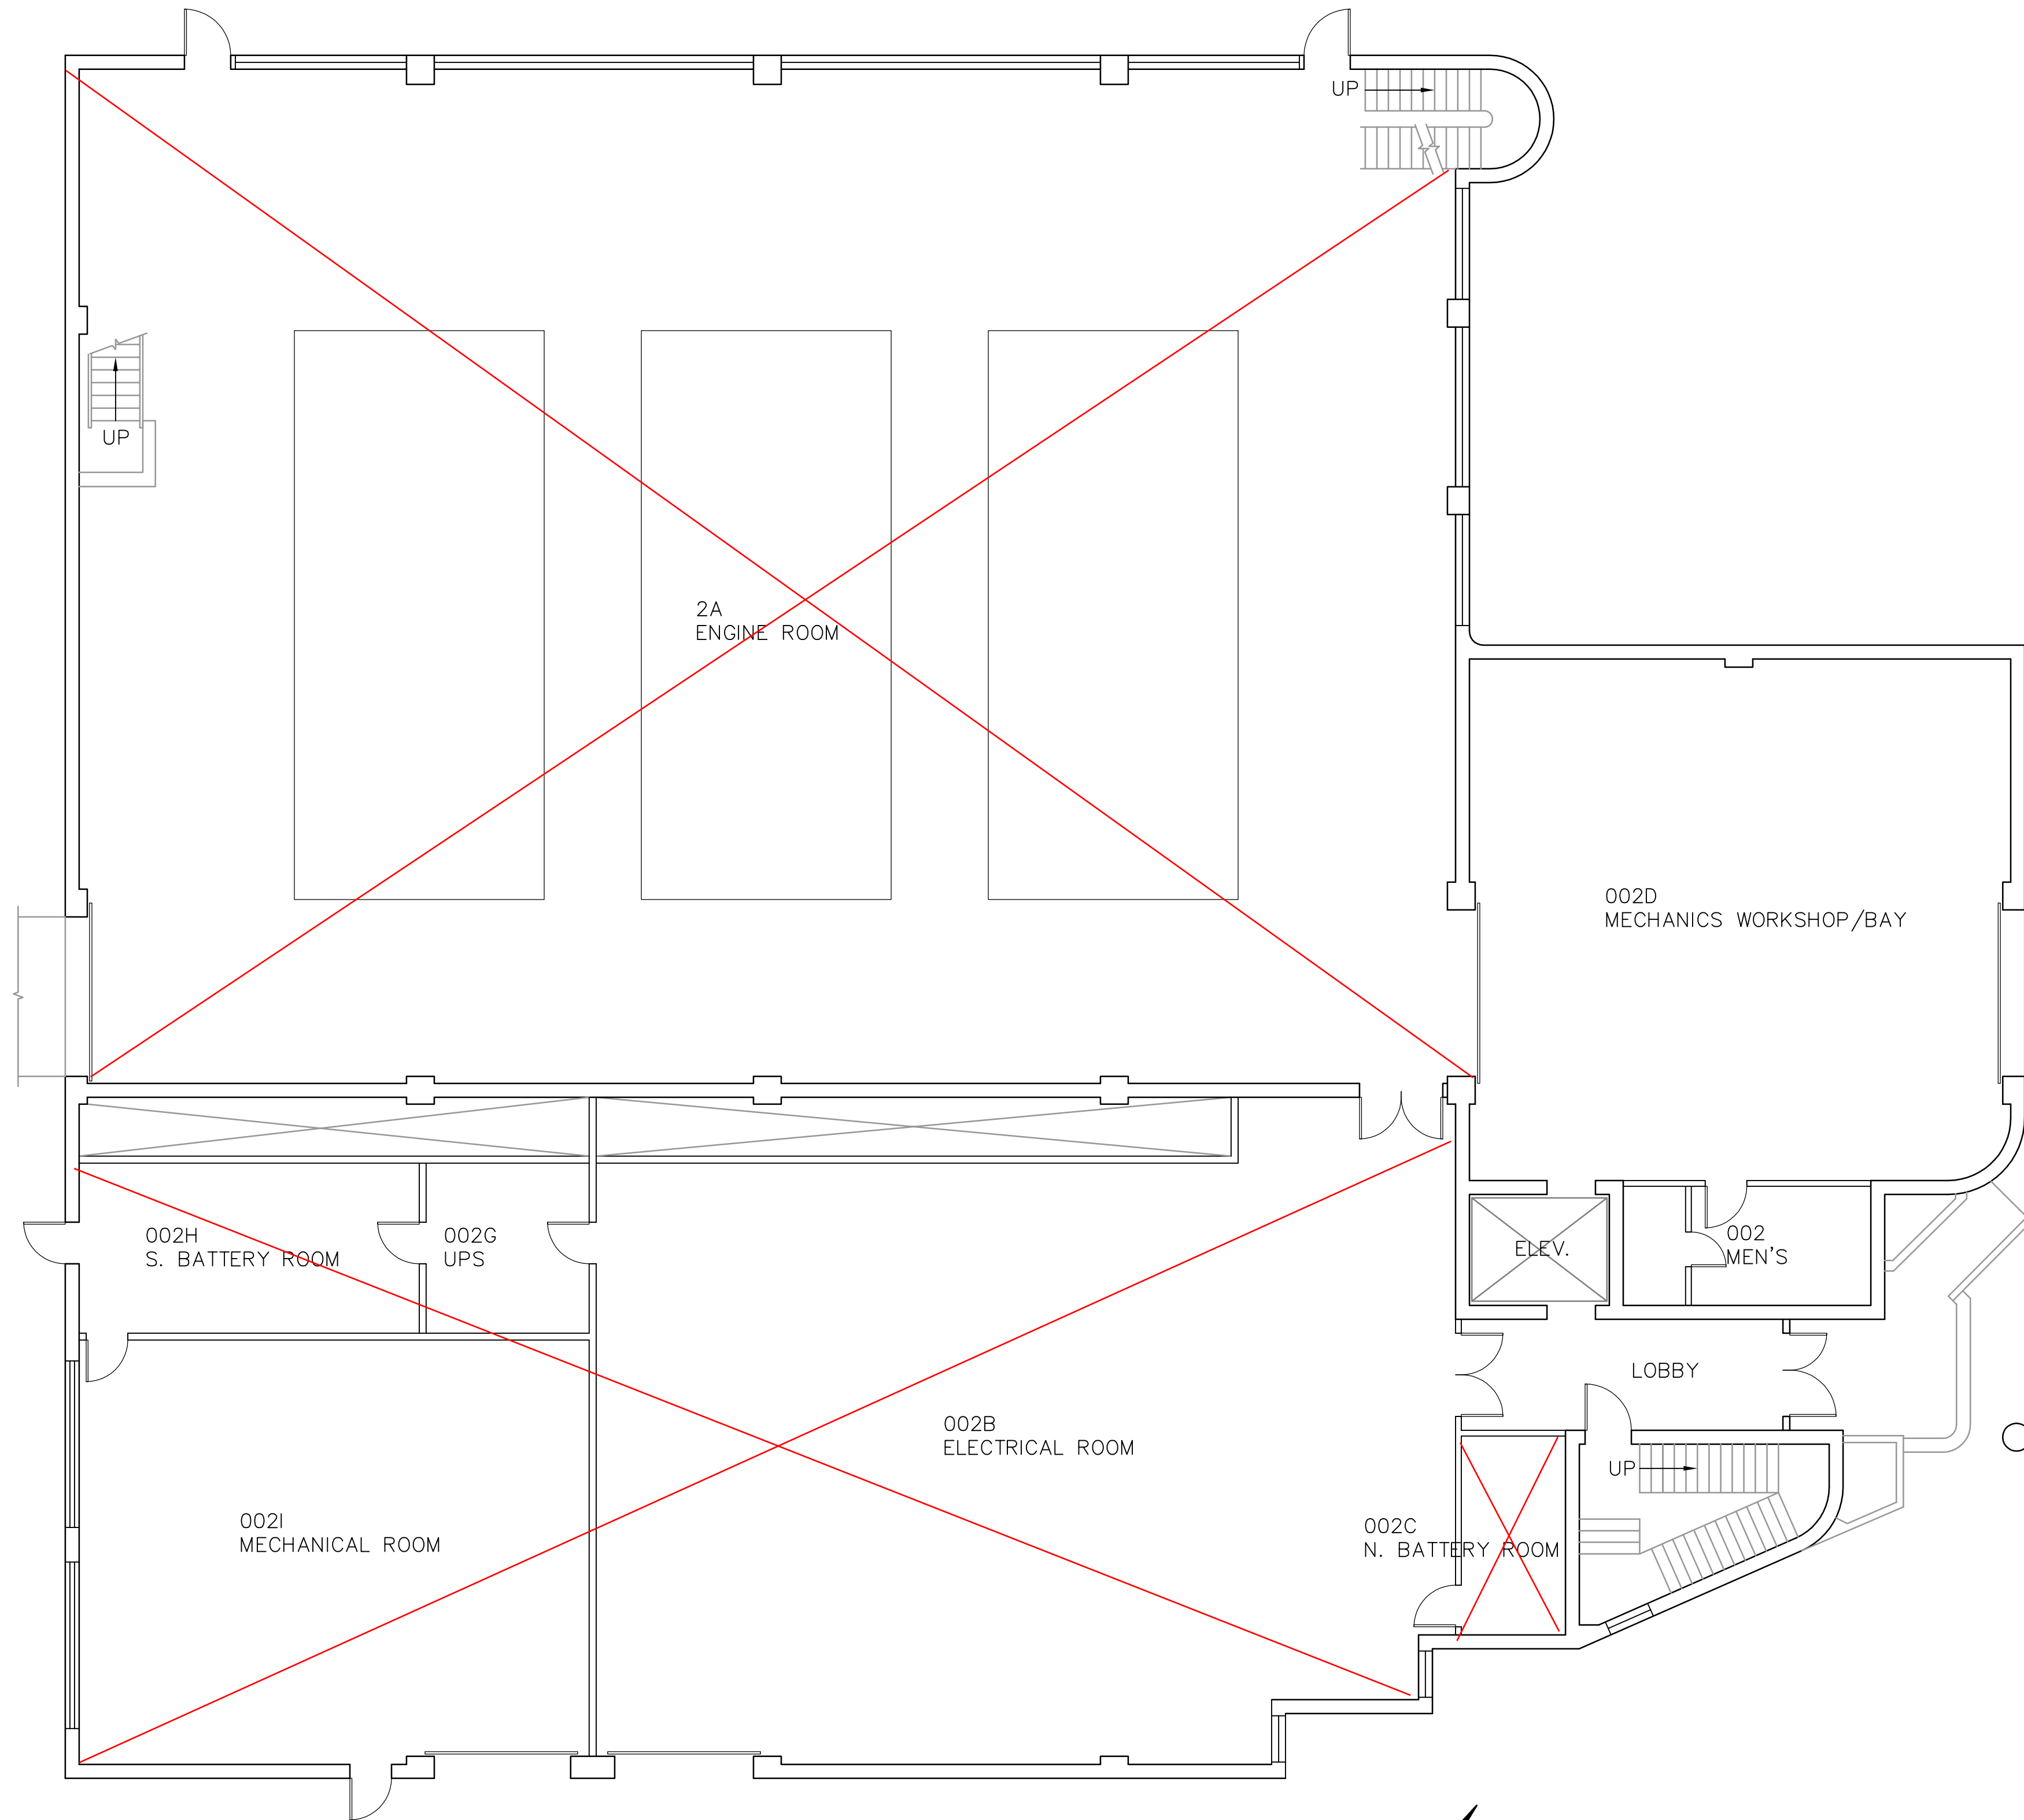

CENTRAL POWER GENERATION - FIRST FLOOR PLAN
NTS

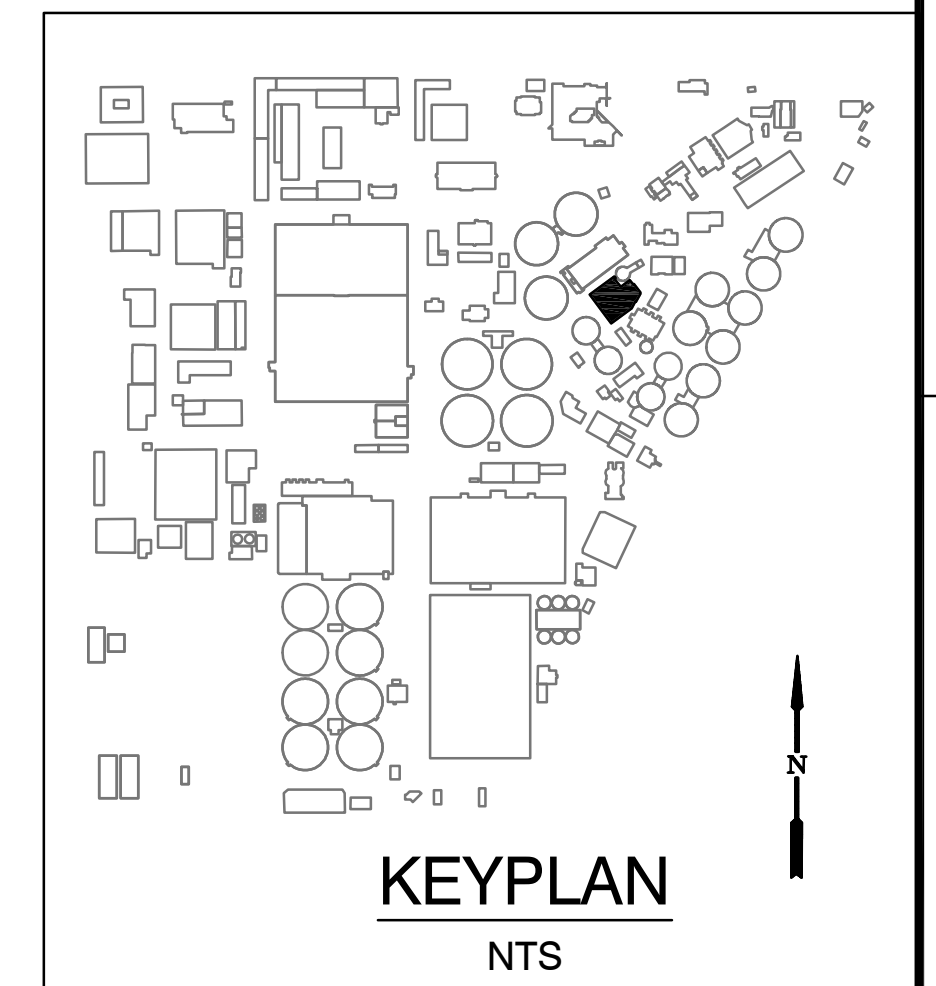


ANY ADDITIONS OR REVISIONS TO THIS FLOOR PLAN SHOULD BE MARKED UP AND RETURNED TO DIVISION 250 - ENTERPRISE INFORMATION MANAGEMENT. EGIS@OCSD.COM

DWG: J:\Facility Models\Architectural\Plant 1\FINAL FLOOR PLANS\DWG\P1-00-A-FLOOR-CGEN-01.dwg
 DATE: Feb 20, 2014 7:37am
 USER: wrwide
 XREFS: BASELINE-GBDDK

DESIGNED BY: _____
 DRAWN BY: RT 06/13
 CHECKED BY: _____

LINE IS 2 INCHES
 AT FULL SIZE
 (IF NOT 2" - SCALE ACCORDINGLY)

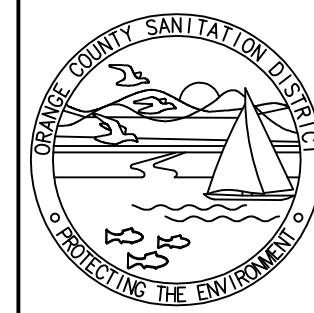


**ORANGE COUNTY
SANITATION DISTRICT**

PLANT NO. 1
 BASELINE BUILDING FLOOR PLAN
 CENTRAL POWER GENERATION
 FIRST FLOOR
 LAYOUT PLAN

PROJECT NO. BASELINE
 DRAWING NO. _____
 OF _____

MARK	DESCRIPTION	DATE	APPR.


LOOP TAG LOCATION
16AROOM___

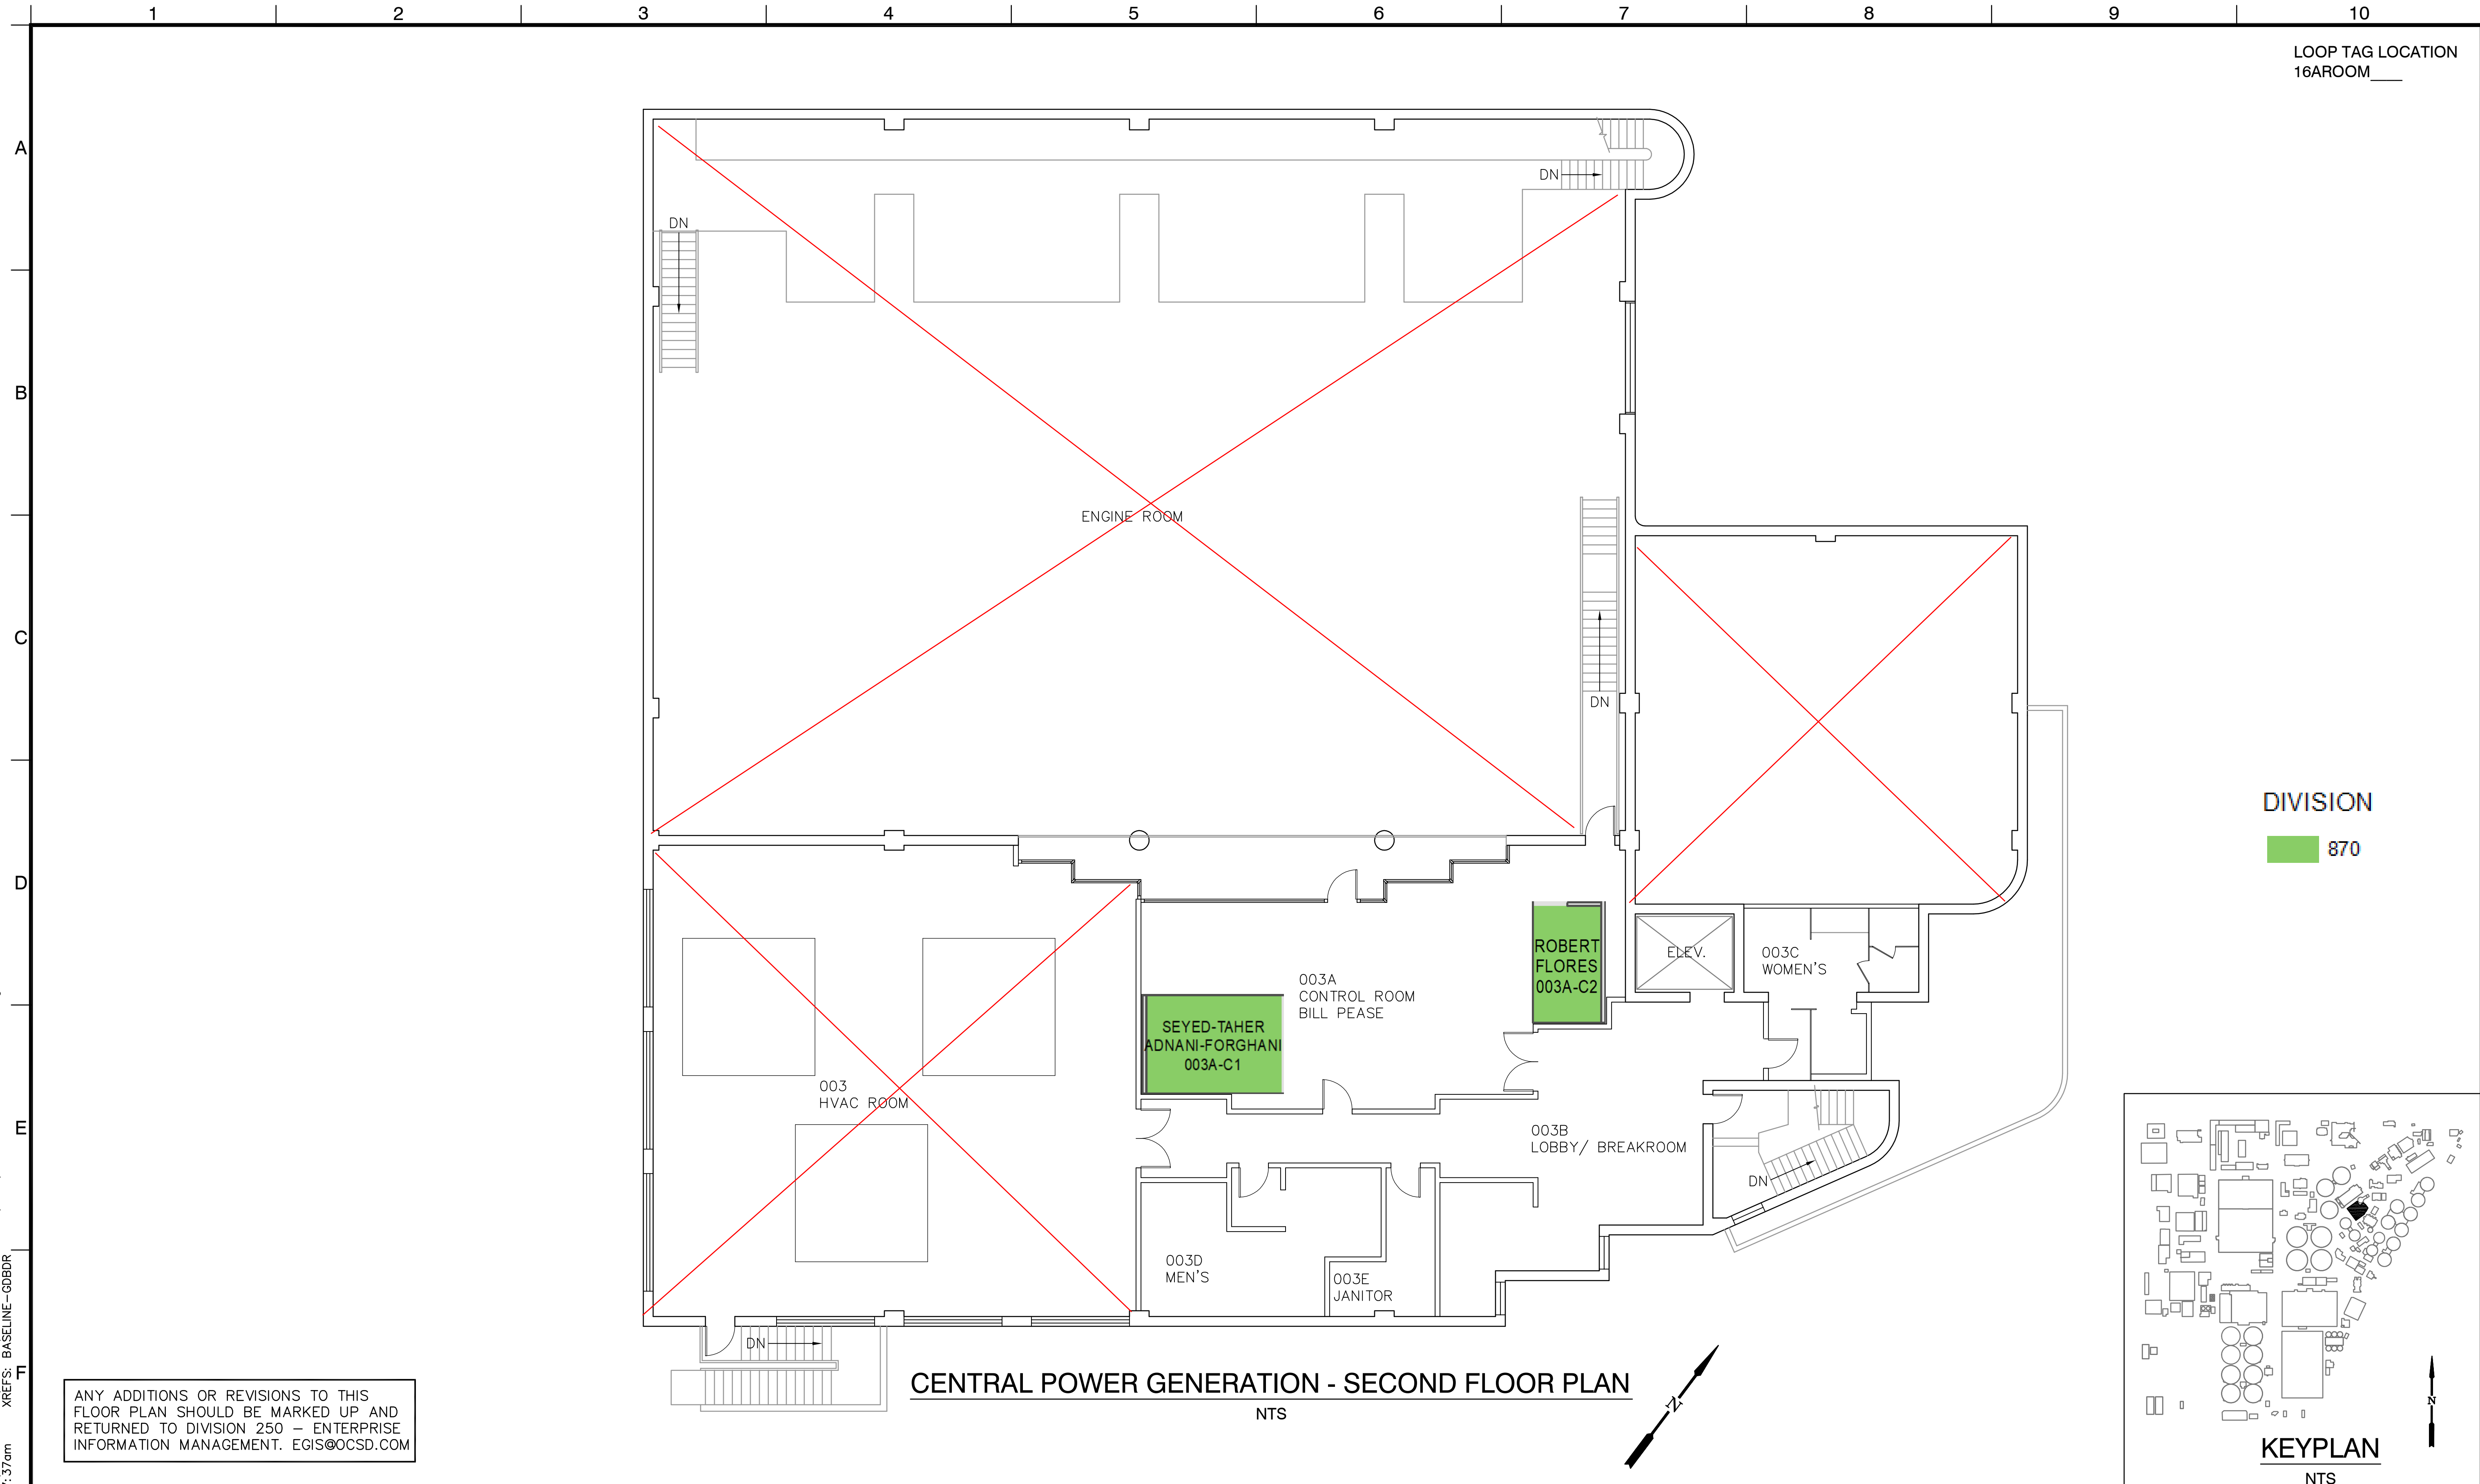

DIVISION
870

ANY ADDITIONS OR REVISIONS TO THIS FLOOR PLAN SHOULD BE MARKED UP AND RETURNED TO DIVISION 250 - ENTERPRISE INFORMATION MANAGEMENT. EGIS@OCSD.COM


CENTRAL POWER GENERATION - SECOND FLOOR PLAN
NTS

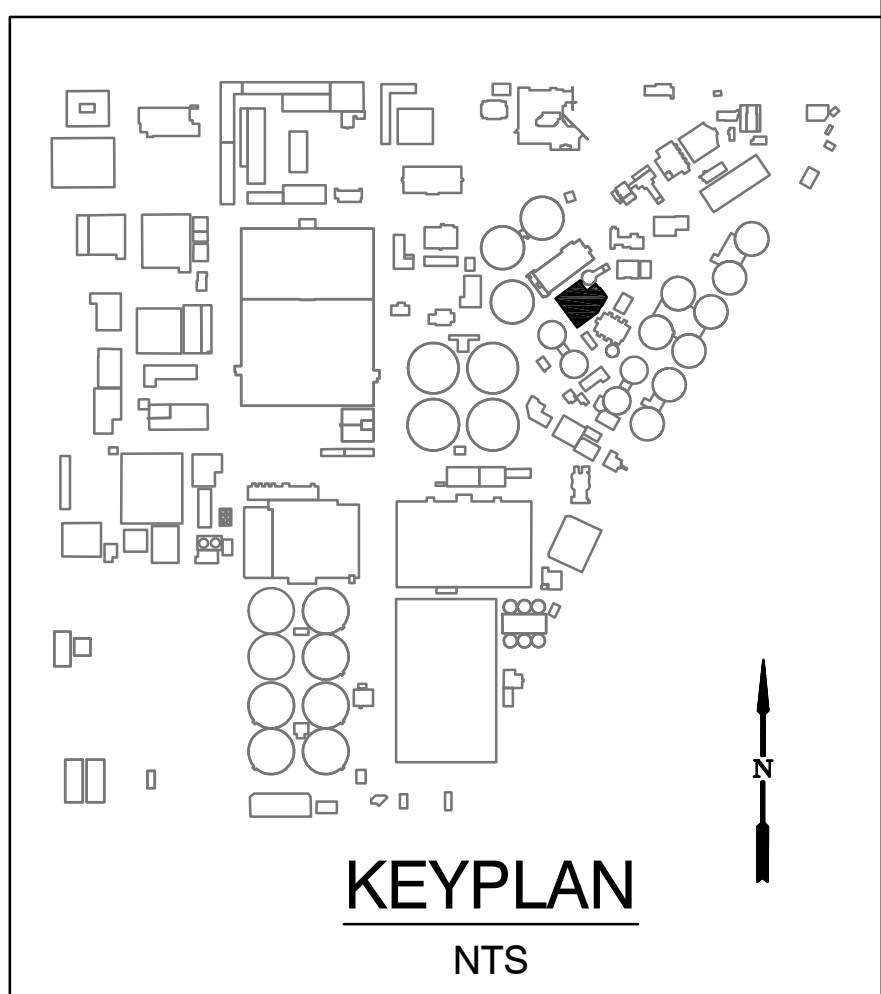

DWG: j:\Facility Models\Architectural\Plant 1\FINAL FLOOR PLANS\DWG\P1-00-A-FLOOR-CGEN-02.dwg
 DATE: Feb 20, 2014 7:37am
 USER: wrwide
 XREFS: BASELINE-GBBDR

MARK	DESCRIPTION	DATE	APPR.

DESIGNED BY: _____
 DRAWN BY: RT 06/13
 CHECKED BY: _____
 LINE IS 2 INCHES AT FULL SIZE
 (IF NOT 2" - SCALE ACCORDINGLY)

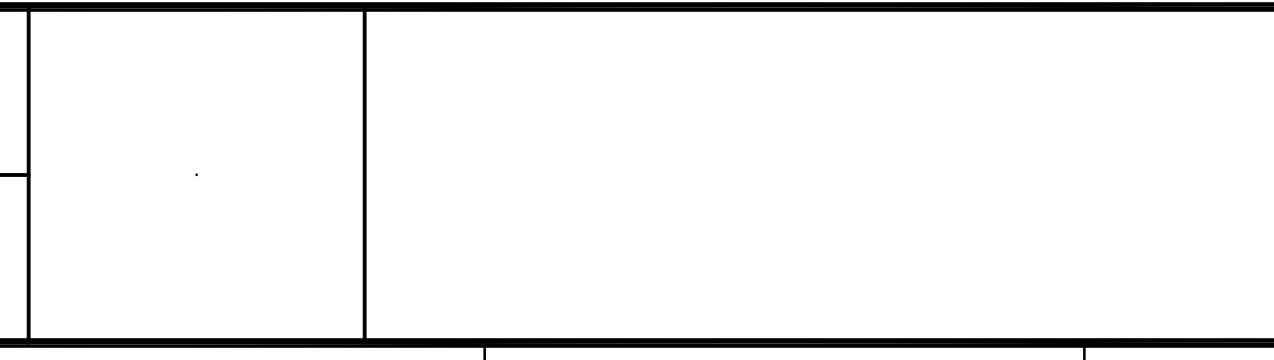


ORANGE COUNTY SANITATION DISTRICT

PLANT NO. 1
 BASELINE BUILDING FLOOR PLAN
CENTRAL POWER GENERATION SECOND FLOOR LAYOUT PLAN

PROJECT NO. BASELINE
 DRAWING NO. _____
 OF _____

LOOP TAG LOCATION
16AROOM___

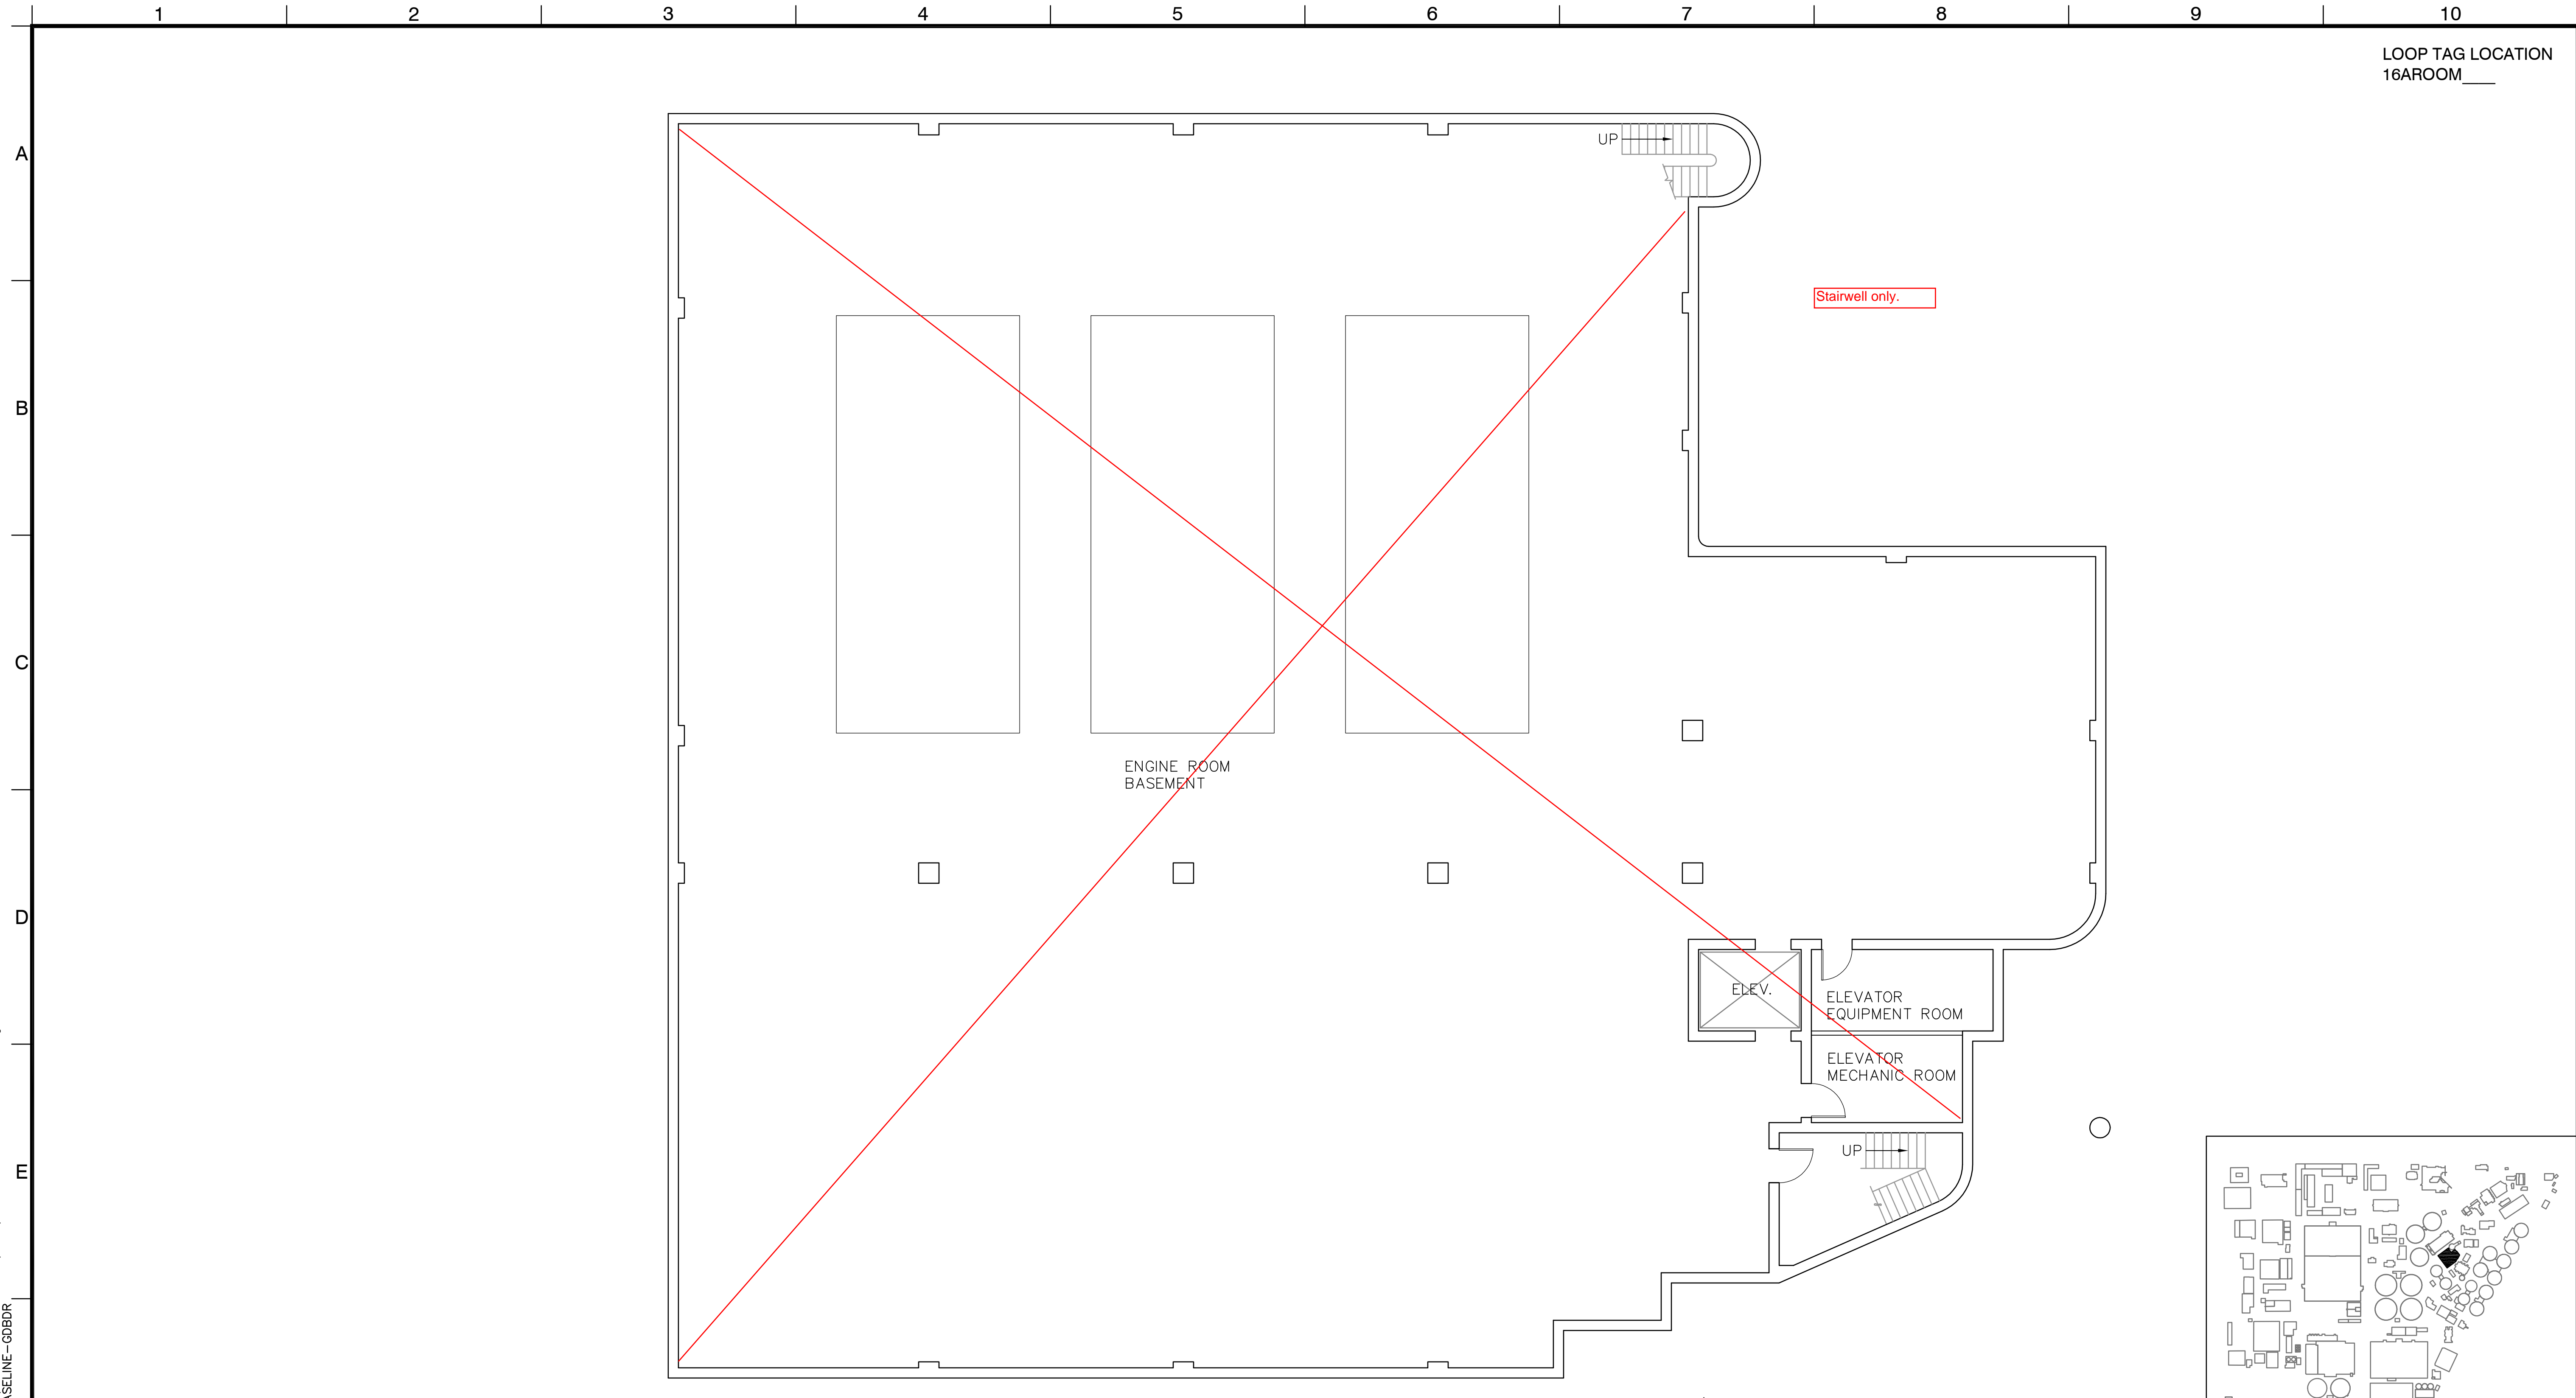

Stairwell only.

ENGINE ROOM
BASEMENT

ELEV.



ELEVATOR
EQUIPMENT ROOM

ELEVATOR
MECHANIC ROOM

UP

CENTRAL POWER GENERATION - BASEMENT FLOOR PLAN

NTS

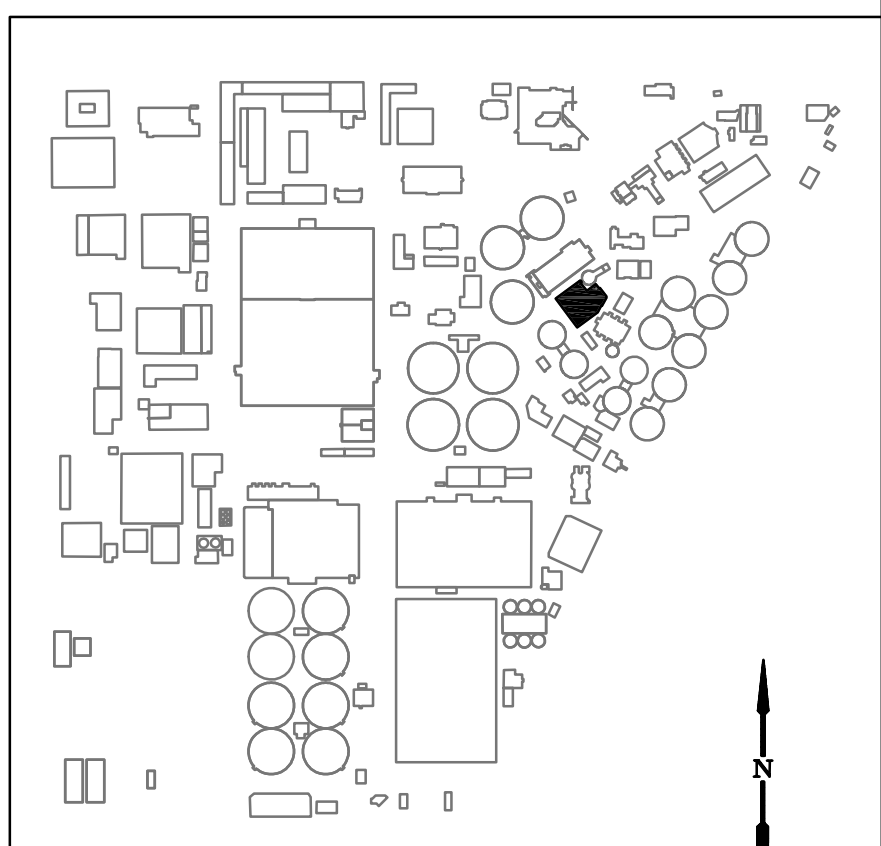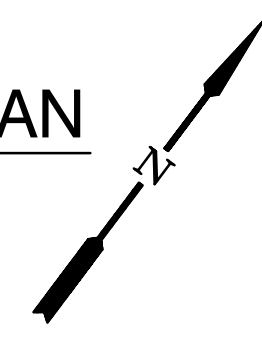


KEYPLAN

ANY ADDITIONS OR REVISIONS TO THIS FLOOR PLAN SHOULD BE MARKED UP AND RETURNED TO DIVISION 250 - ENTERPRISE INFORMATION MANAGEMENT. EGIS@OCSD.COM

DWG: j:\Facility Models\Architectural\Plant 1\FINAL FLOOR PLANS\DWG\P1-00-A-FLOOR-CGEN-BA.dwg USER: wrfide
 DATE: Feb 20, 2014 7:37am XREFS: BASELINE-GUDDK

MARK	DESCRIPTION	DATE	APPR.

DESIGNED BY: _____
 DRAWN BY: RT 06/13
 CHECKED BY: _____
 LINE IS 2 INCHES
 AT FULL SIZE
 (IF NOT 2" - SCALE ACCORDINGLY)

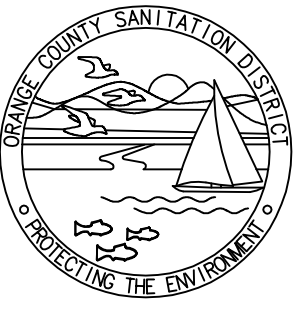


**ORANGE COUNTY
SANITATION DISTRICT**

PLANT NO. 1
 BASELINE BUILDING FLOOR PLAN
**CENTRAL POWER GENERATION
 BASEMENT FLOOR
 LAYOUT PLAN**


PROJECT NO. BASELINE
 DRAWING NO. _____
 OF _____

19ESTRC001

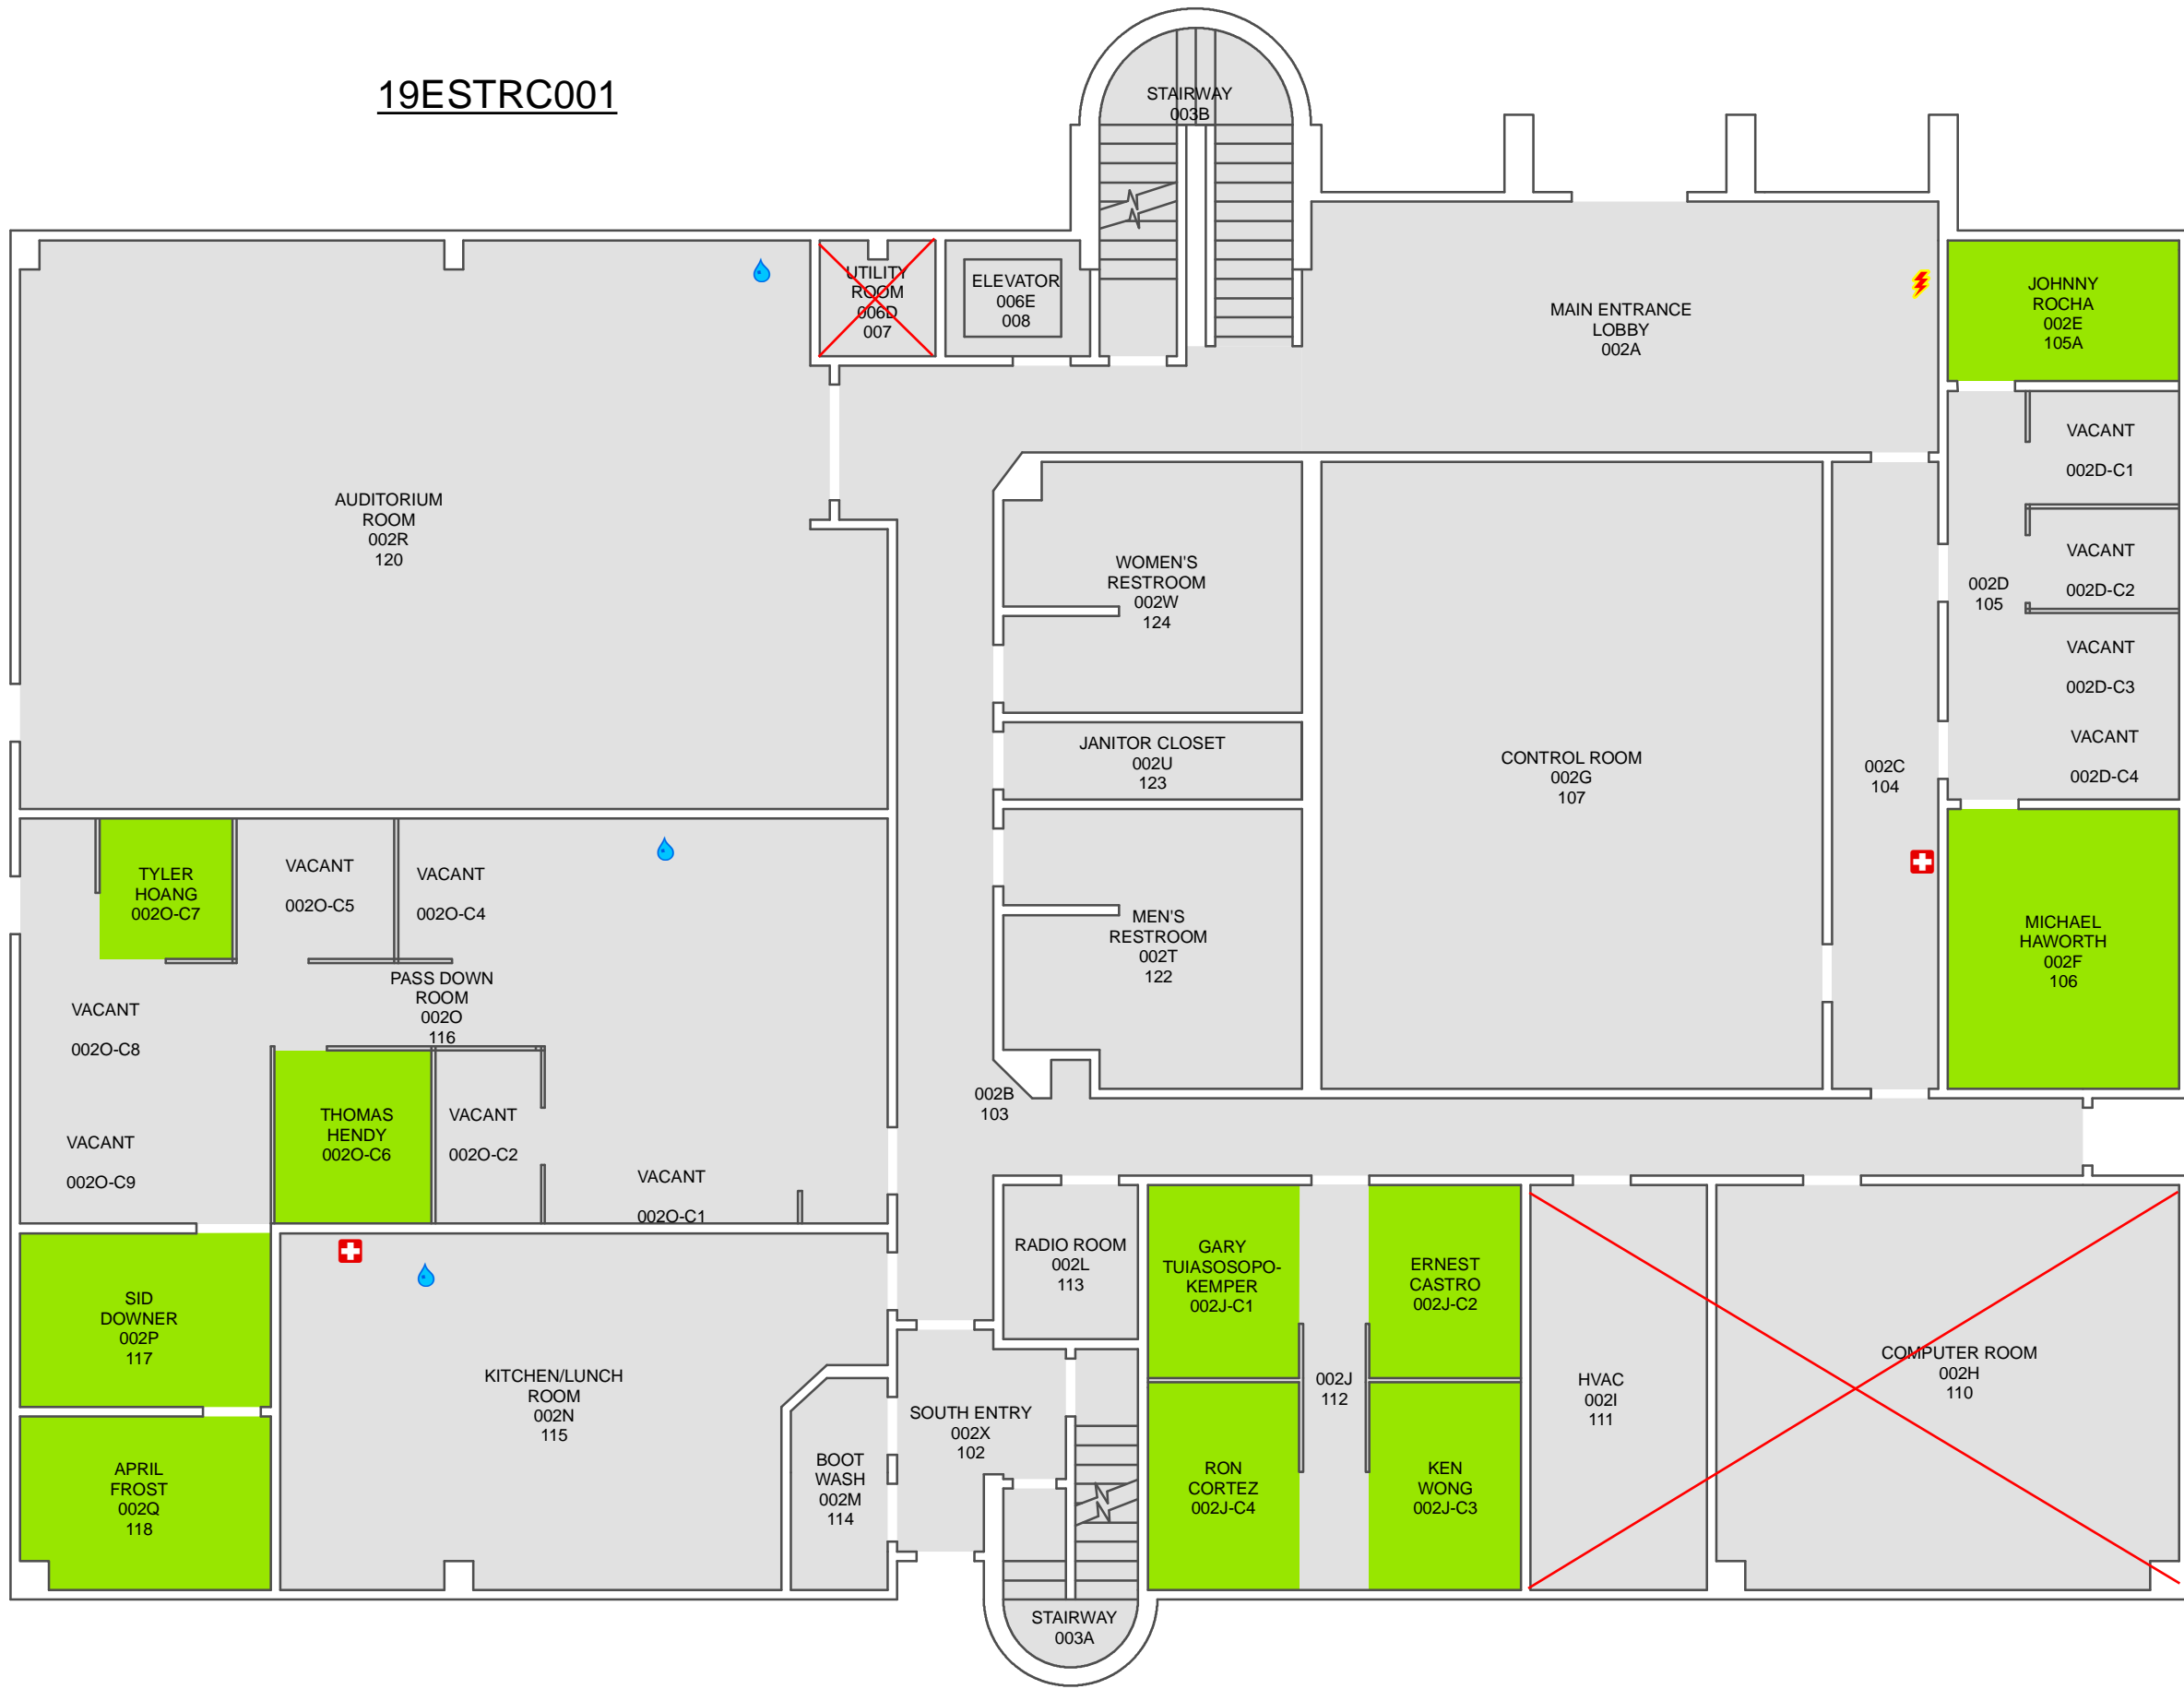

CONTROL CENTER - FIRST FLOOR

LOOP TAG NUMBER 19EROOM _____

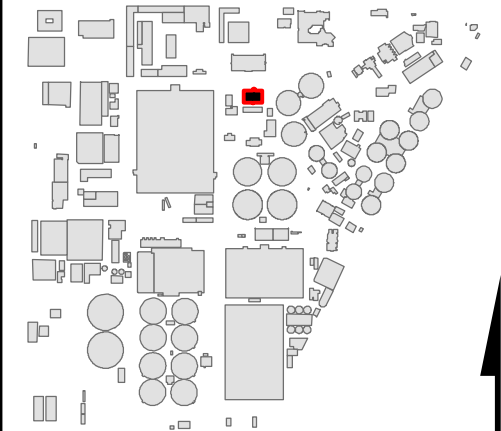

KEY MAP
NTS

DIVISION


- 830
- Water Dispenser
- AED
- Fire Extinguisher
- First Aid Kit
- Pull Station

ADDITIONS OR REVISIONS TO THIS FLOOR PLAN SHOULD BE MARKED UP AND RETURNED TO DIVISION 250 - ENTERPRISE INFORMATION MANAGEMENT. EGIS@OCS.D.COM




ORANGE COUNTY SANITATION DISTRICT

19ESTRC001

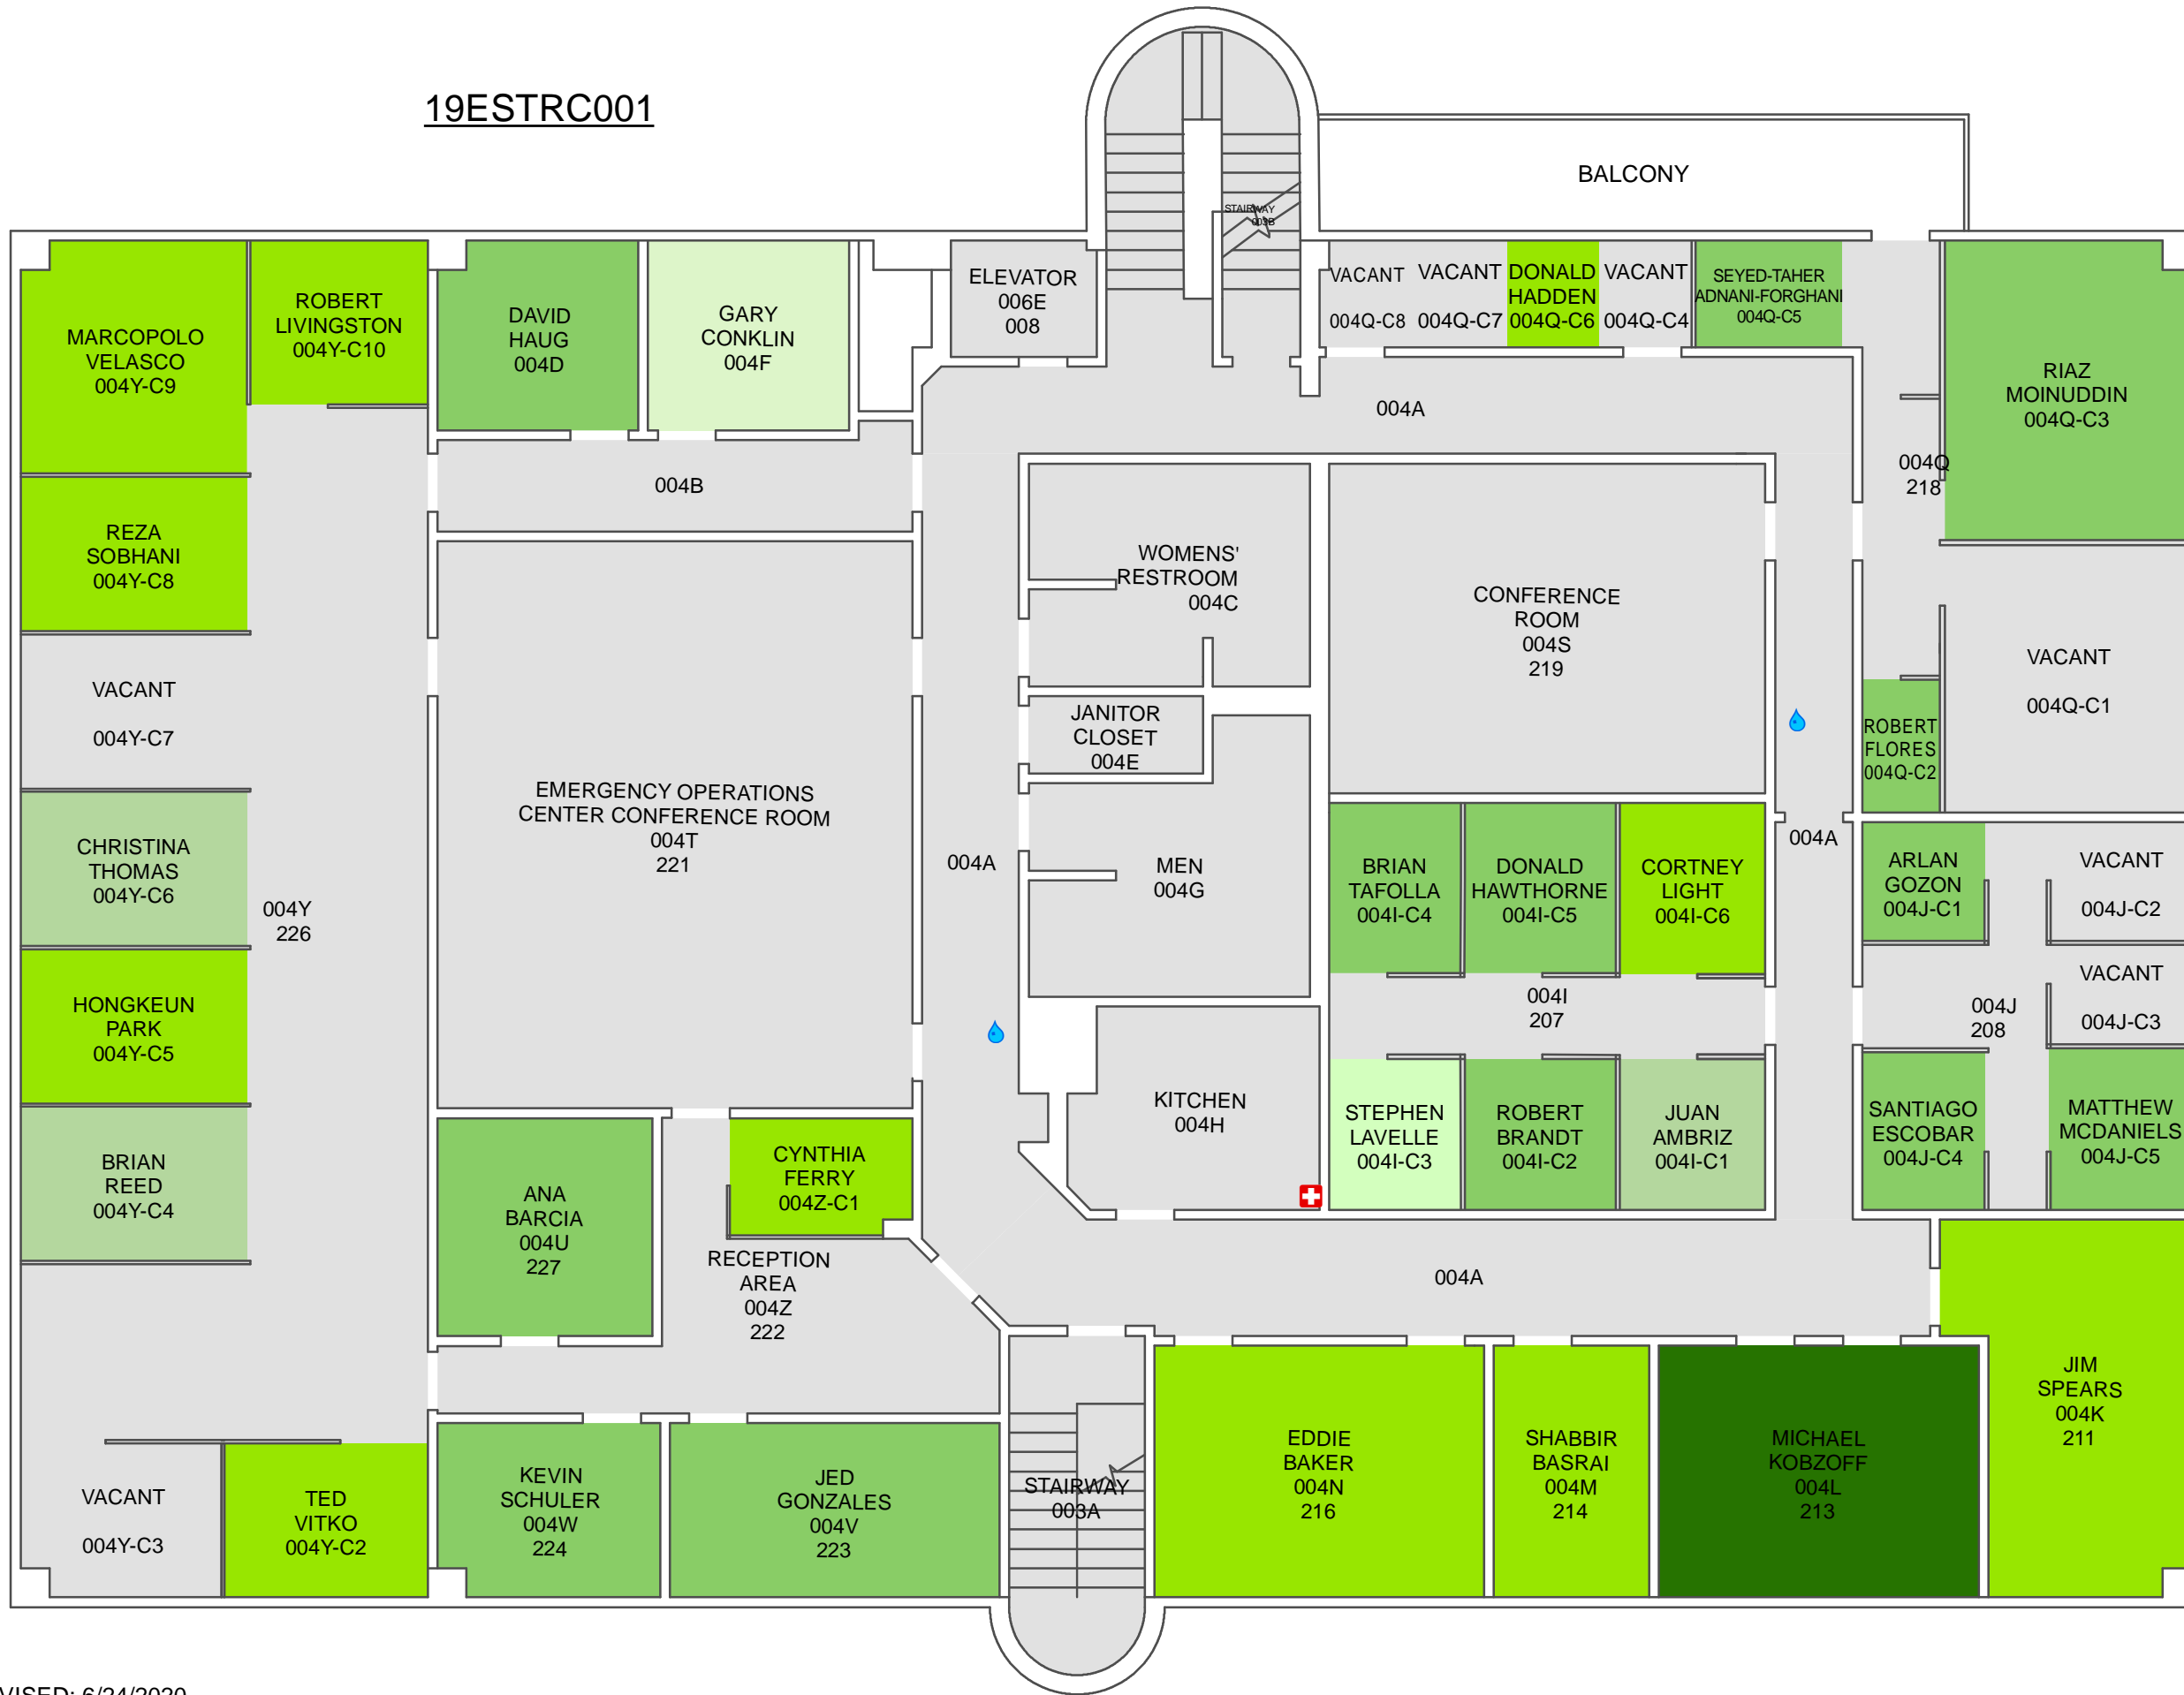

CONTROL CENTER - SECOND FLOOR

LOOP TAG NUMBER 19EROOM_____

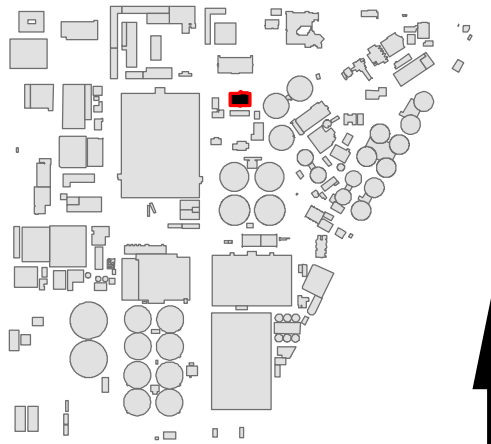

KEY MAP
NTS

DIVISION

- 810
- 820
- 830
- 870
- 880


- 💧 Water Dispenser
- 🔥 Fire Extinguisher
- + First Aid Kit
- P Pull Station

ADDITIONS OR REVISIONS TO THIS FLOOR PLAN SHOULD BE MARKED UP AND RETURNED TO DIVISION 250 - ENTERPRISE INFORMATION MANAGEMENT. EGIS@OCS.D.COM




ORANGE COUNTY
SANITATION DISTRICT

19ESTRC001

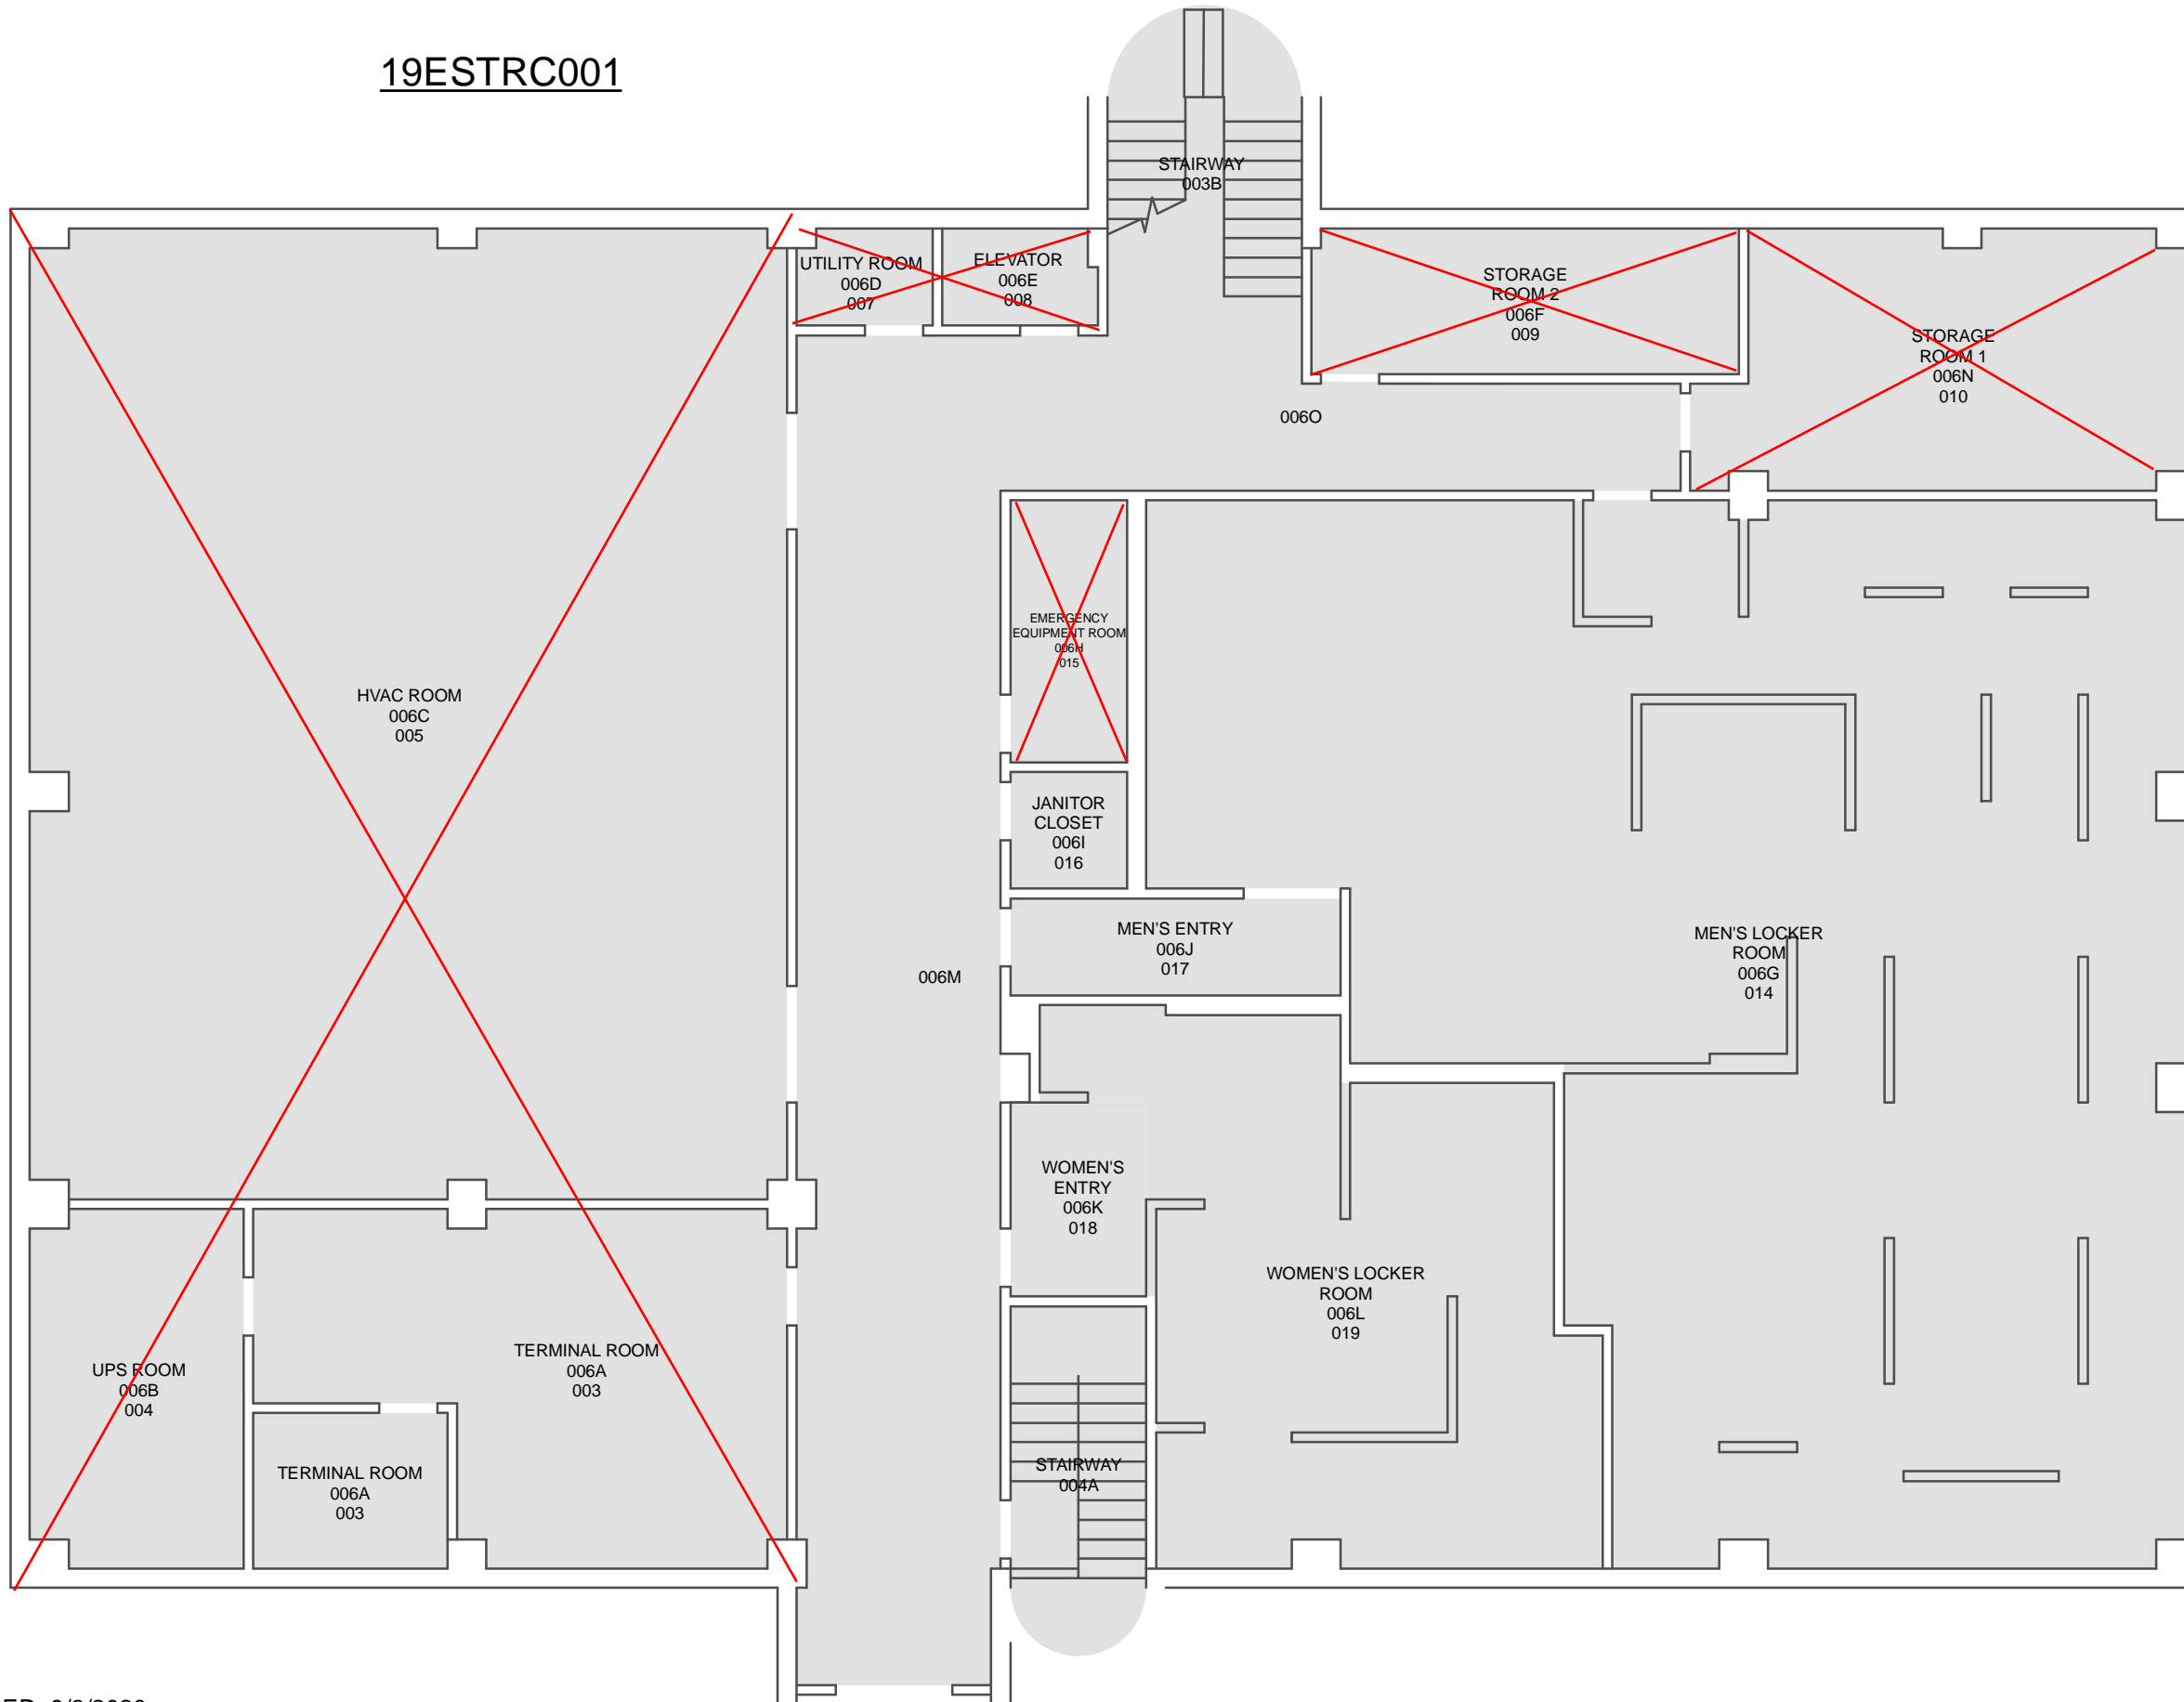

CONTROL CENTER - BASEMENT

LOOP TAG NUMBER 19EROOM _____

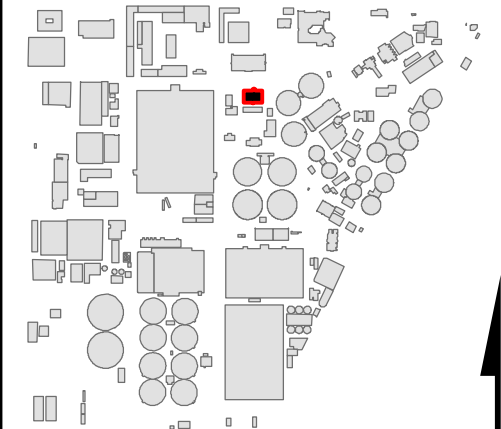

KEY MAP
NTS



DIVISION

- 830
- Water Dispenser
- AED
- Fire Extinguisher
- First Aid Kit
- Pull Station

ADDITIONS OR REVISIONS TO THIS FLOOR PLAN SHOULD BE MARKED UP AND RETURNED TO DIVISION 250 - ENTERPRISE INFORMATION MANAGEMENT. EGIS@OCS.D.COM



ORANGE COUNTY
SANITATION DISTRICT



DAFT PUMP ROOM - FIRST FLOOR

LOOP TAG NUMBER 12IROOM_____



KEY MAP
NTS









DIVISION

- 830
- Water Dispenser
- Fire Extinguisher
- First Aid Kit
- Pull Station

ADDITIONS OR REVISIONS TO THIS FLOOR PLAN SHOULD BE MARKED UP AND RETURNED TO DIVISION 250 - ENTERPRISE INFORMATION MANAGEMENT. EGIS@OCS.D.COM





ORANGE COUNTY
SANITATION DISTRICT

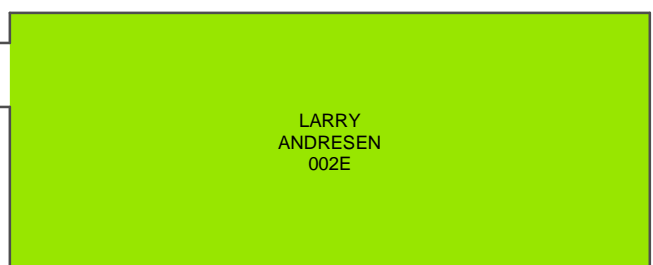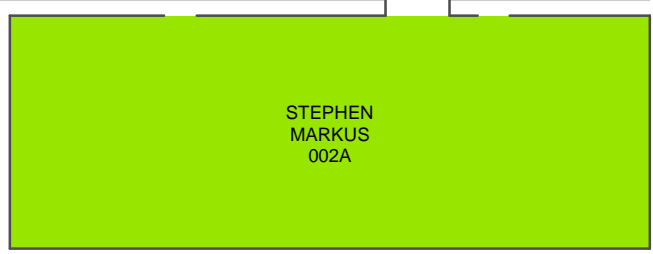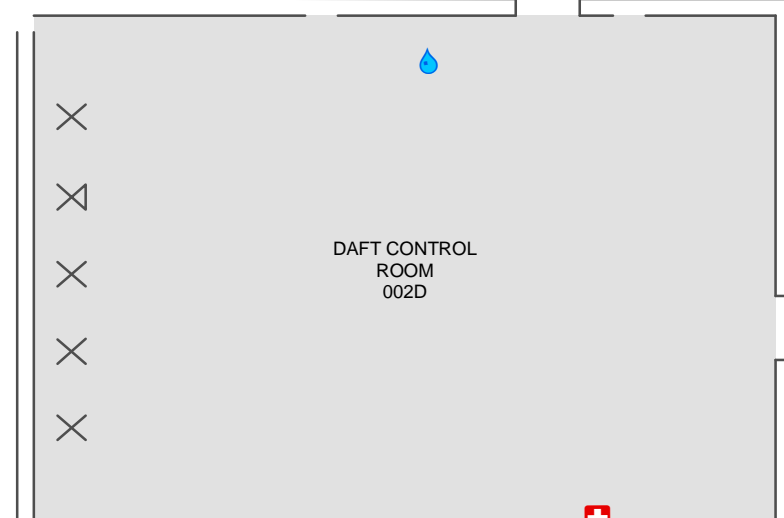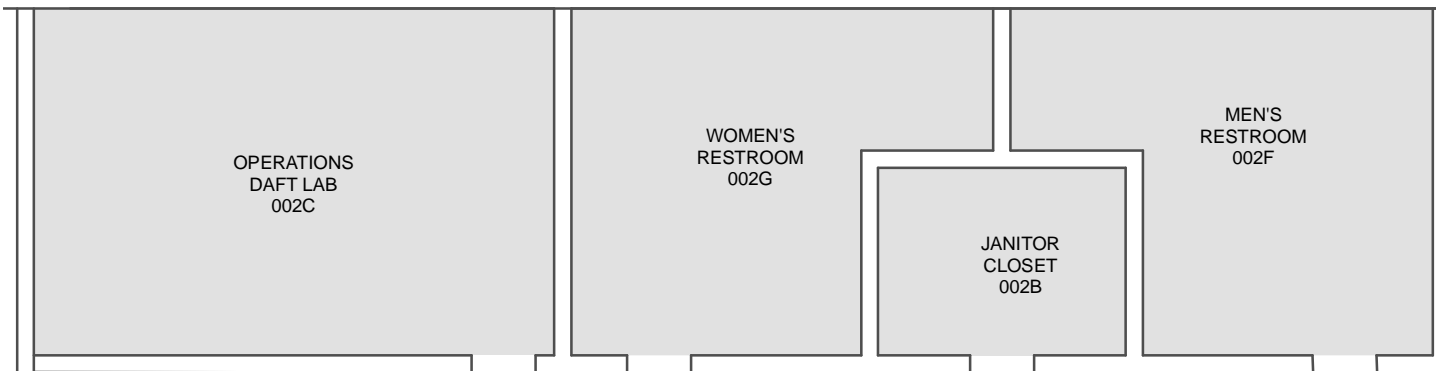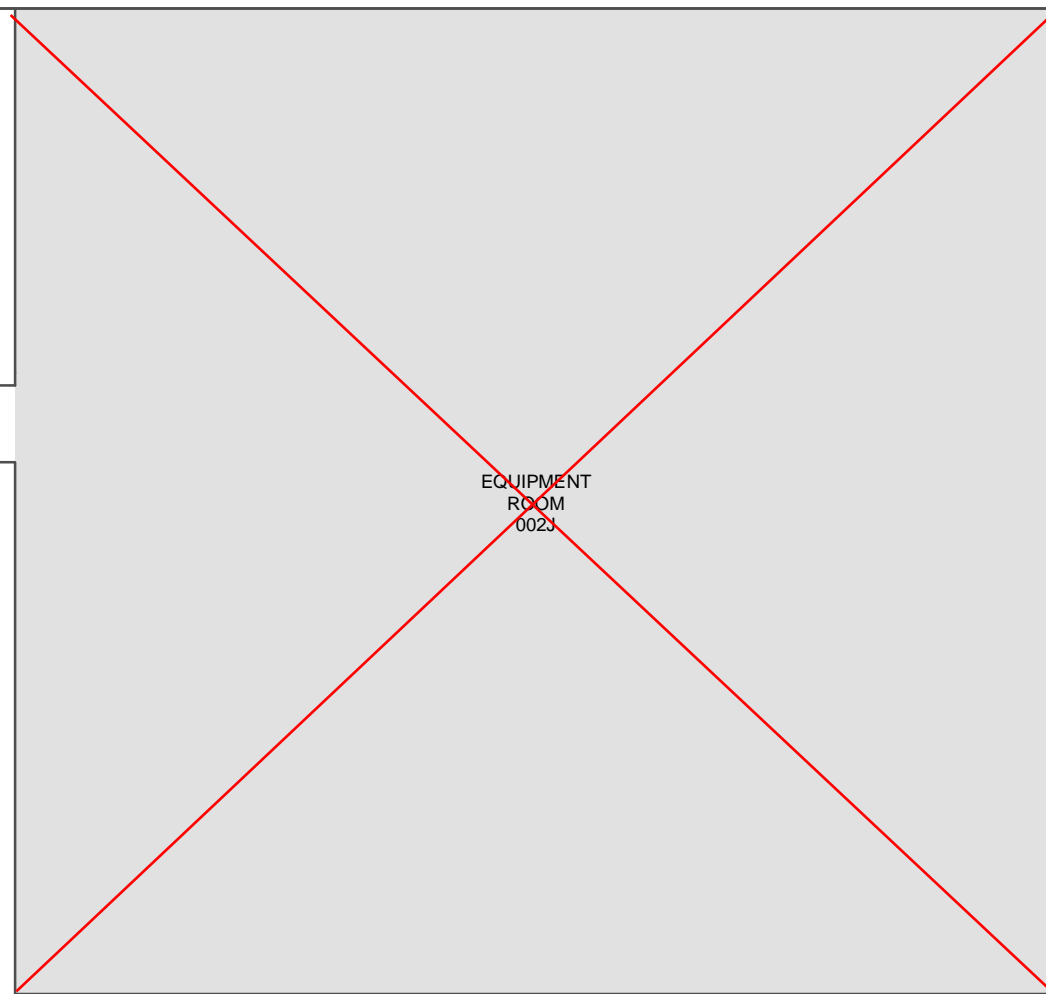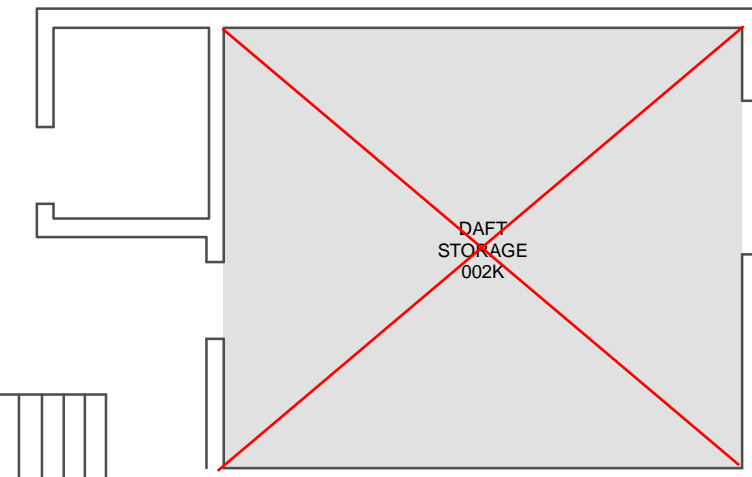

THICKENING & DEWATERING - FIRST FLOOR

LOOP TAG NUMBER 1__ROOM__

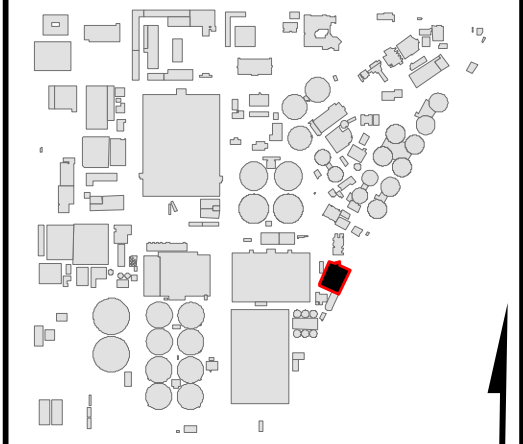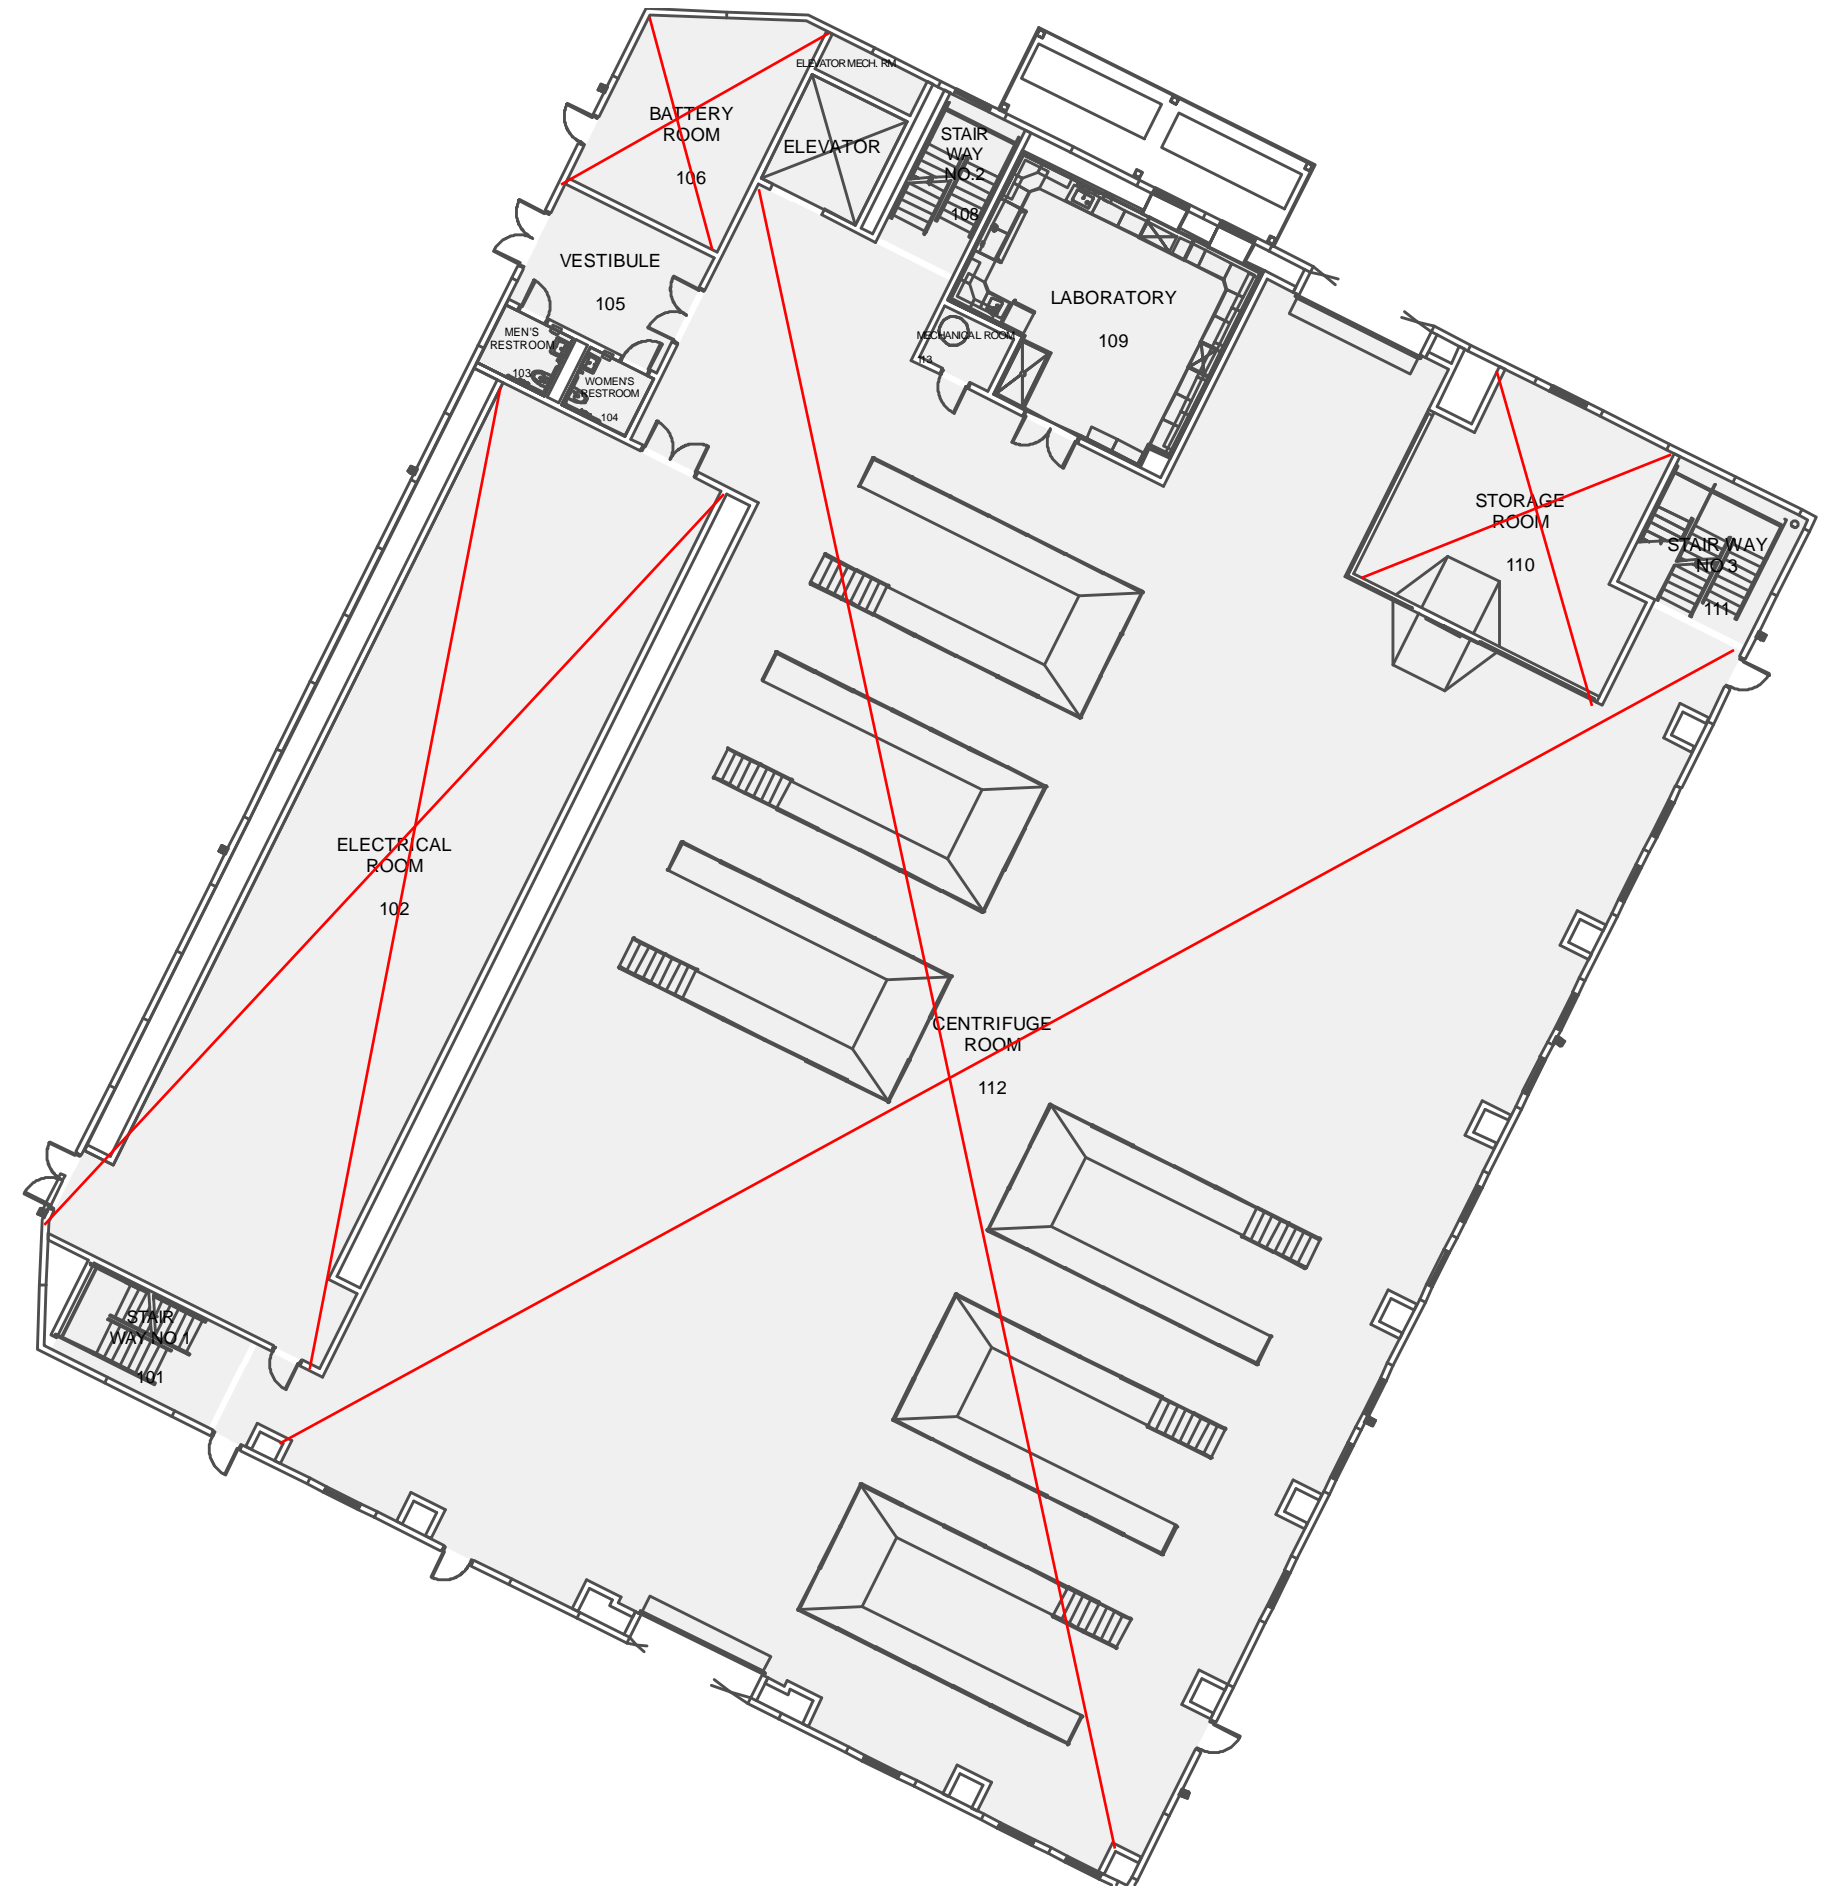

KEY MAP
NTS



DIVISION

110	610	820
120	620	822
140	630	830
160	710	870
161	740	875
210	750	
220	760	
230	770	
250	810	

ADDITIONS OR REVISIONS TO THIS FLOOR PLAN SHOULD BE MARKED UP AND RETURNED TO DIVISION 250 - ENTERPRISE INFORMATION MANAGEMENT. EGIS@OCS.D.COM





ORANGE COUNTY
SANITATION DISTRICT



THICKENING & DEWATERING - SECOND FLOOR

LOOP TAG NUMBER 1__ROOM__

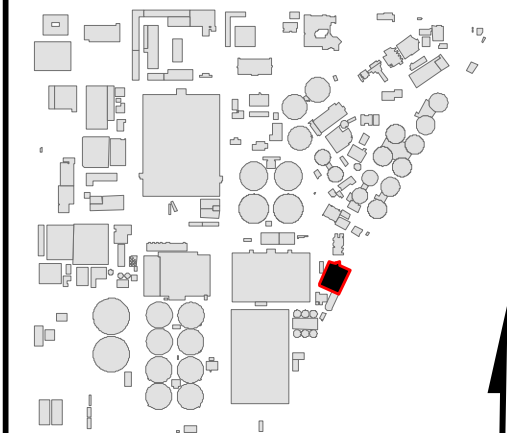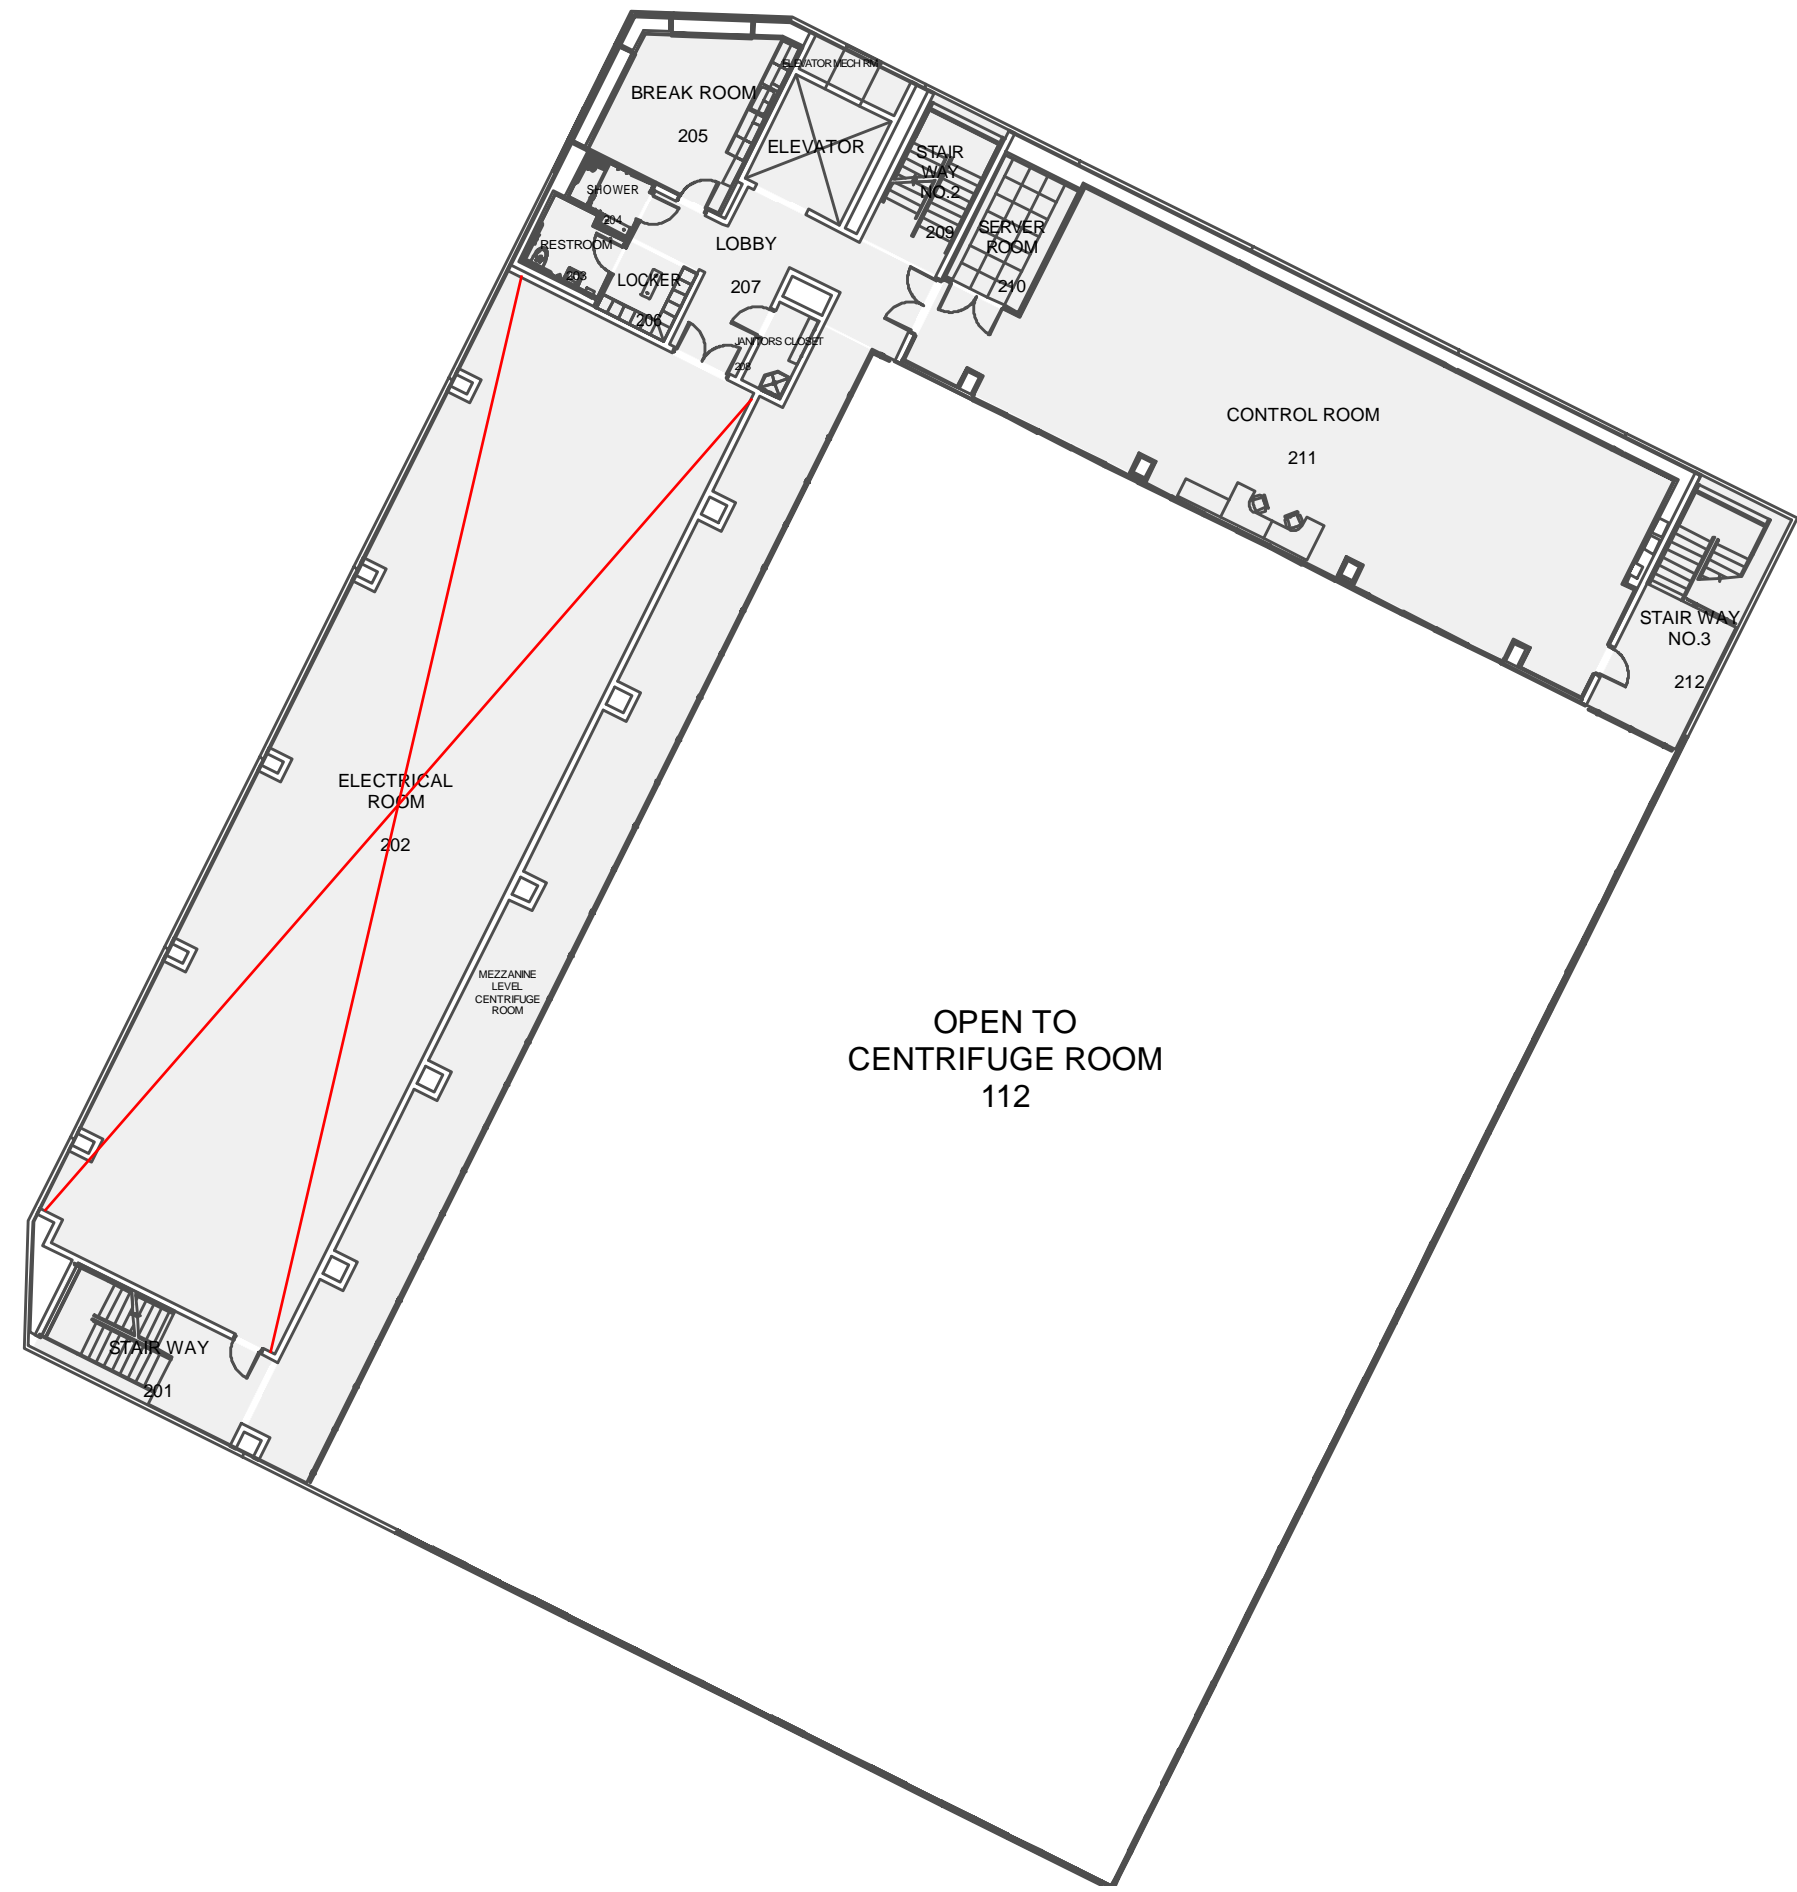

KEY MAP
NTS



DIVISION

110	610	820
120	620	822
140	630	830
160	710	870
161	740	875
210	750	
220	760	
230	770	
250	810	

ADDITIONS OR REVISIONS TO THIS FLOOR PLAN SHOULD BE MARKED UP AND RETURNED TO DIVISION 250 - ENTERPRISE INFORMATION MANAGEMENT. EGIS@OCS.D.COM



ORANGE COUNTY
SANITATION DISTRICT



ENGINEERING TRAILERS A & B

LOOP TAG NUMBER 19SROOM_____



KEY MAP
NTS

TRAILER A
19SSTRC001

TRAILER B
19SSTRC002



DIVISION

- 250
- 760
- 770
- Water Dispenser
- AED
- Fire Extinguisher
- First Aid Kit
- Pull Station

ADDITIONS OR REVISIONS TO THIS FLOOR PLAN SHOULD BE MARKED UP AND RETURNED TO DIVISION 250 - ENTERPRISE INFORMATION MANAGEMENT. EGIS@OCS.D.COM



ORANGE COUNTY
SANITATION DISTRICT

ENGINEERING TRAILERS E & F

LOOP TAG NUMBER 19SROOM _____



KEY MAP
NTS




TRAILER F
19SSTRC020



WALKWAY
DECKING

TRAILER E
19SSTRC017

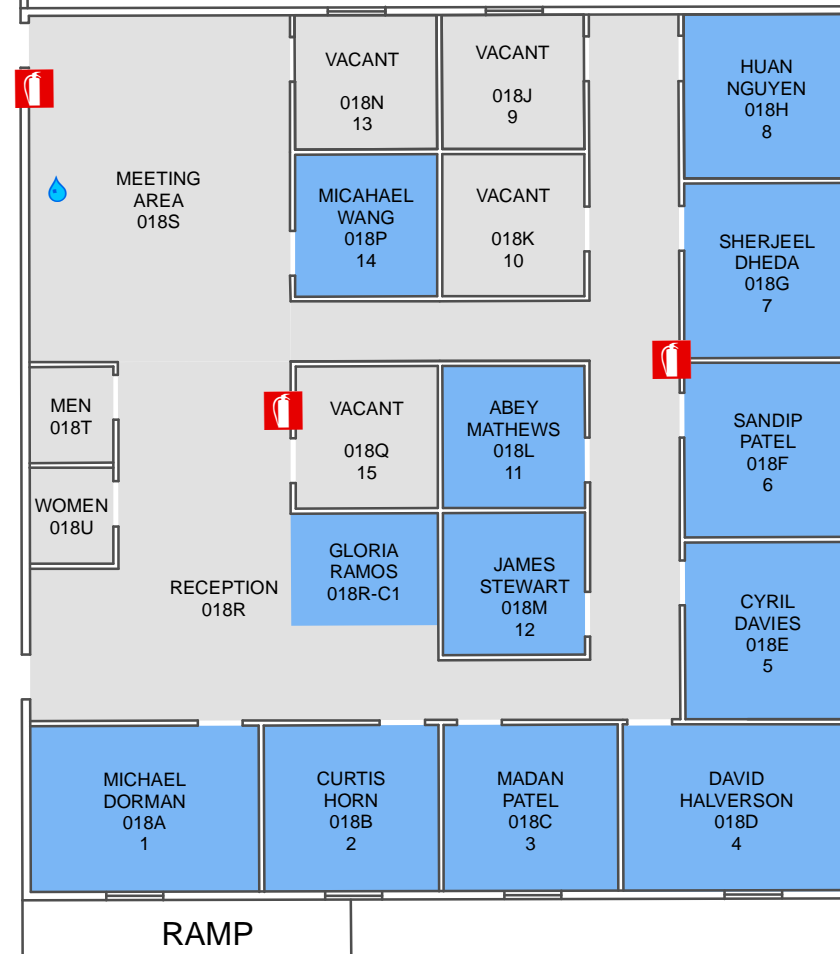


RAMP

DIVISION

- 161
- 230
- 760
- Water Dispenser
- Fire Extinguisher
- First Aid Kit
- Pull Station

ADDITIONS OR REVISIONS TO THIS FLOOR PLAN SHOULD BE MARKED UP AND RETURNED TO DIVISION 250 - ENTERPRISE INFORMATION MANAGEMENT. EGIS@OCSAN.COM



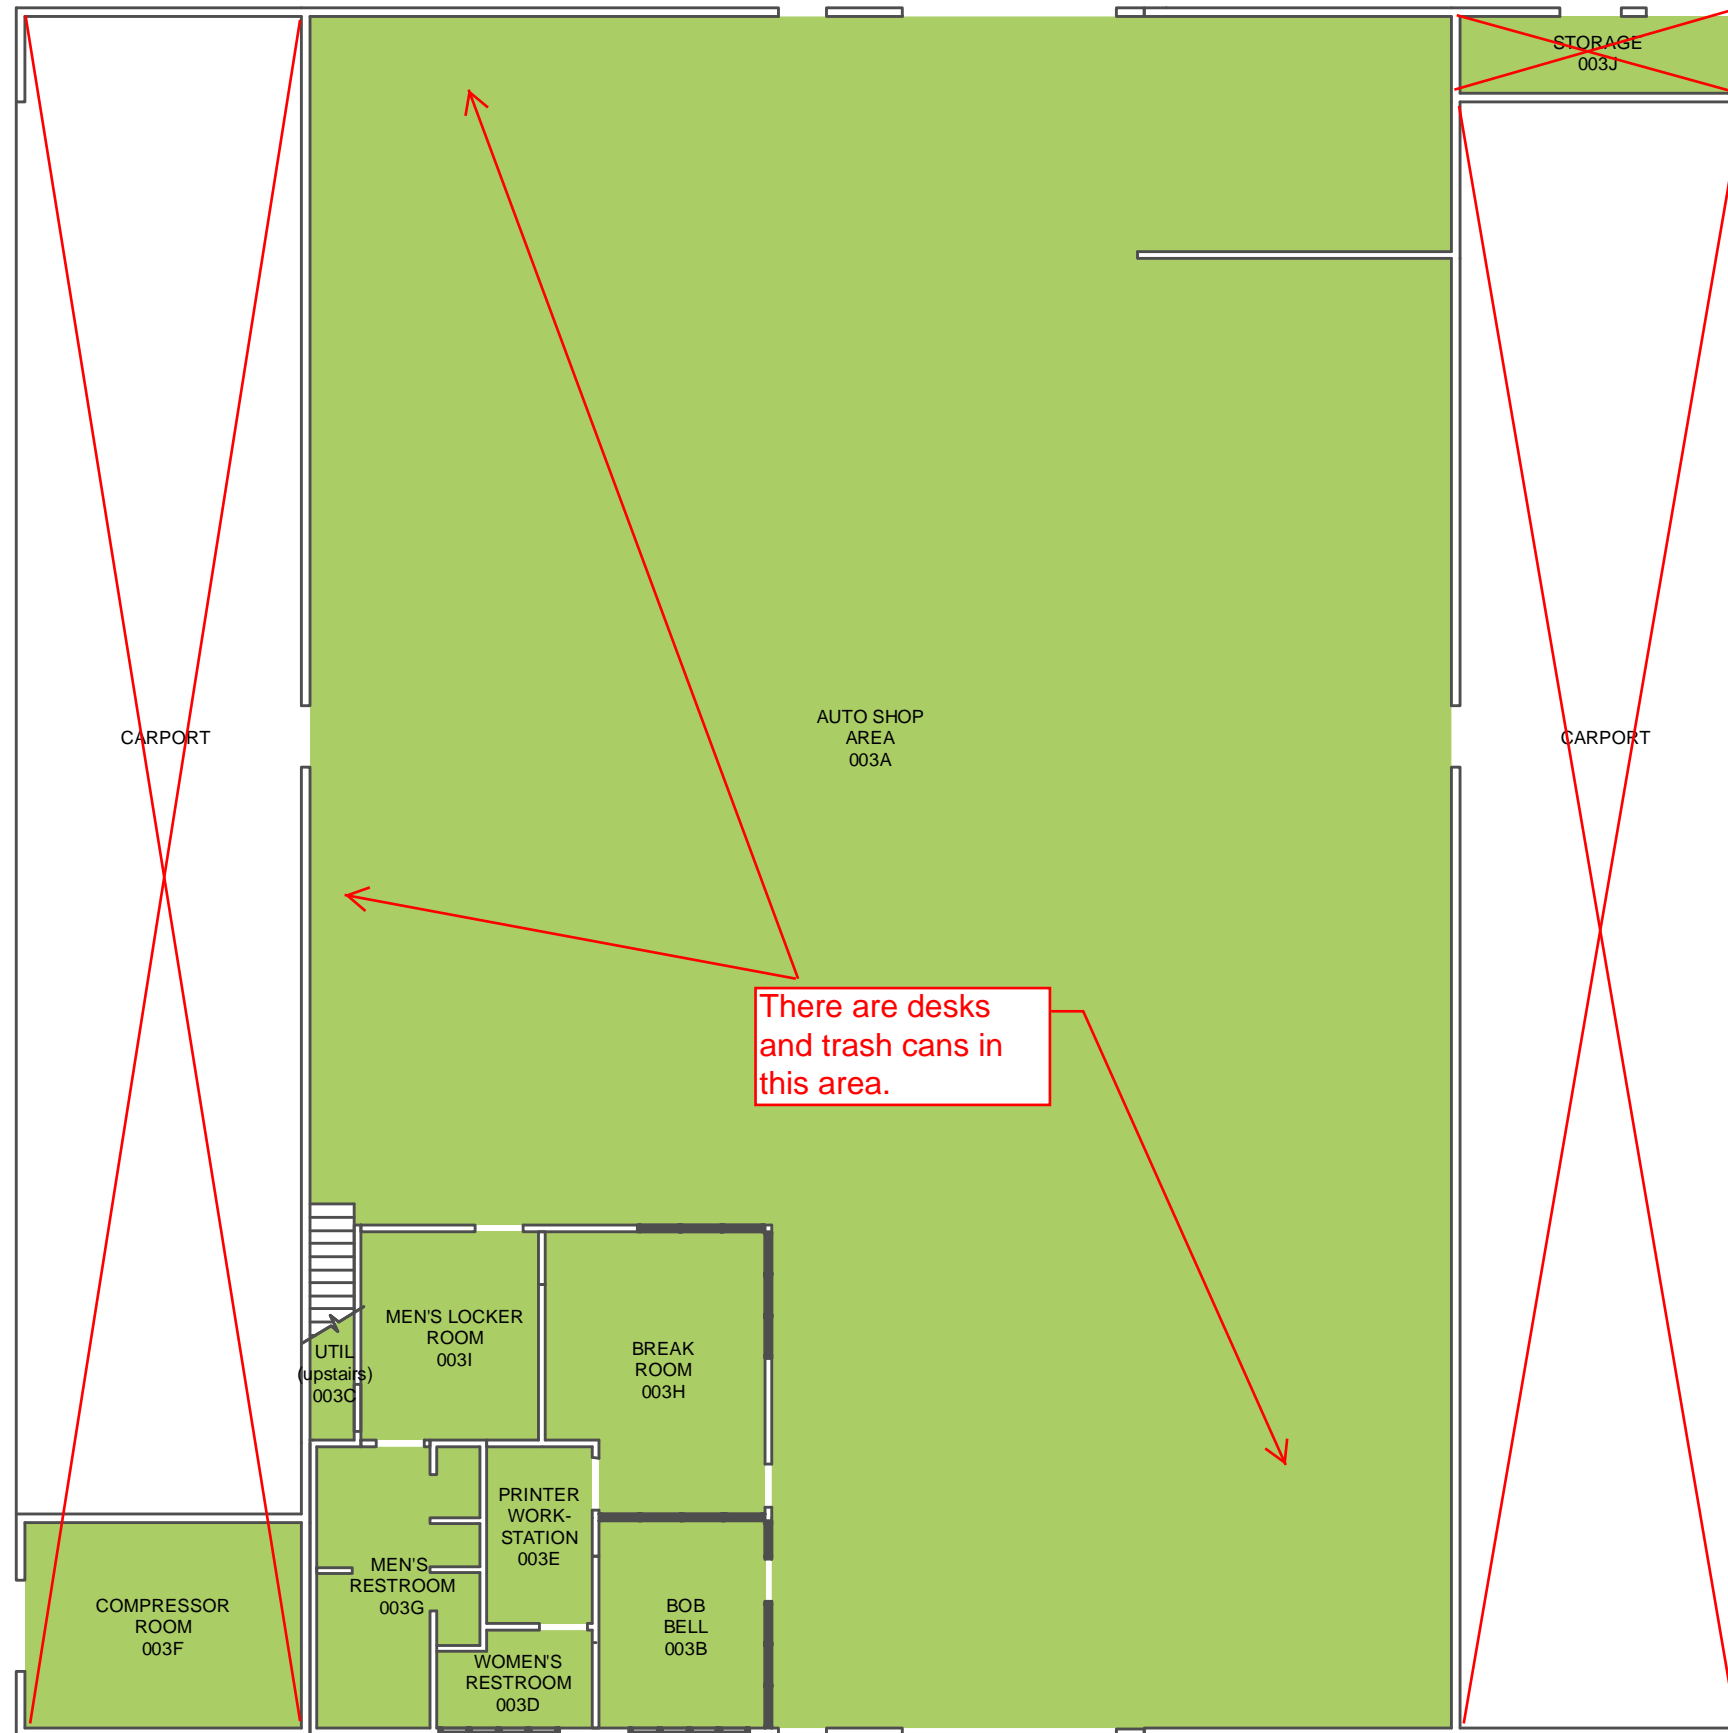

FLEET SERVICES

LOOP TAG NUMBER 19FROOM _____



KEY MAP
NTS

N

DIVISION

110	610	820
120	620	822
140	630	830
160	710	870
161	740	
210	750	
220	760	
230	770	
250	810	


ADDITIONS OR REVISIONS TO THIS FLOOR PLAN SHOULD BE MARKED UP AND RETURNED TO DIVISION 250 - ENTERPIRSE INFORMATION MANAGEMENT. EGIS@OCSD.COM



ORANGE COUNTY
SANITATION DISTRICT

N

19LSTRC001

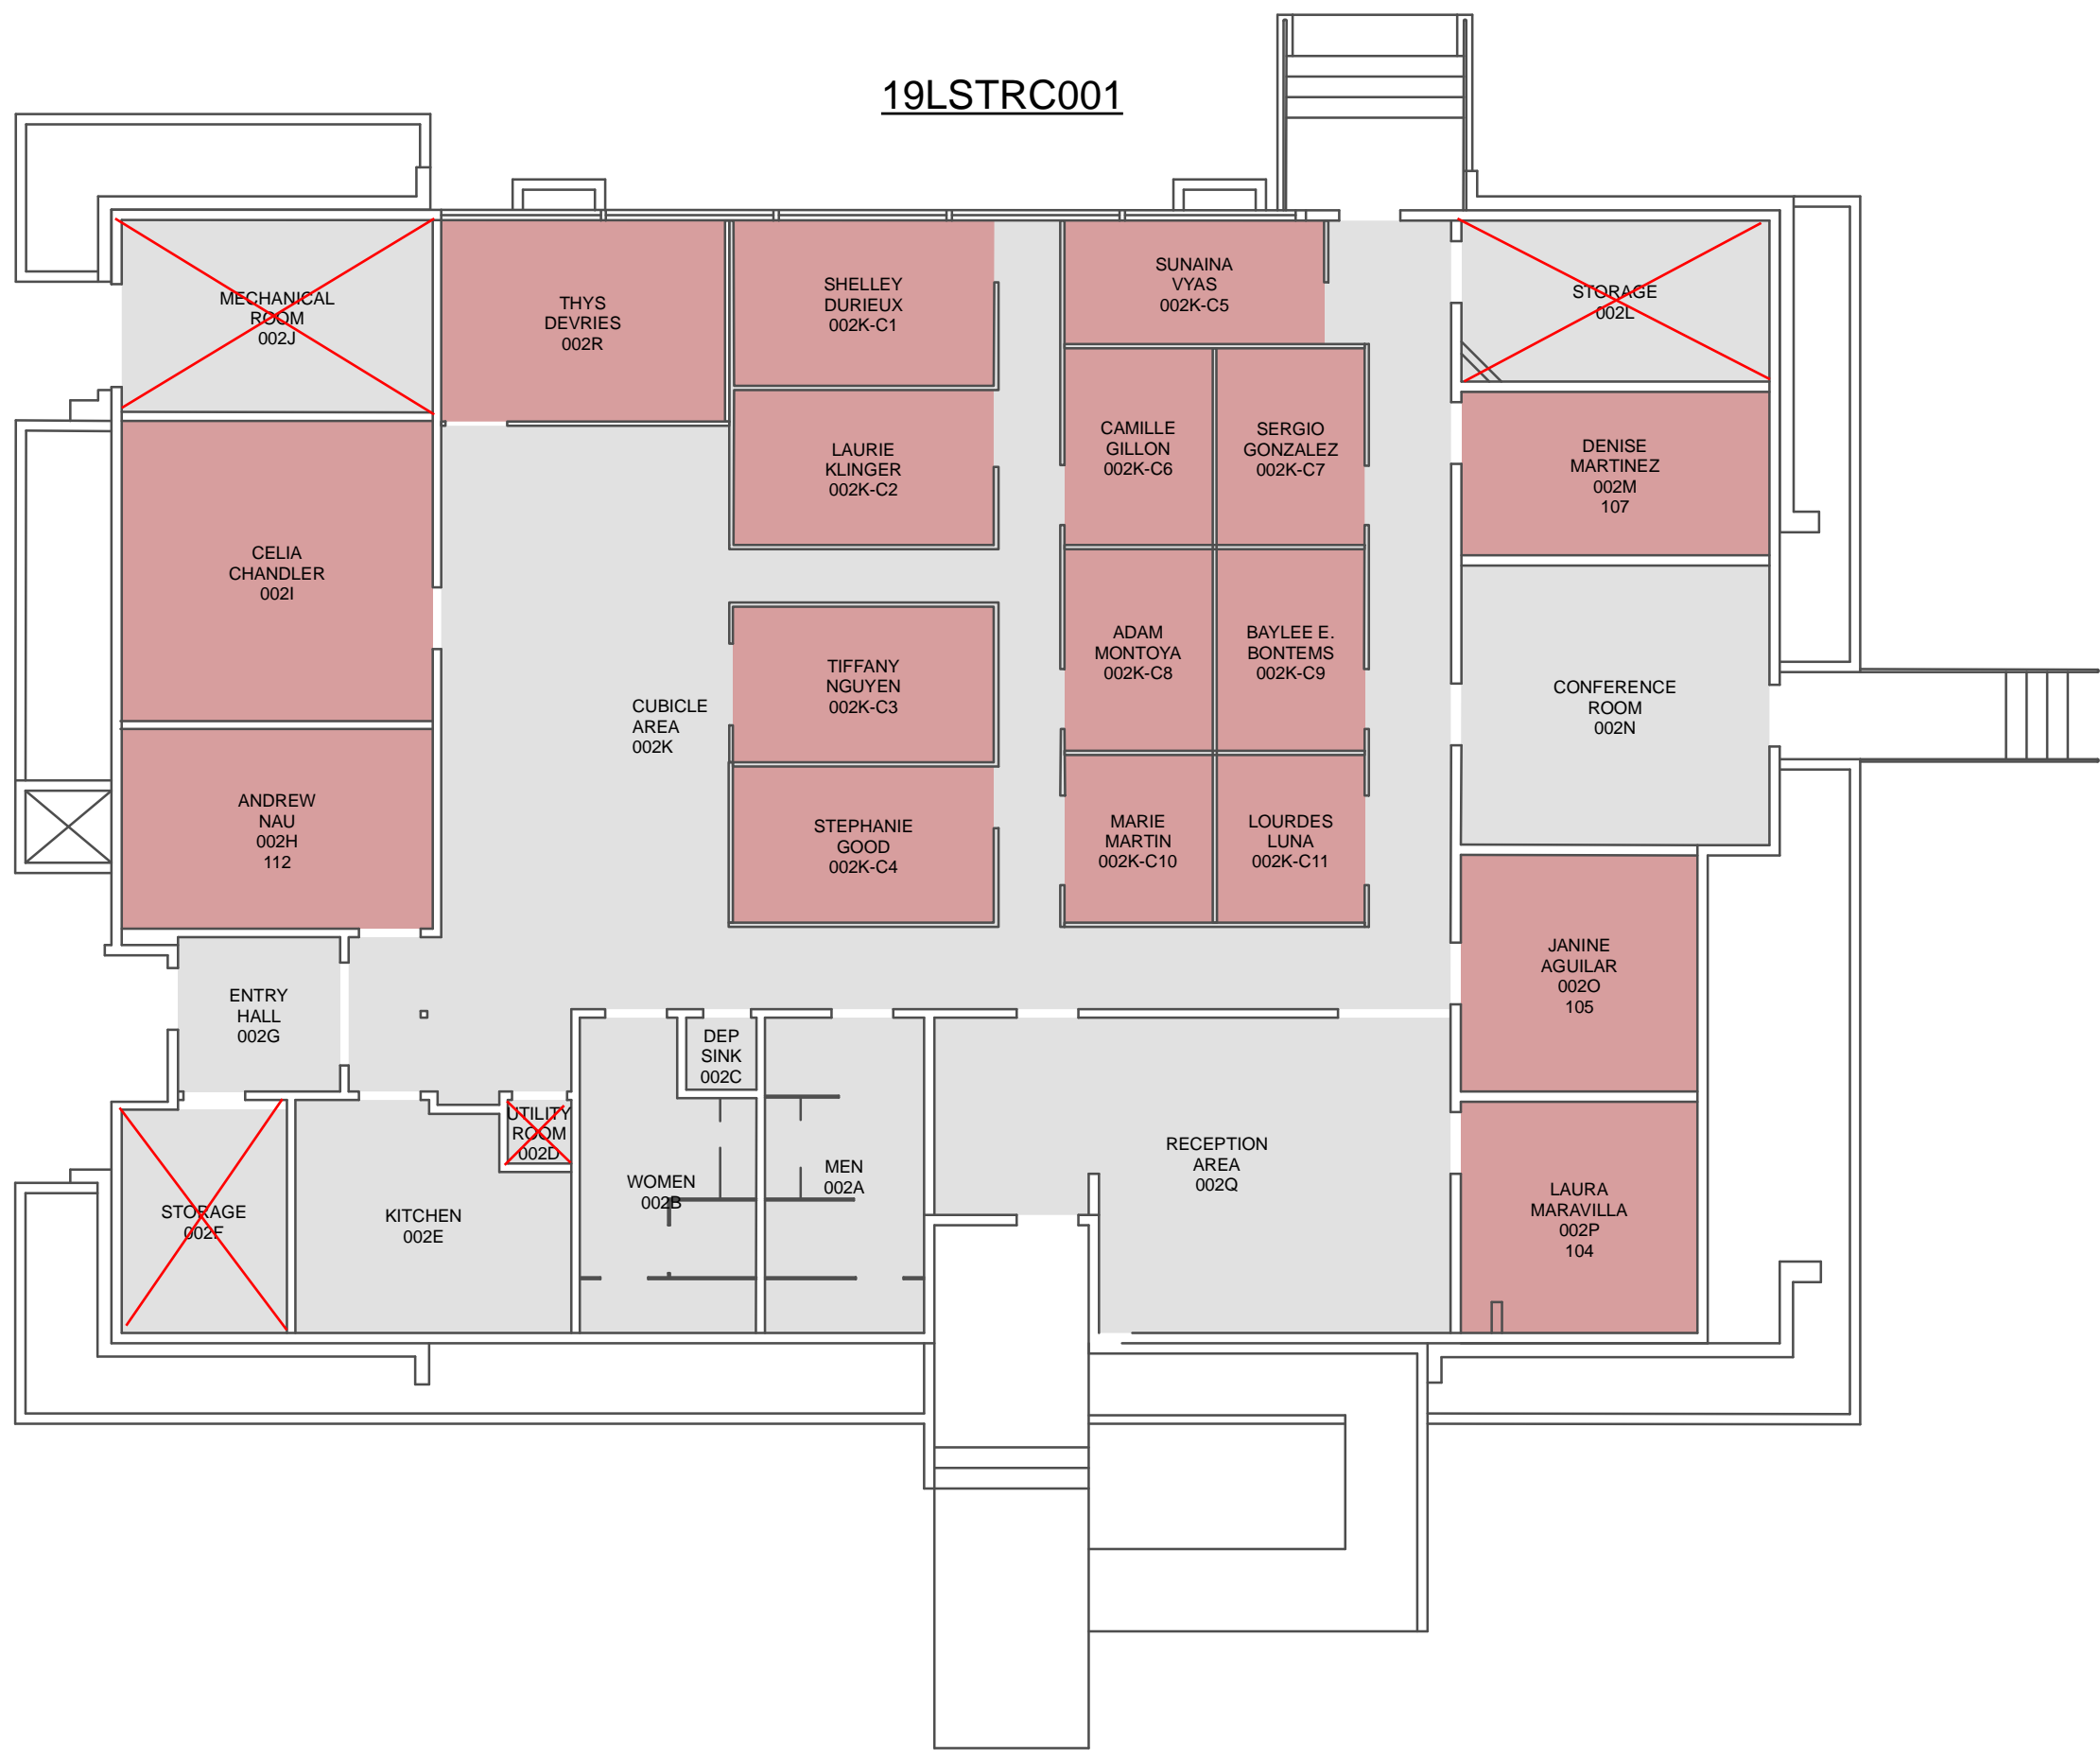

HUMAN RESOURCES

LOOP TAG NUMBER 19LROOM _____



KEY MAP
NTS



DIVISION

110	610	820
120	620	822
140	630	830
160	710	870
161	740	875
210	750	
220	760	
230	770	
250	810	

ADDITIONS OR REVISIONS TO THIS FLOOR PLAN SHOULD BE MARKED UP AND RETURNED TO DIVISION 250 - ENTERPRISE INFORMATION MANAGEMENT. EGIS@OCSD.COM




ORANGE COUNTY
SANITATION DISTRICT



LABORATORY - FIRST FLOOR

LOOP TAG NUMBER 19CROOM_____

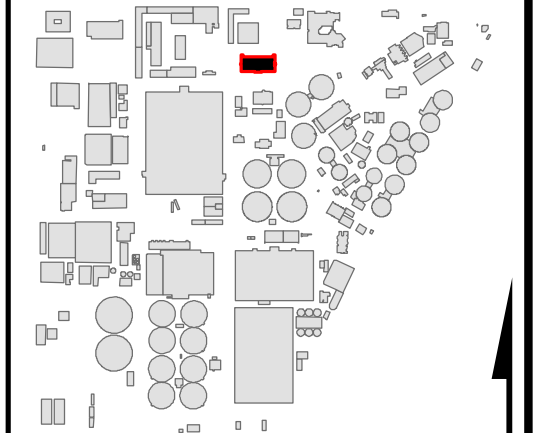

KEY MAP
NTS




DIVISION		
110	620	830
120	630	870
140	710	875
160	740	
161	750	
210	760	
220	770	
230	810	
250	820	
610	822	

ADDITIONS OR REVISIONS TO THIS FLOOR PLAN SHOULD BE MARKED UP AND RETURNED TO DIVISION 250 - ENTERPRISE INFORMATION MANAGEMENT. EGIS@OCSD.COM




ORANGE COUNTY
SANITATION DISTRICT

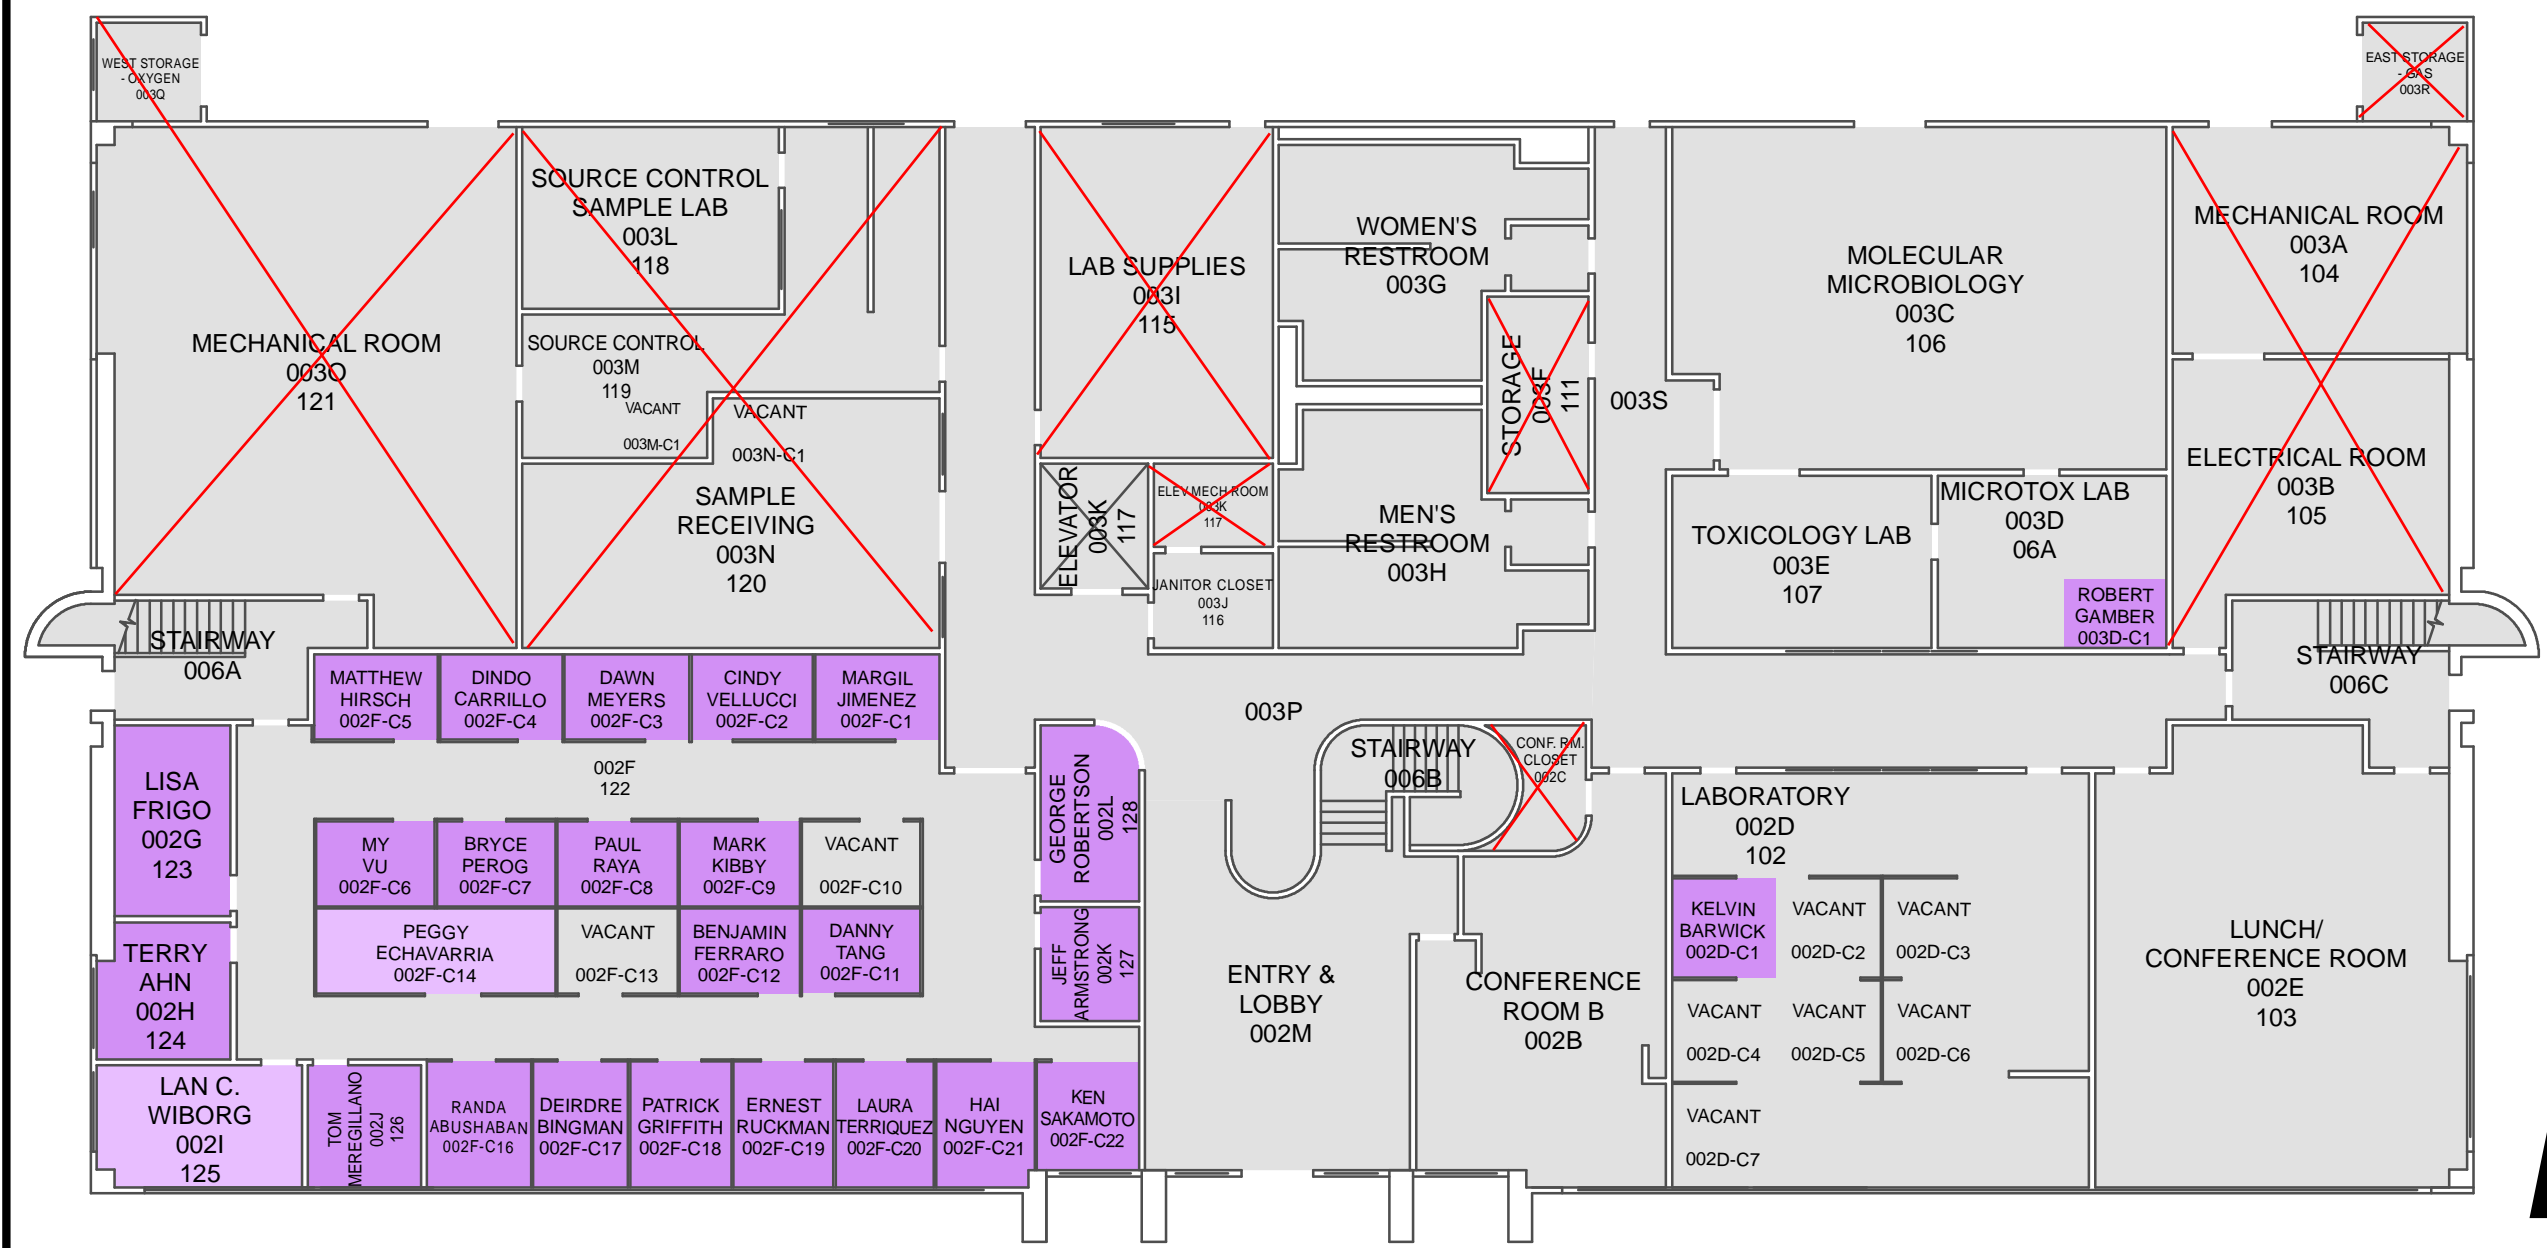

19CSTRC001


LABORATORY - SECOND FLOOR

LOOP TAG NUMBER 19CROOM_____

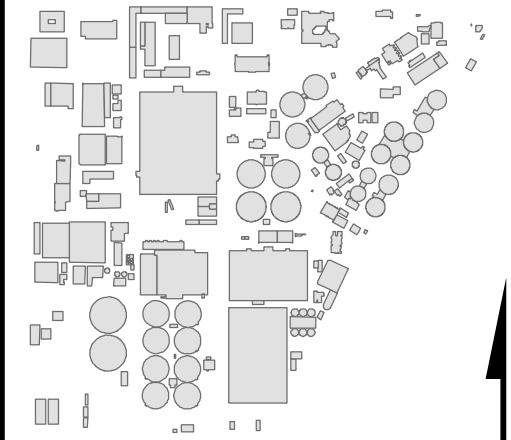

KEY MAP
NTS

N

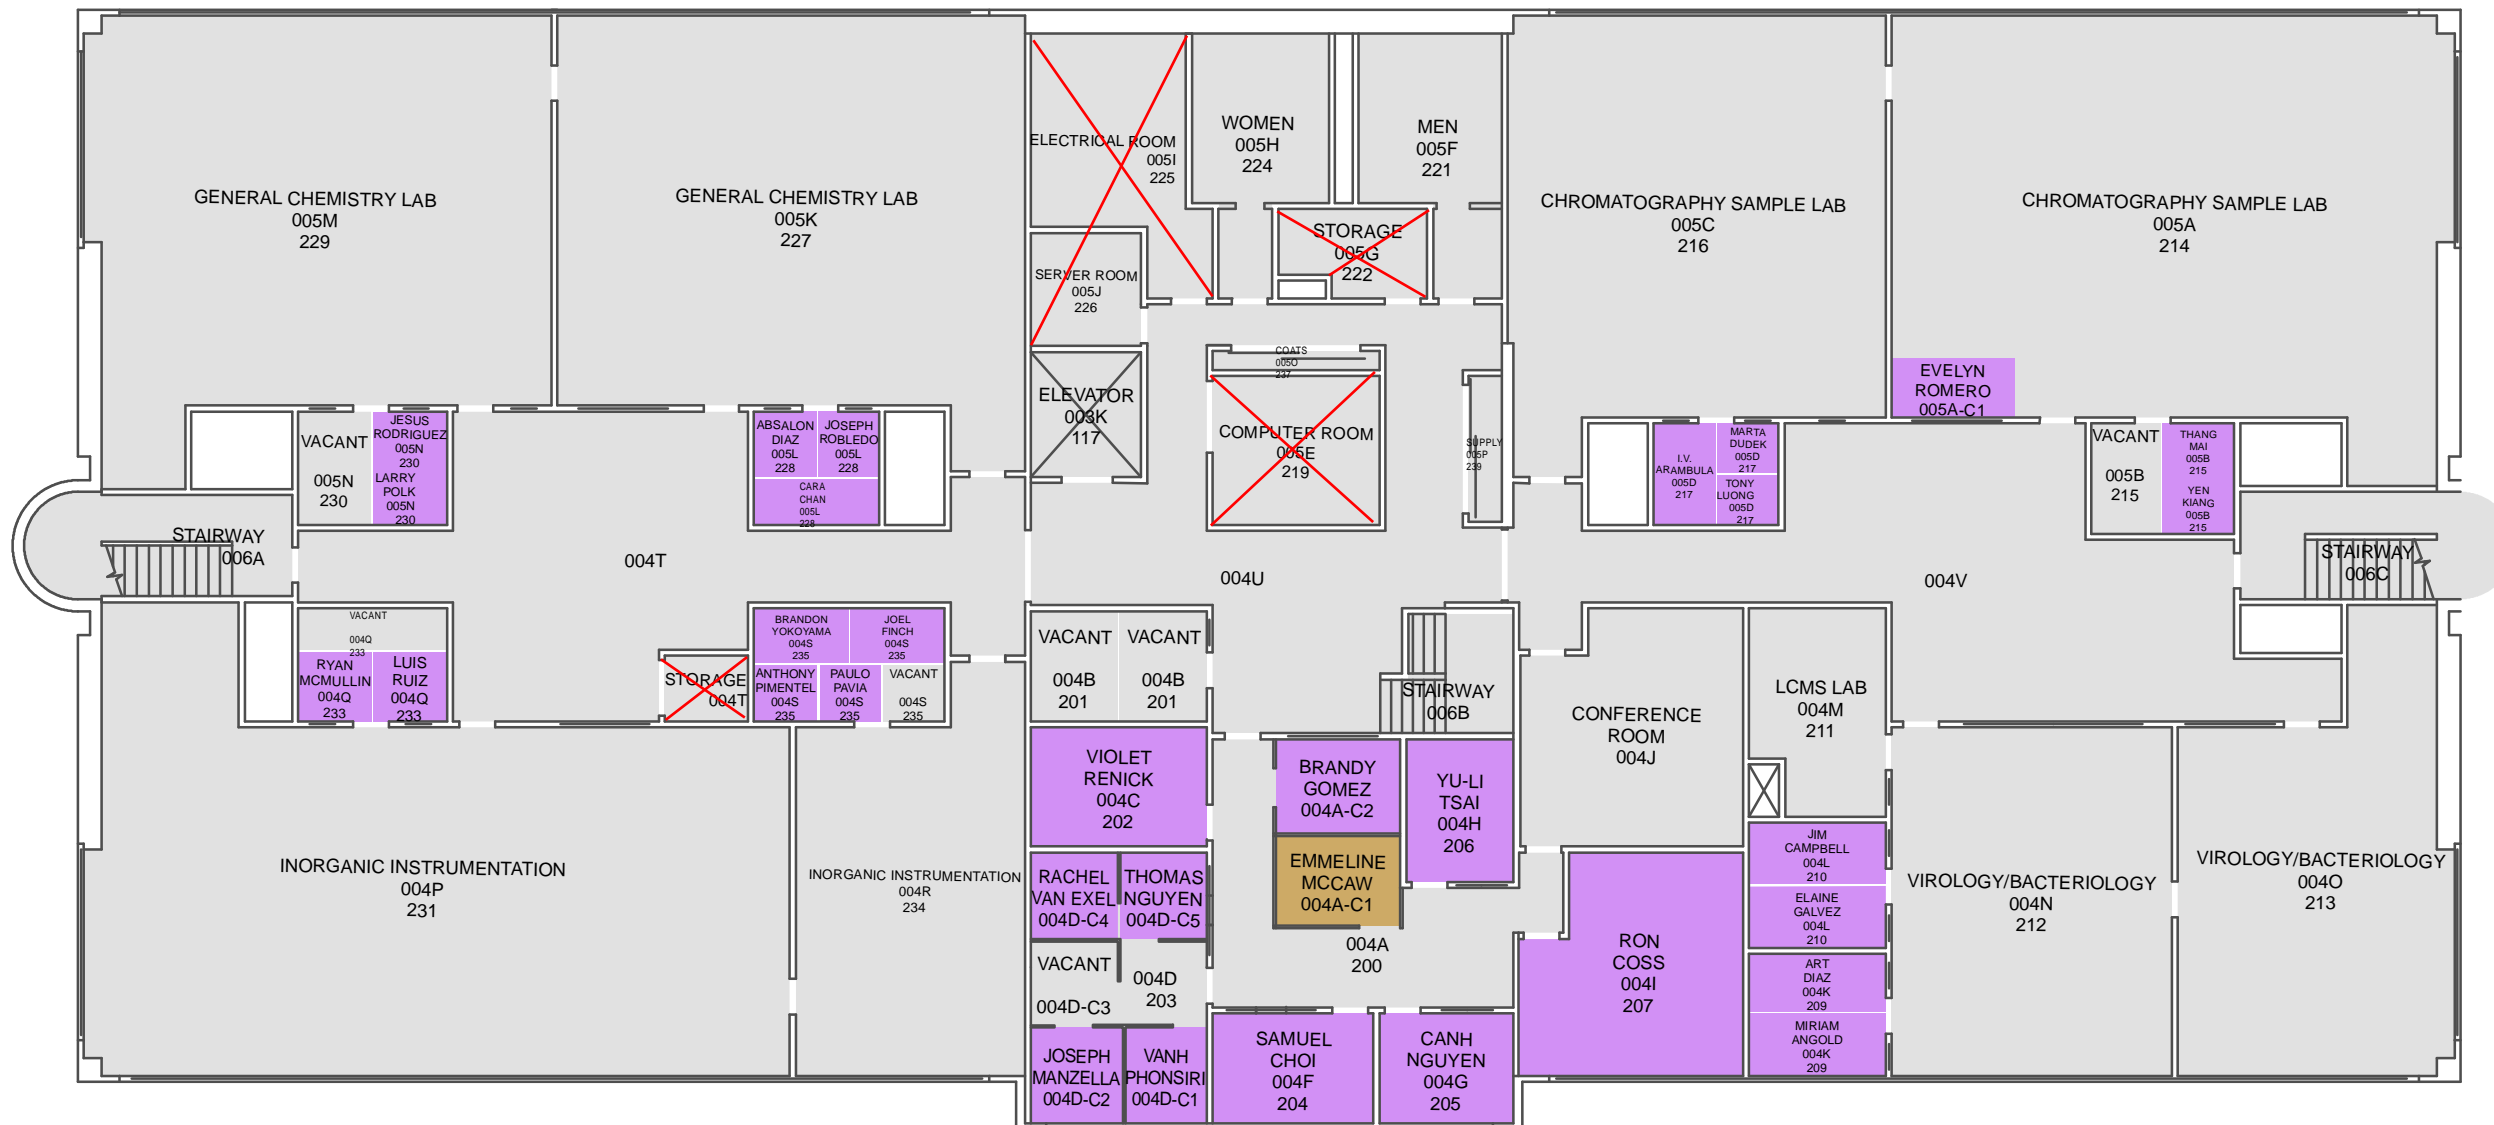

DIVISION

110	620	830
120	630	870
140	710	875
160	740	
161	750	
210	760	
220	770	
230	810	
250	820	
610	822	

ADDITIONS OR REVISIONS TO THIS FLOOR PLAN SHOULD BE MARKED UP AND RETURNED TO DIVISION 250 - ENTERPRISE INFORMATION MANAGEMENT. EGIS@OCSD.COM




ORANGE COUNTY
SANITATION DISTRICT

N

PURCHASING & WAREHOUSE - FIRST FLOOR

LOOP TAG NUMBER 19JROOM _____

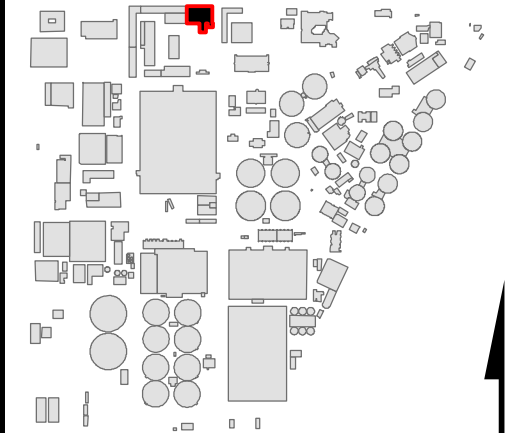

KEY MAP
NTS

N

DIVISION


110	610	820
120	620	822
140	630	830
160	710	870
161	740	
210	750	
220	760	
230	770	
250	810	

ADDITIONS OR REVISIONS TO THIS FLOOR PLAN SHOULD BE MARKED UP AND RETURNED TO DIVISION 250 - ENTERPRISE INFORMATION MANAGEMENT. EGIS@OCS.D.COM



ORANGE COUNTY
SANITATION DISTRICT

N

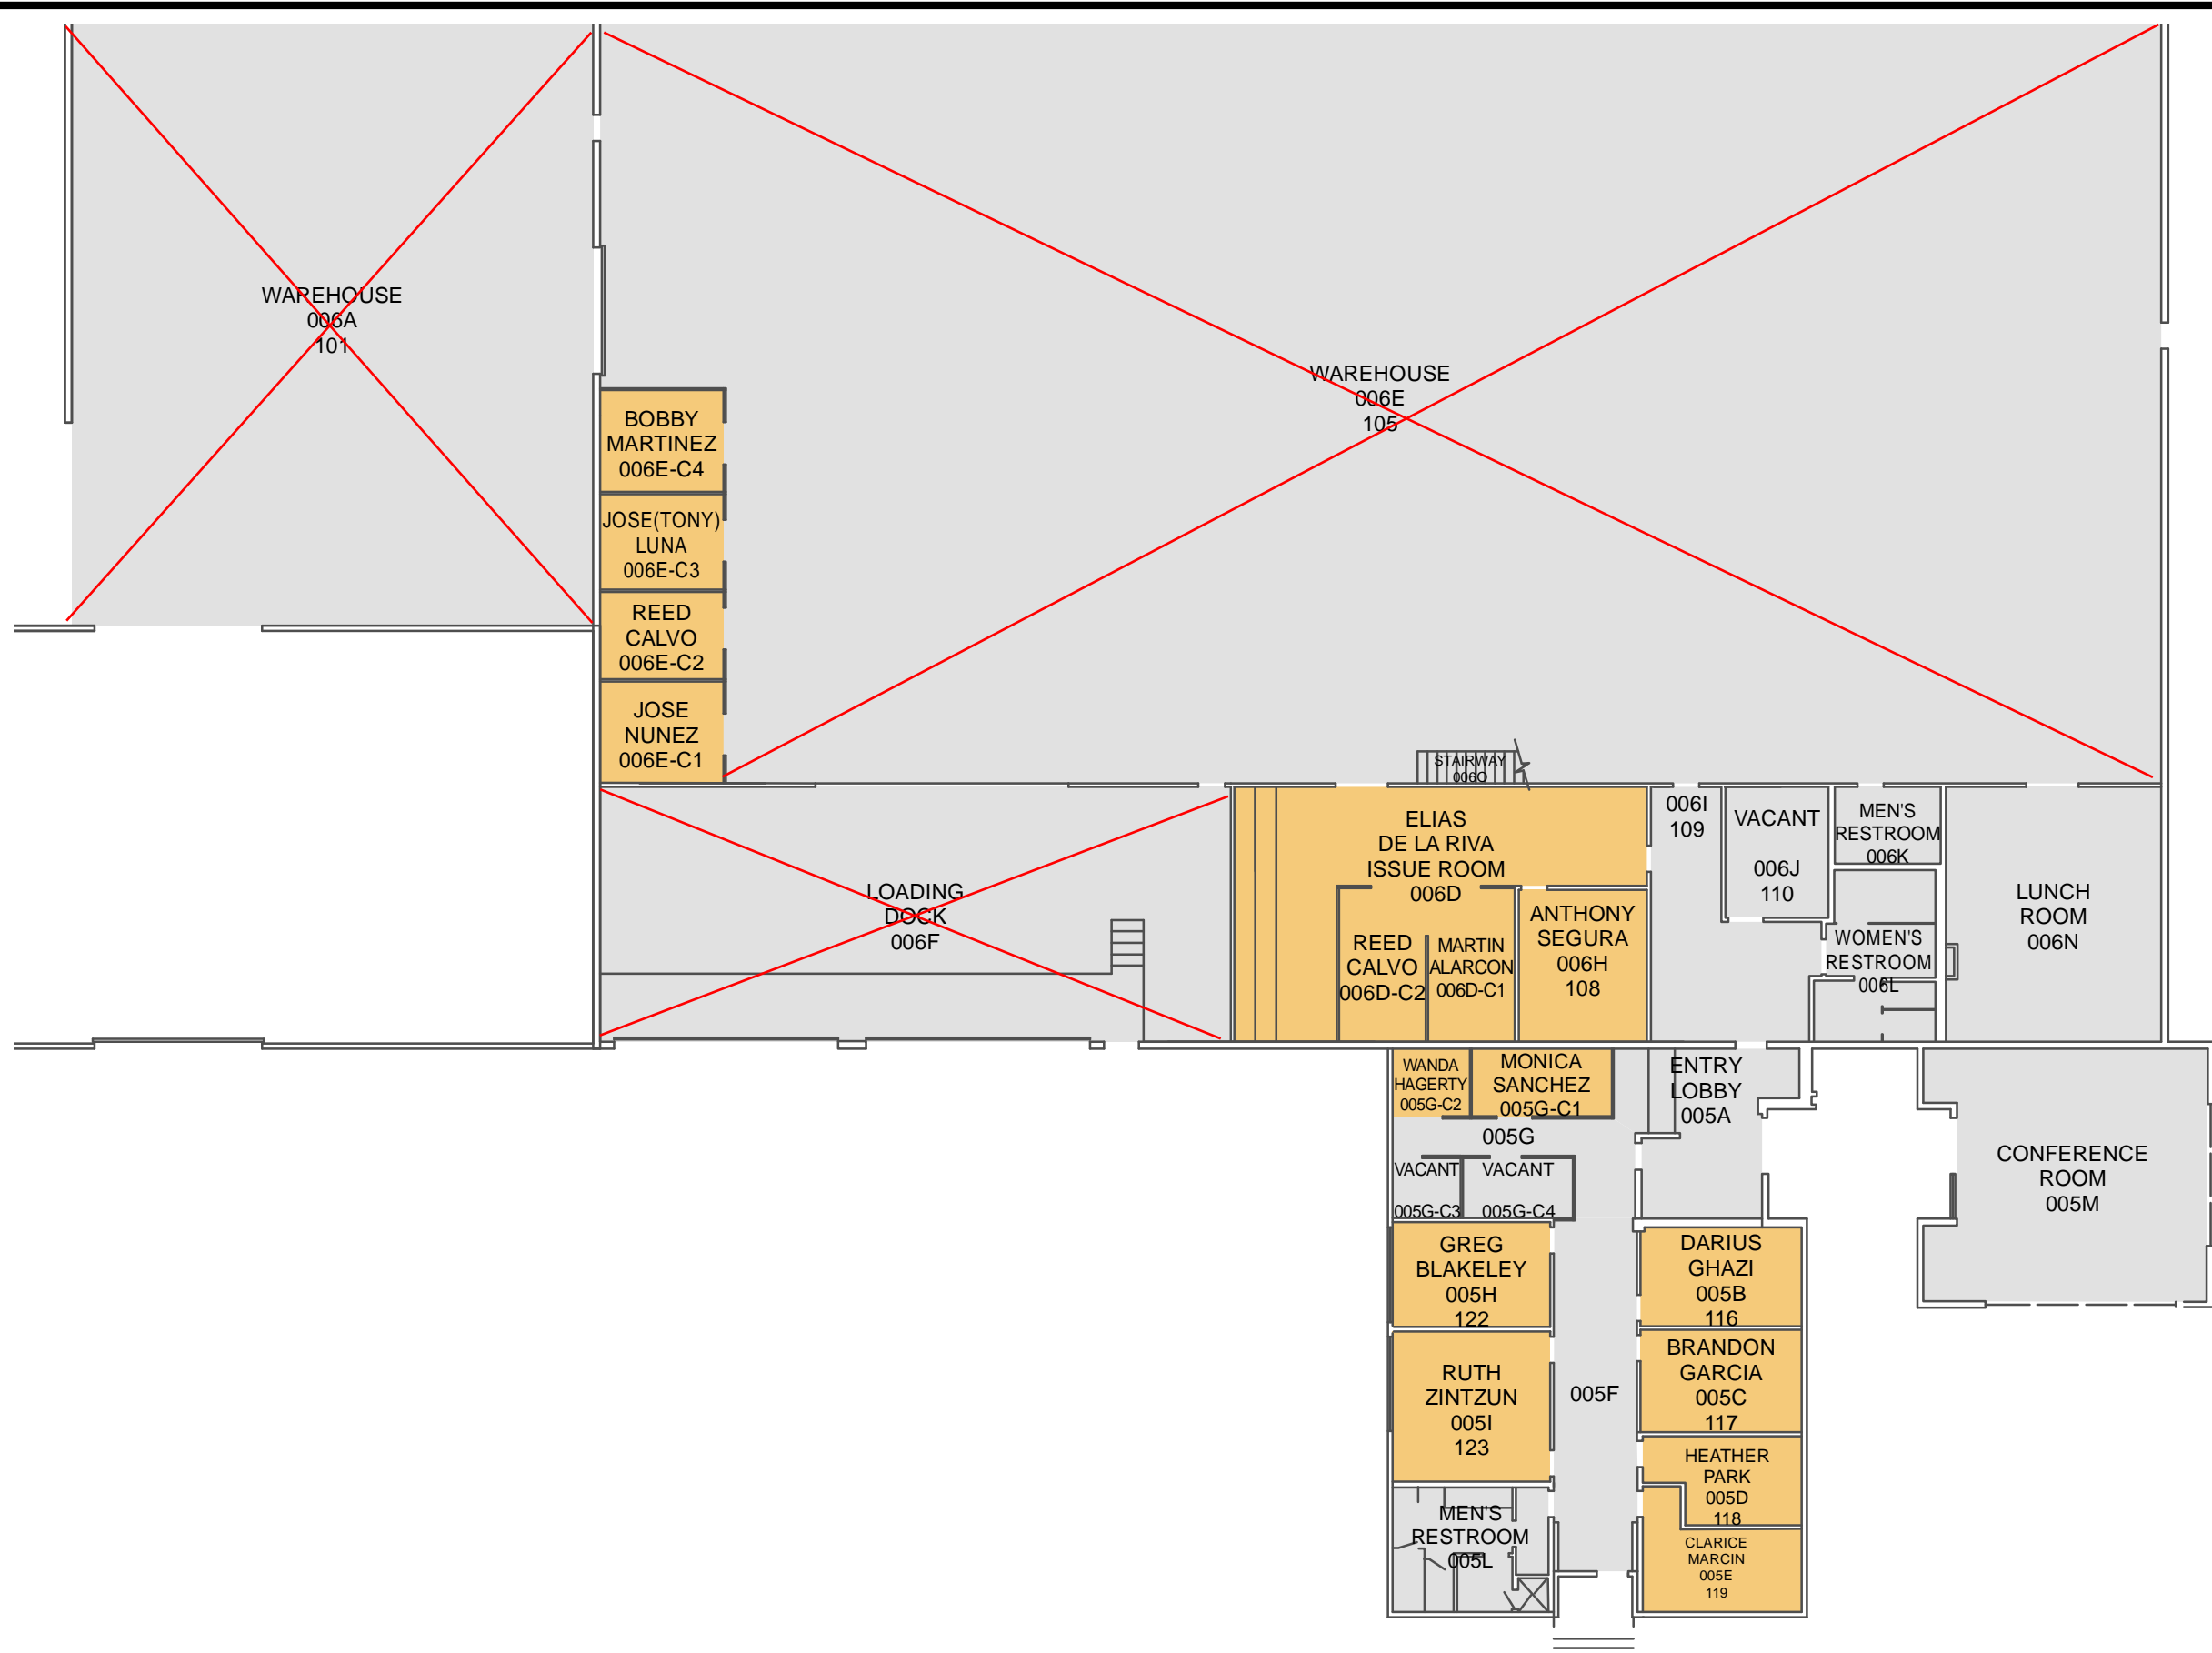

SOLIDS STORAGE/ TRUCK LOADING - SECOND FLOOR

LOOP TAG NUMBER 15JROOM_____



KEY MAP
NTS




DIVISION


110	610	820
120	620	822
140	630	830
160	710	870
161	740	875
210	750	
220	760	
230	770	
250	810	

ADDITIONS OR REVISIONS TO THIS FLOOR PLAN
SHOULD BE MARKED UP AND RETURNED TO
DIVISION 250 - ENTERPRISE INFORMATION
MANAGEMENT. EGIS@OCS.D.COM



ORANGE COUNTY
SANITATION DISTRICT

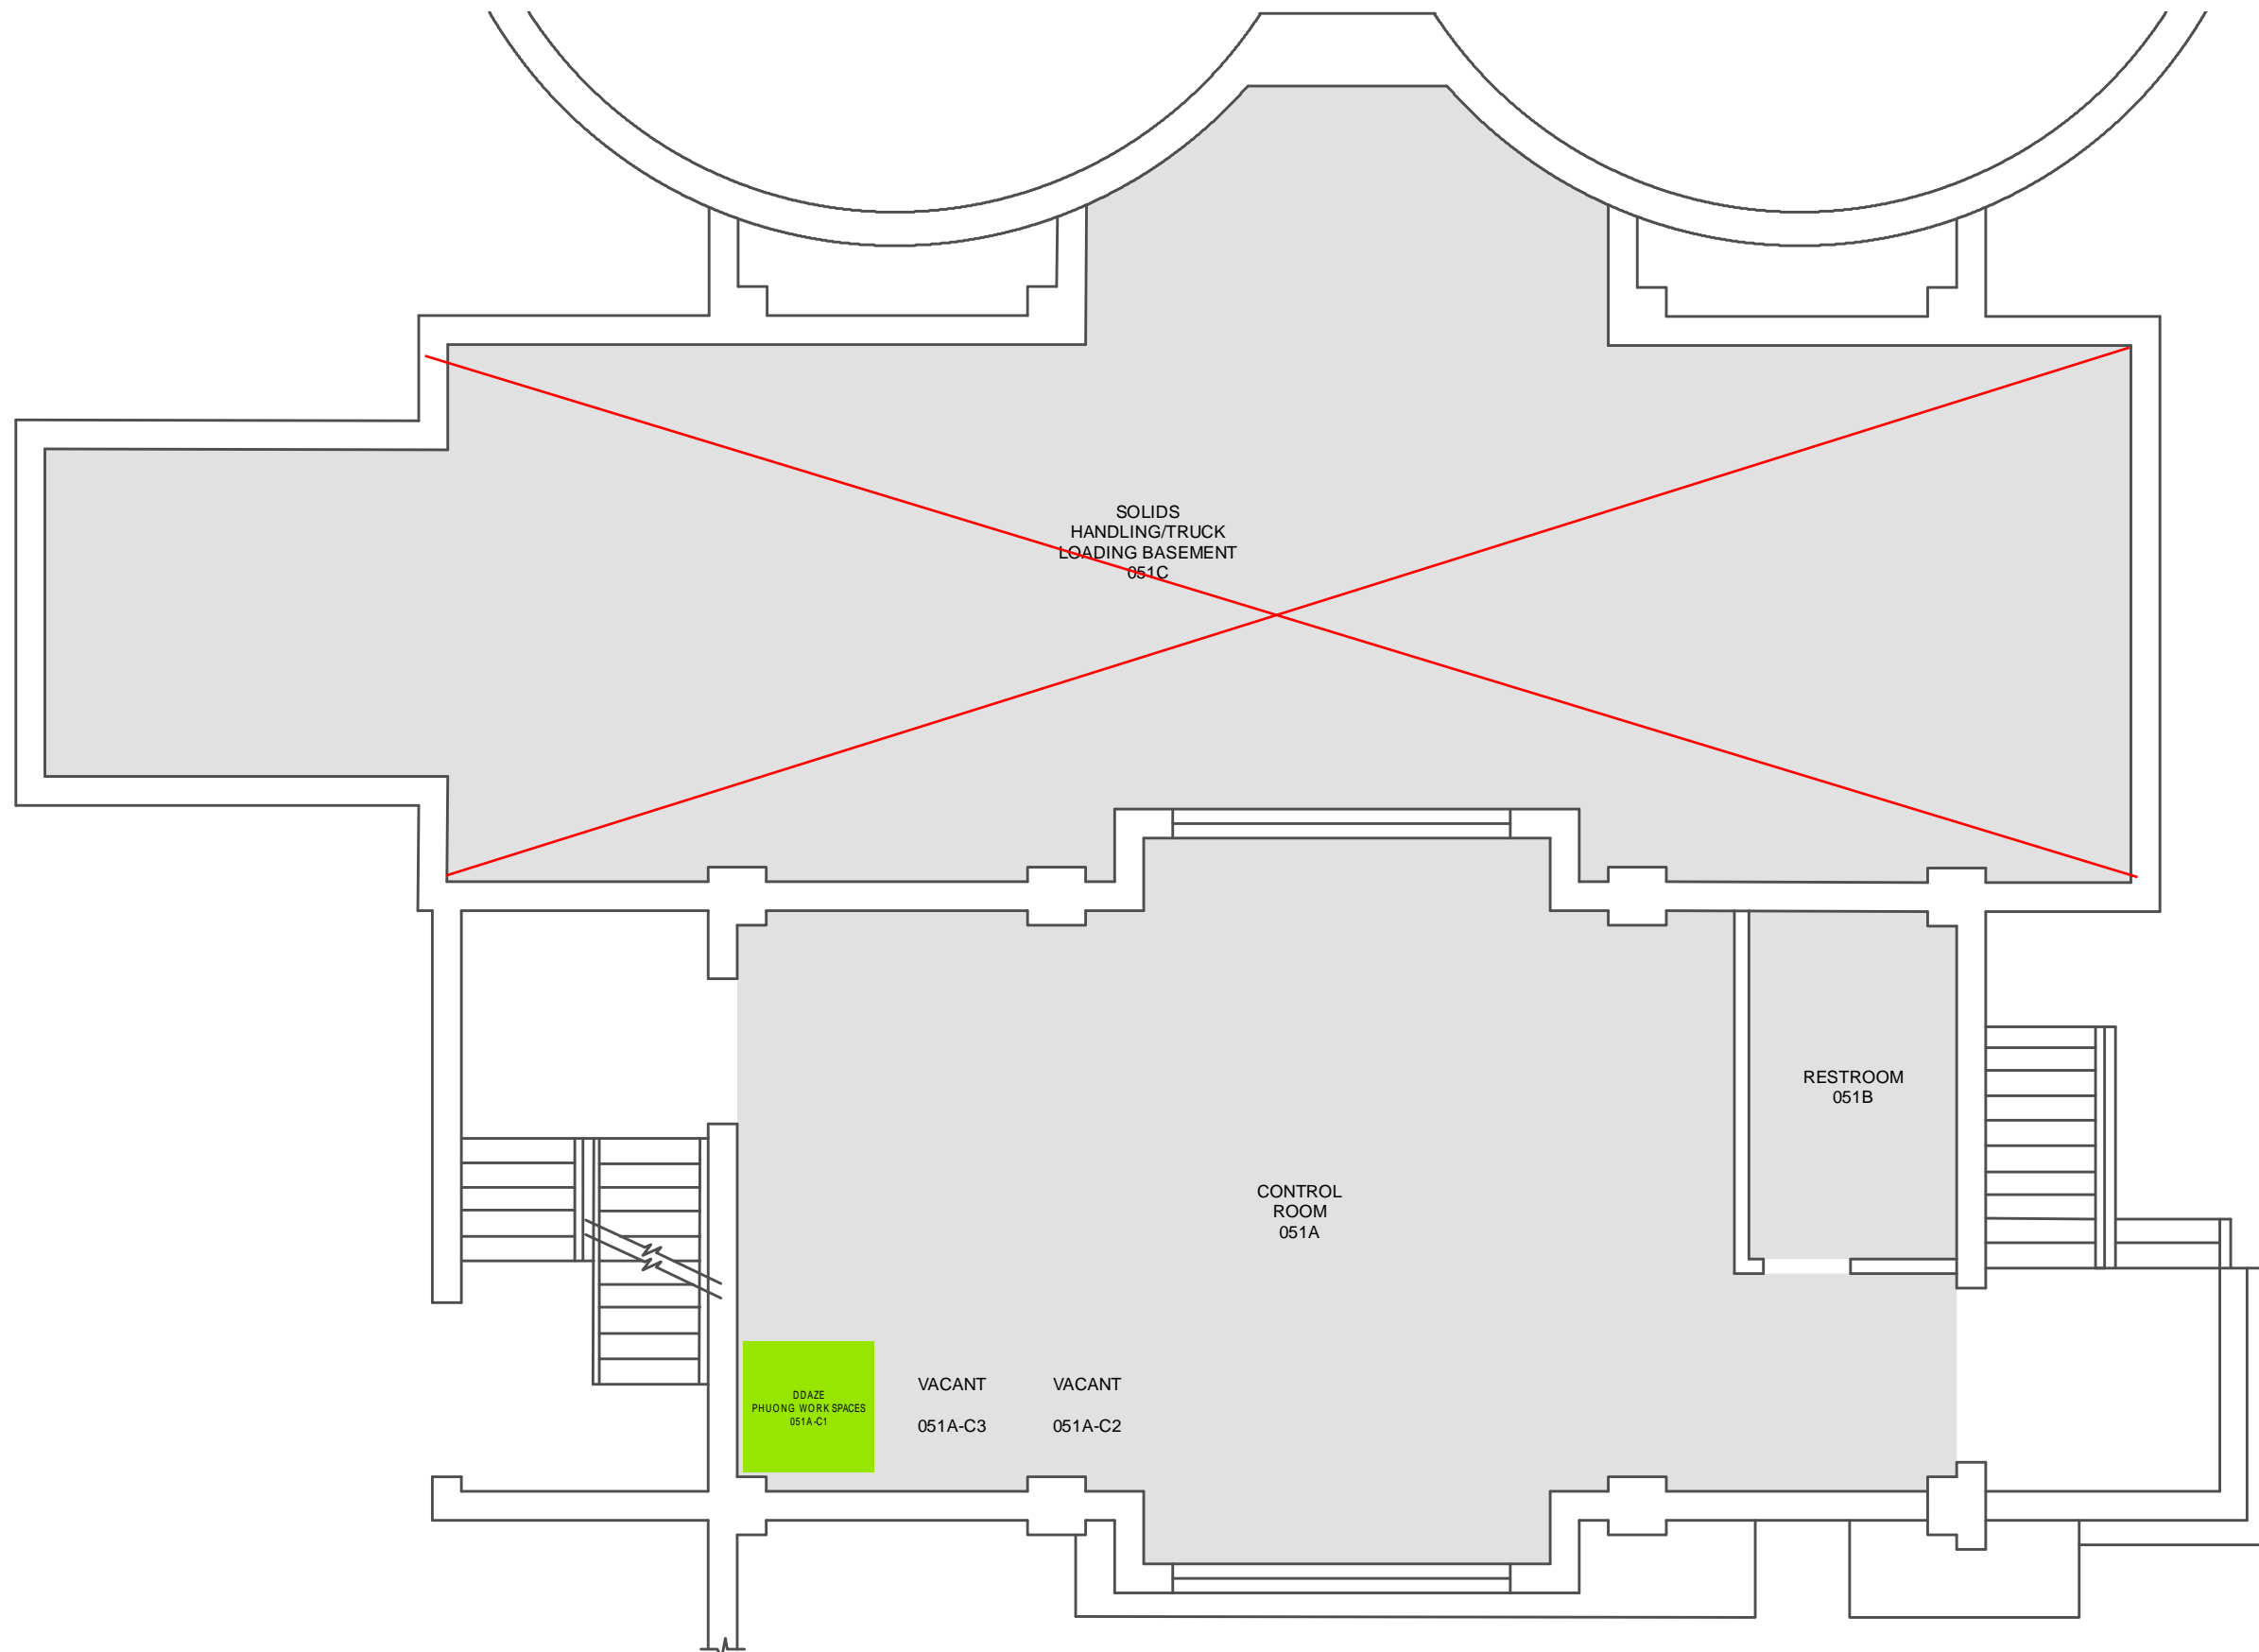


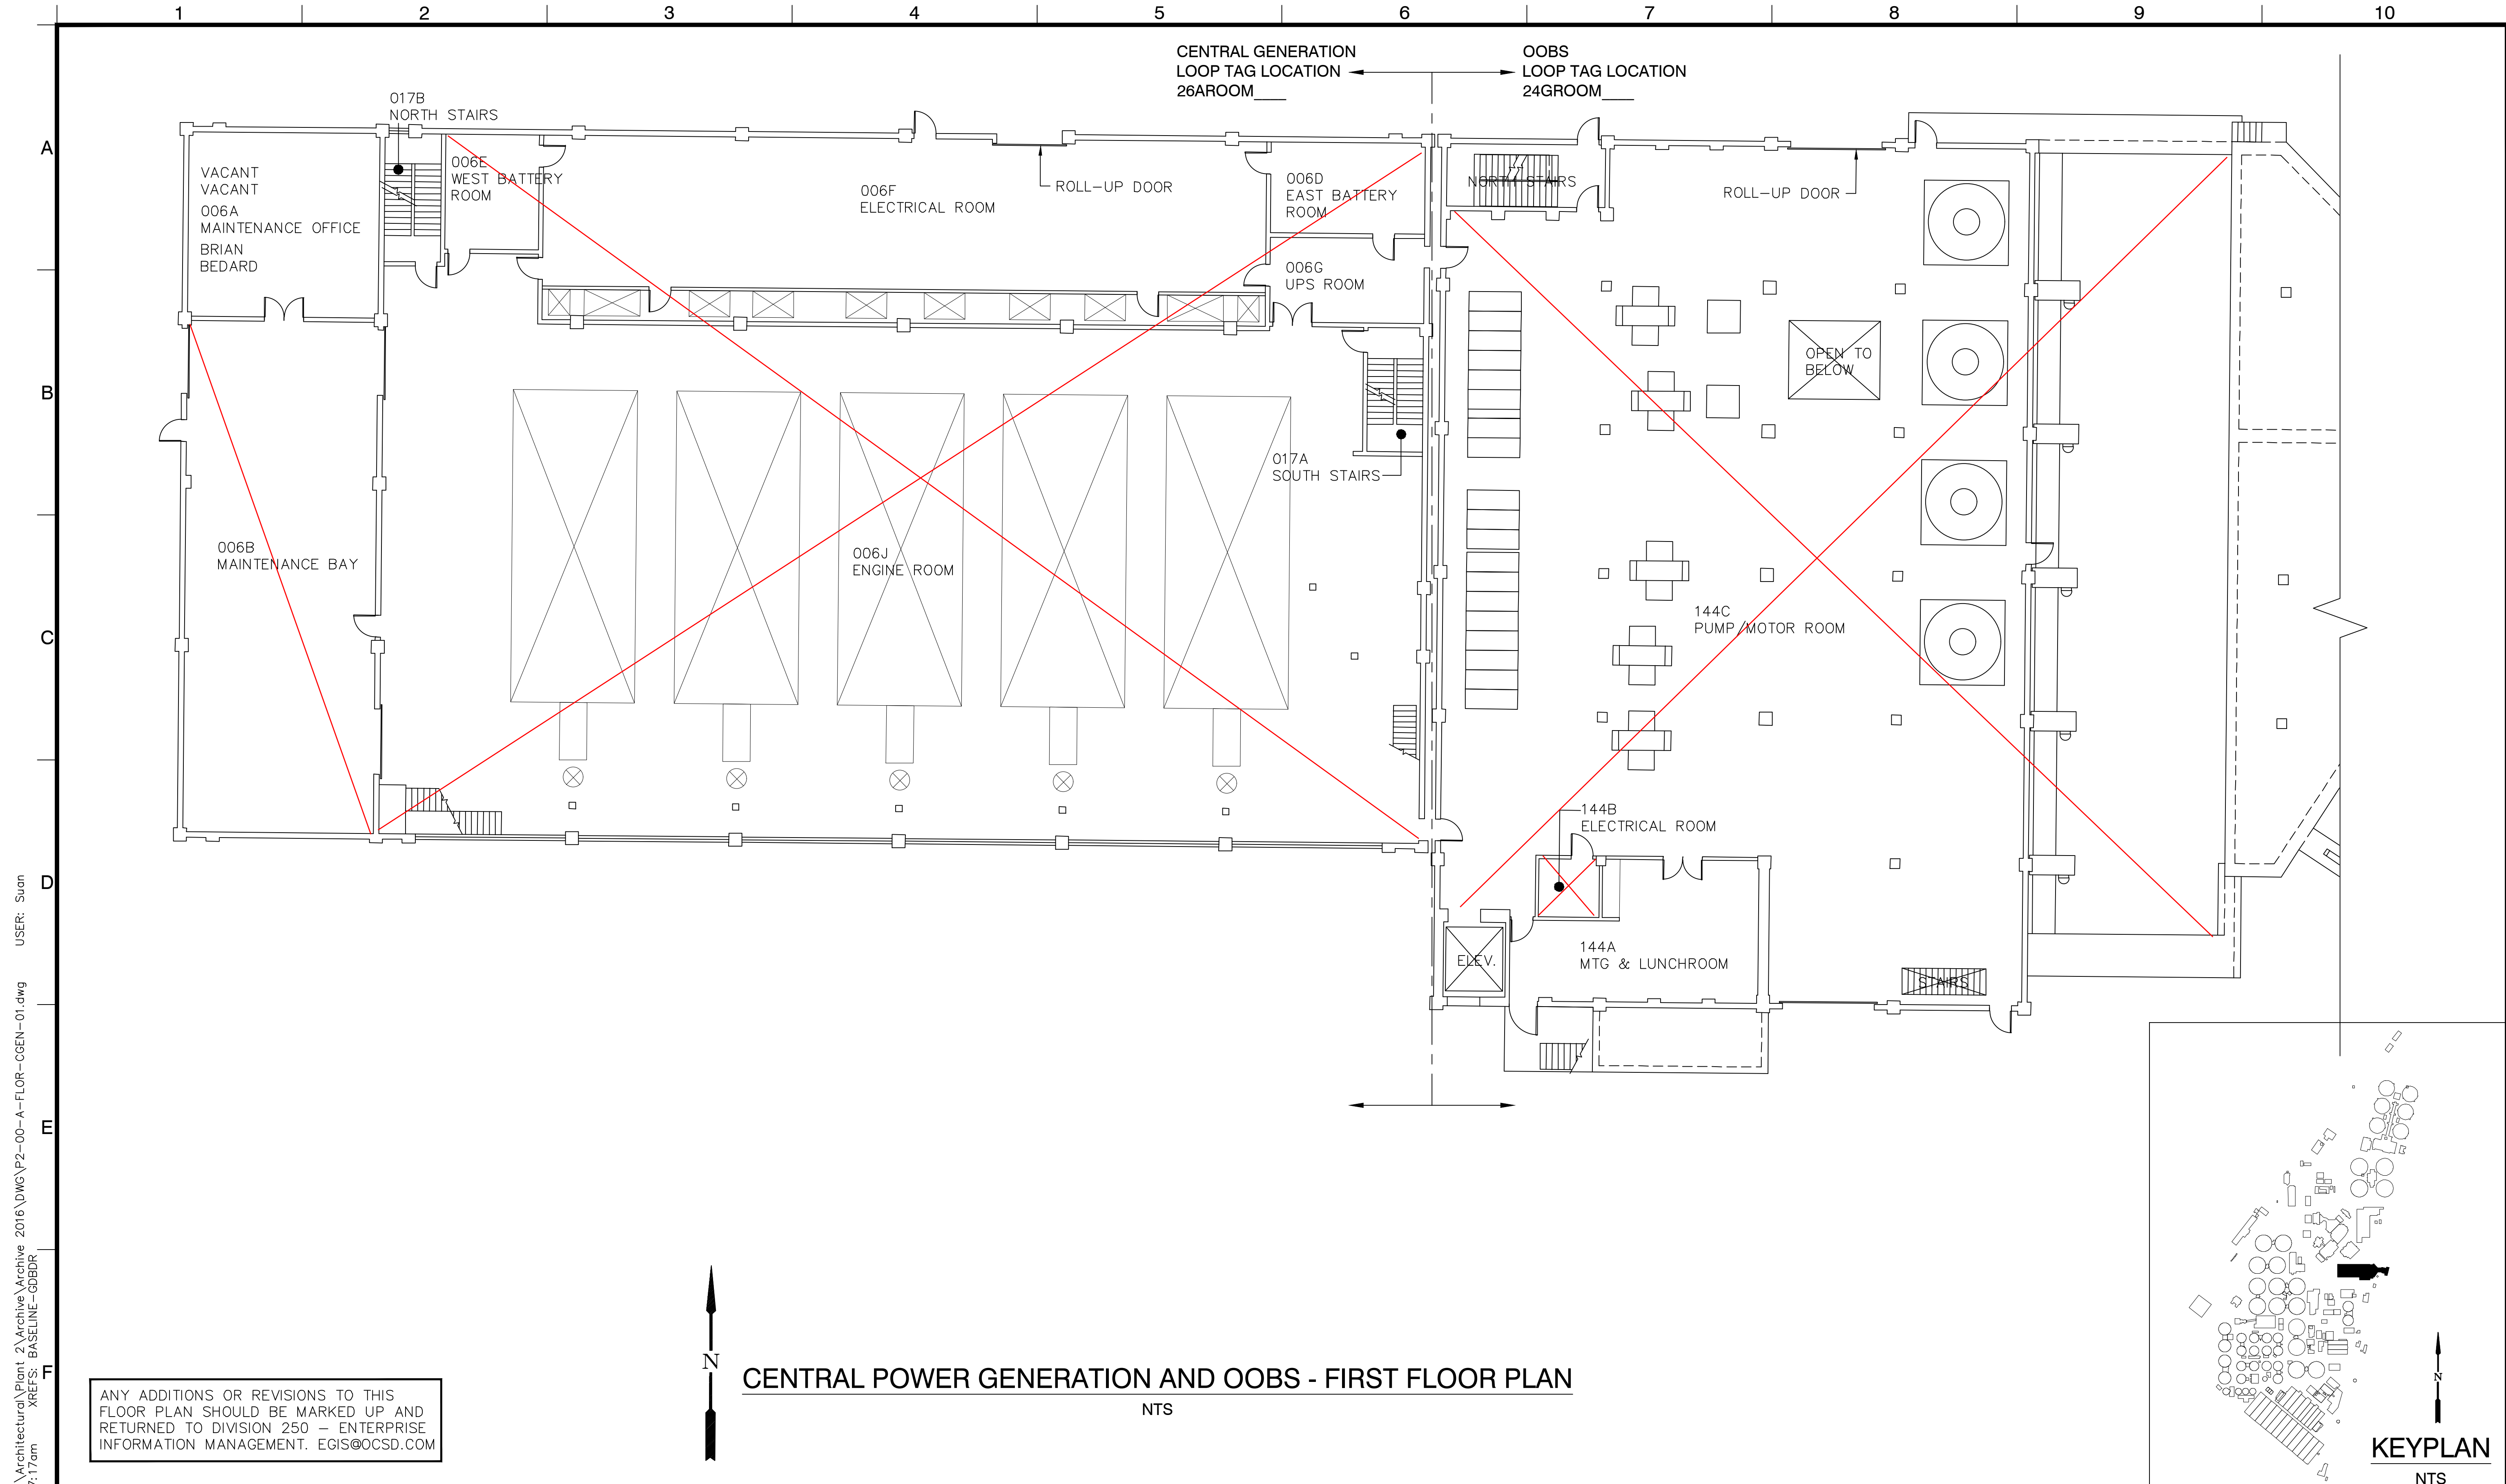

ANY ADDITIONS OR REVISIONS TO THIS FLOOR PLAN SHOULD BE MARKED UP AND RETURNED TO DIVISION 250 - ENTERPRISE INFORMATION MANAGEMENT. EGIS@OCSD.COM




CENTRAL POWER GENERATION AND OOBs - FIRST FLOOR PLAN
NTS

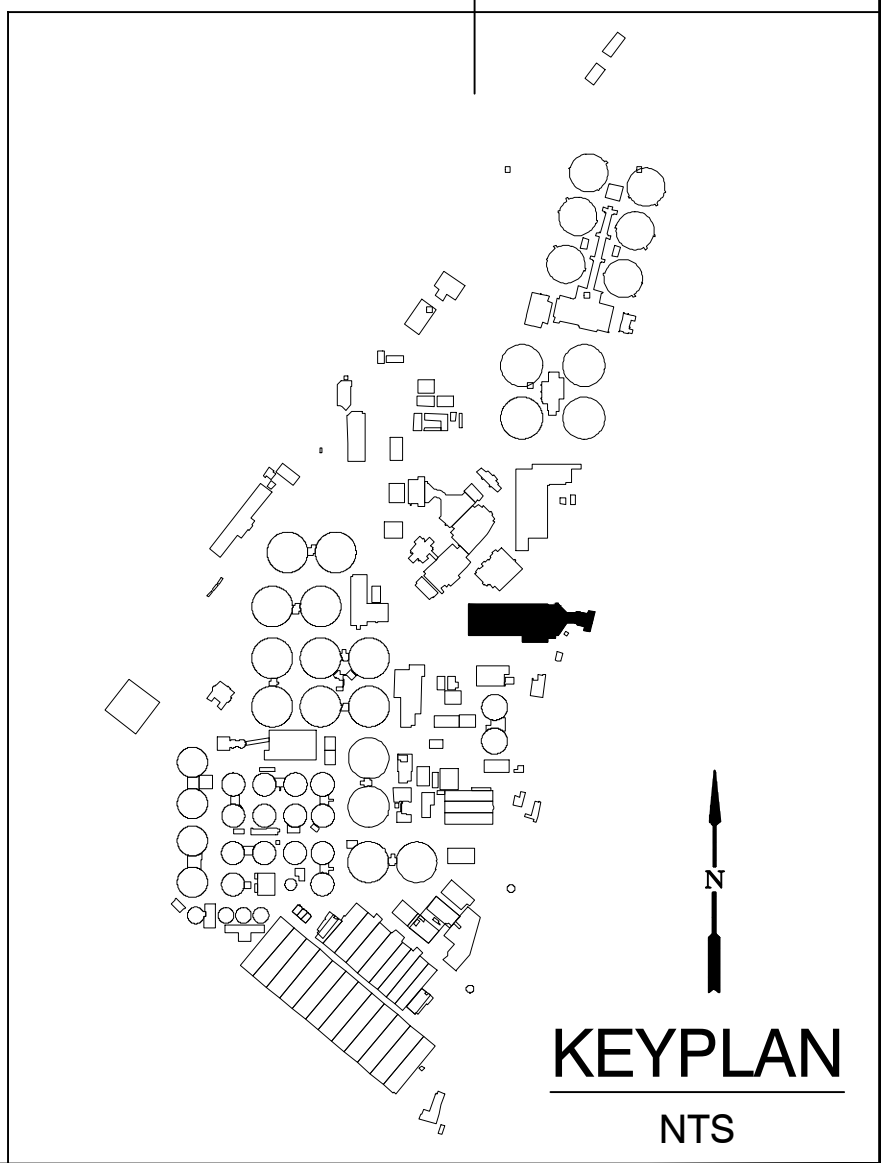

USER: Suen
 DWG: j:\Facility_Models\Architecture\Plant_2\Archive\Archive_2016\DWG\VP2-00-A-FLOOR-CEN-01.dwg
 DATE: Jun 24, 2020 7:17am
 XREFS: BASELINE-GBBDR

MARK	DESCRIPTION	DATE	APPR.


DESIGNED BY: _____
 DRAWN BY: RT - 06/13
 CHECKED BY: _____
 LINE IS 2 INCHES AT FULL SIZE
 (IF NOT 2" - SCALE ACCORDINGLY)

 


ORANGE COUNTY SANITATION DISTRICT

PLANT NO. 2
 BASELINE BUILDING FLOOR PLAN
CENTRAL POWER GENERATION AND OOBs FIRST FLOOR LAYOUT PLAN

PROJECT NO. BASELINE
 DRAWING NO. _____
 OF _____

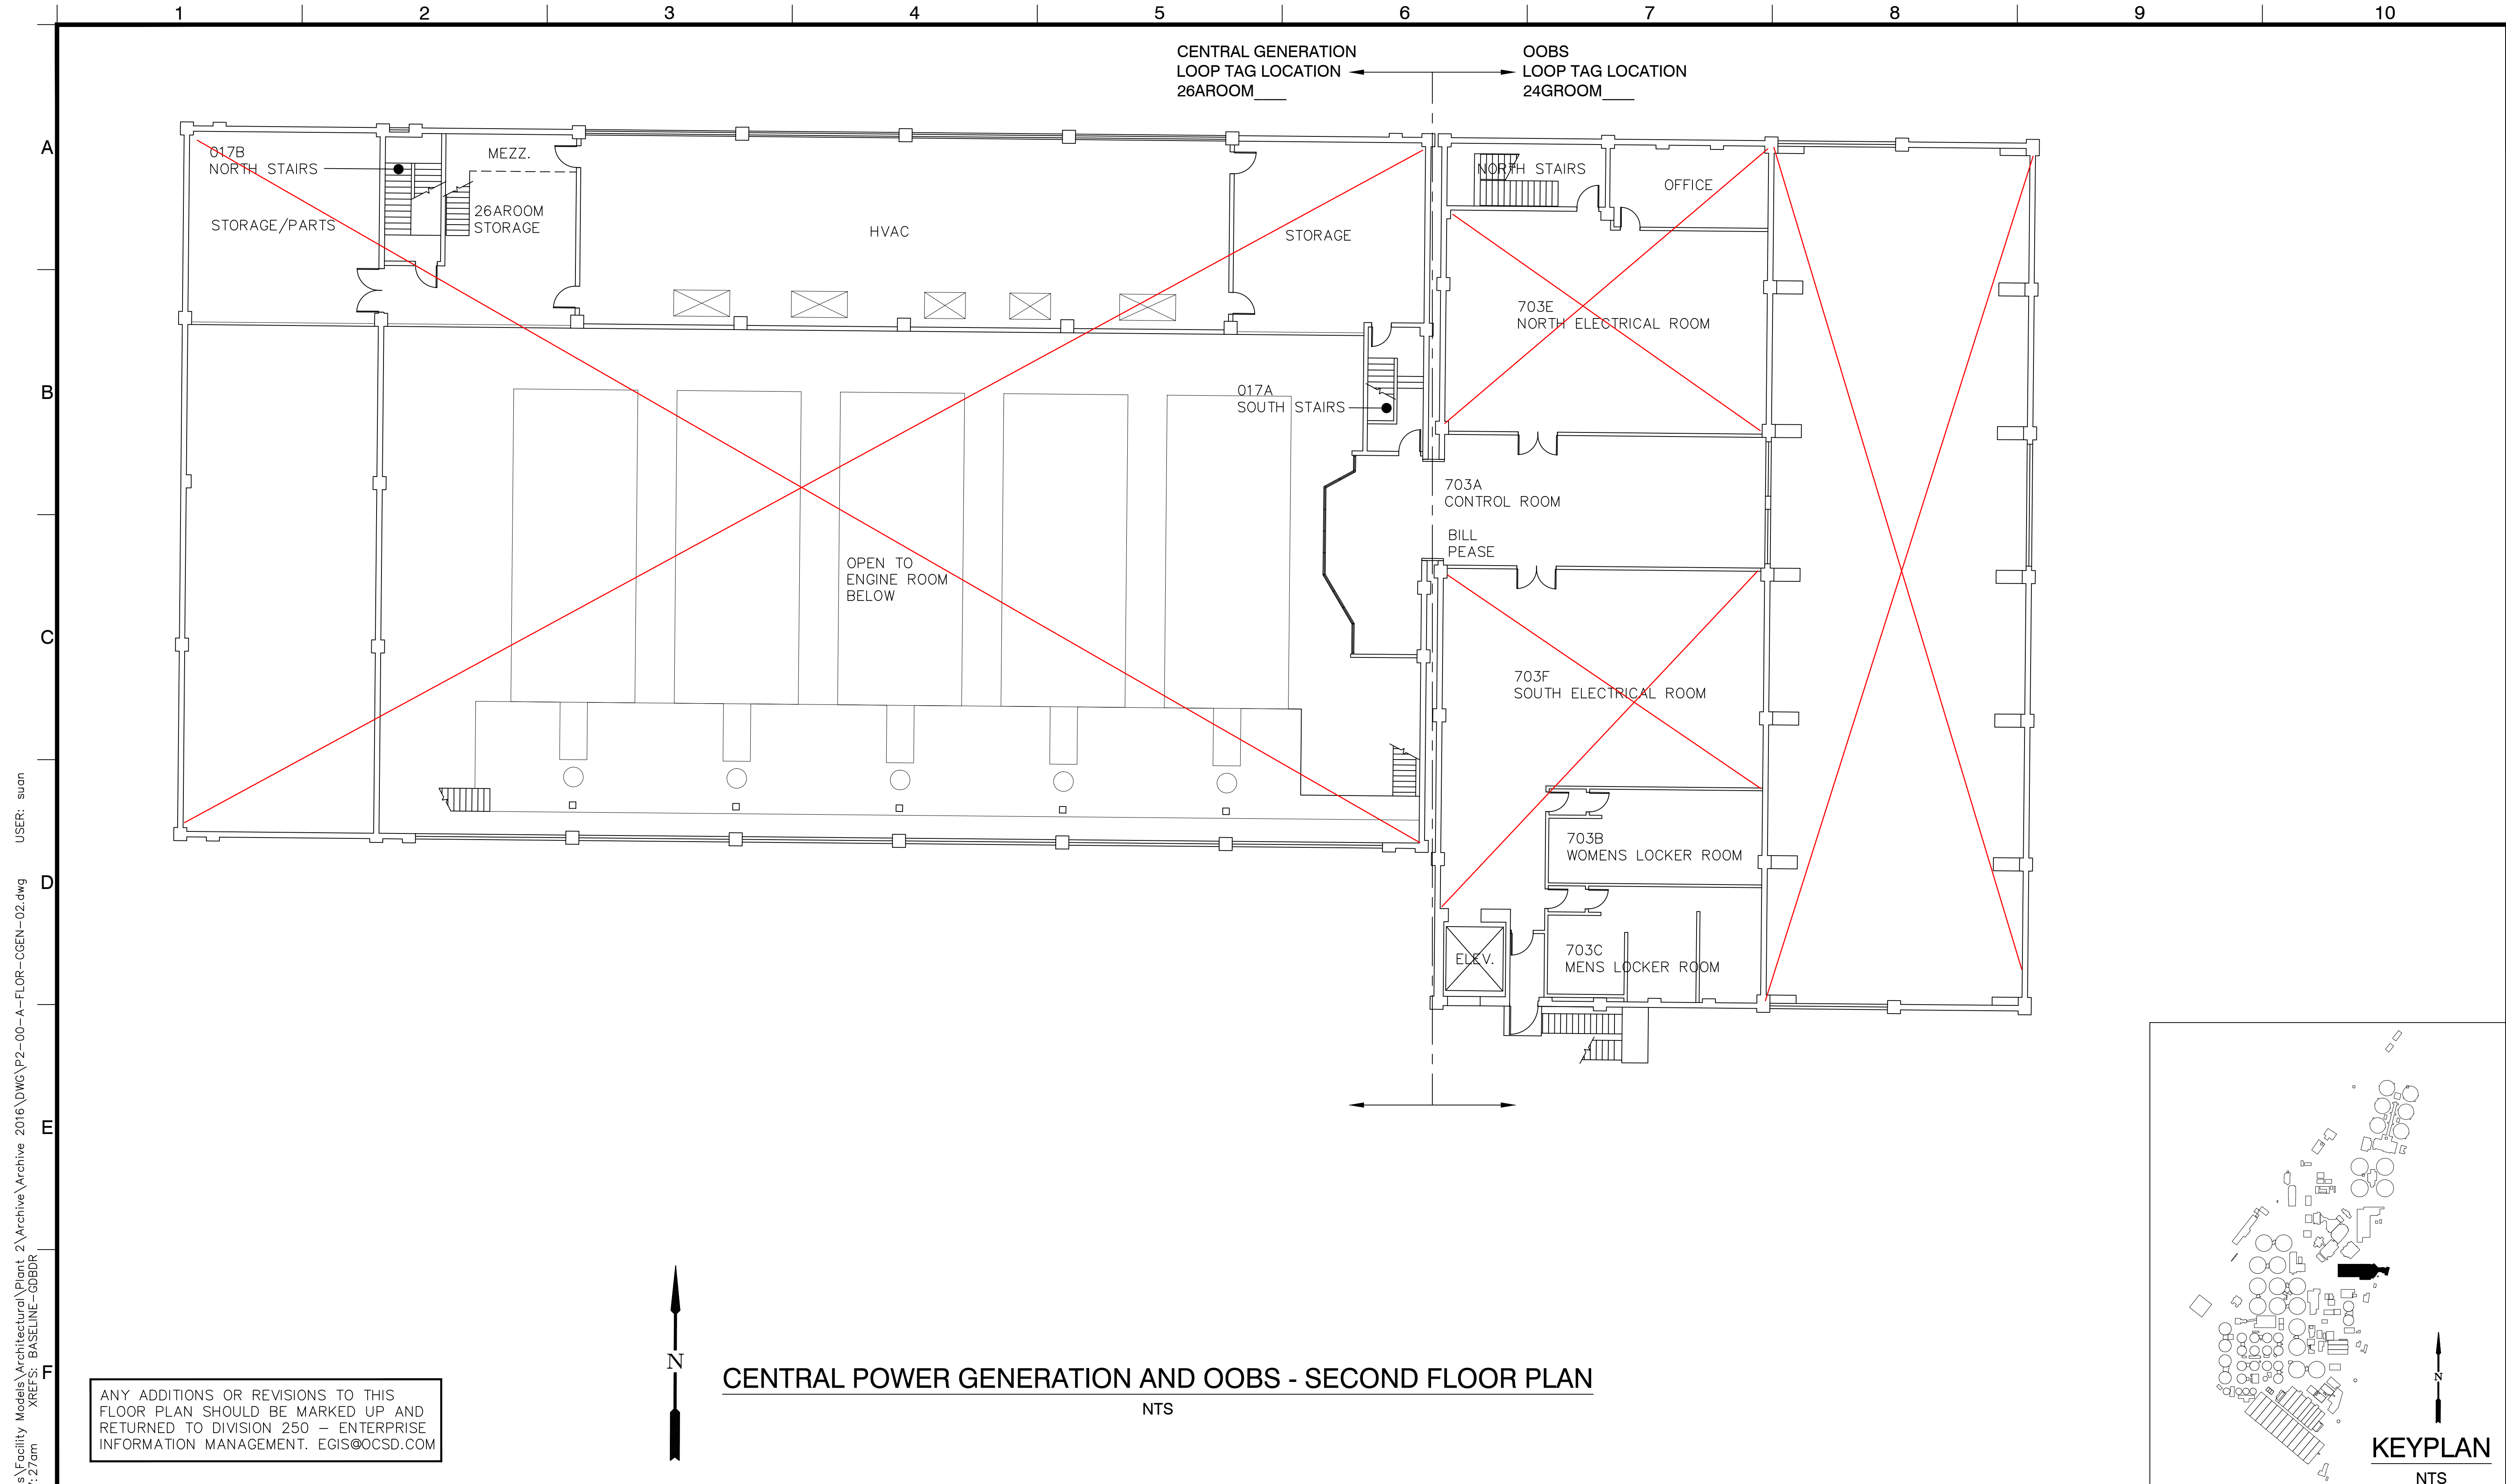


ANY ADDITIONS OR REVISIONS TO THIS FLOOR PLAN SHOULD BE MARKED UP AND RETURNED TO DIVISION 250 - ENTERPRISE INFORMATION MANAGEMENT. EGIS@OCS.D.COM

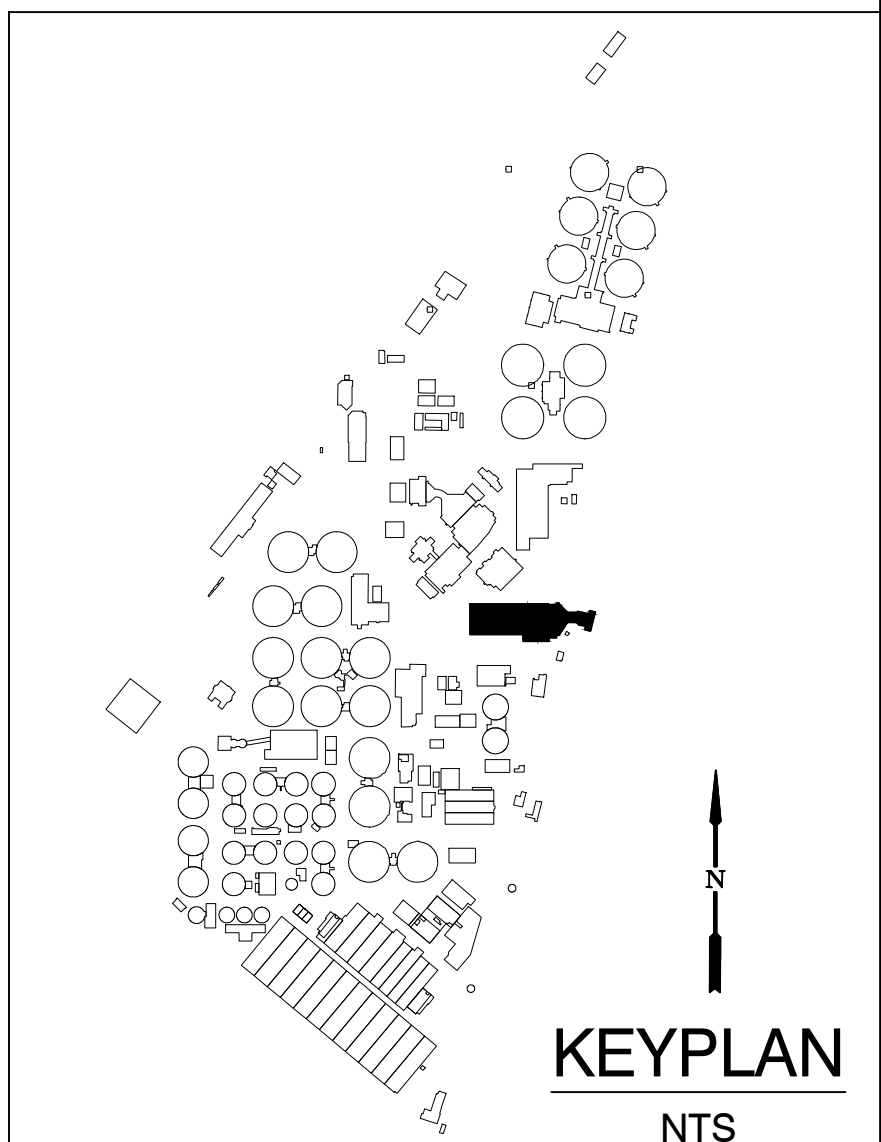

DWG: \\filer-\drawings\Facility Models\Architectural\Plant 2\Archive\Archive 2016\DWG\F2-00-A-FLOOR-CGEN-02.dwg
 DATE: Oct 29, 2018 7:27am
 USER: suan
 XREFS: BASELINE-GBBDR

MARK	DESCRIPTION	DATE	APPR.


DESIGNED BY: _____
 DRAWN BY: RT - 06/13
 CHECKED BY: _____
 LINE IS 2 INCHES AT FULL SIZE
 (IF NOT 2" - SCALE ACCORDINGLY)

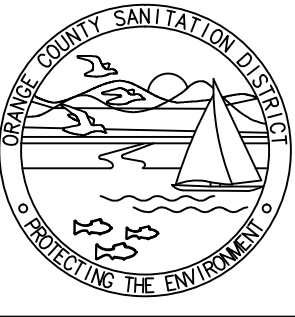

**ORANGE COUNTY
SANITATION DISTRICT**

PLANT NO. 2
 BASELINE BUILDING FLOOR PLAN
**CENTRAL POWER GENERATION
 AND OOBs SECOND FLOOR
 LAYOUT PLAN**


PROJECT NO. BASELINE
 DRAWING NO. _____
 OF _____

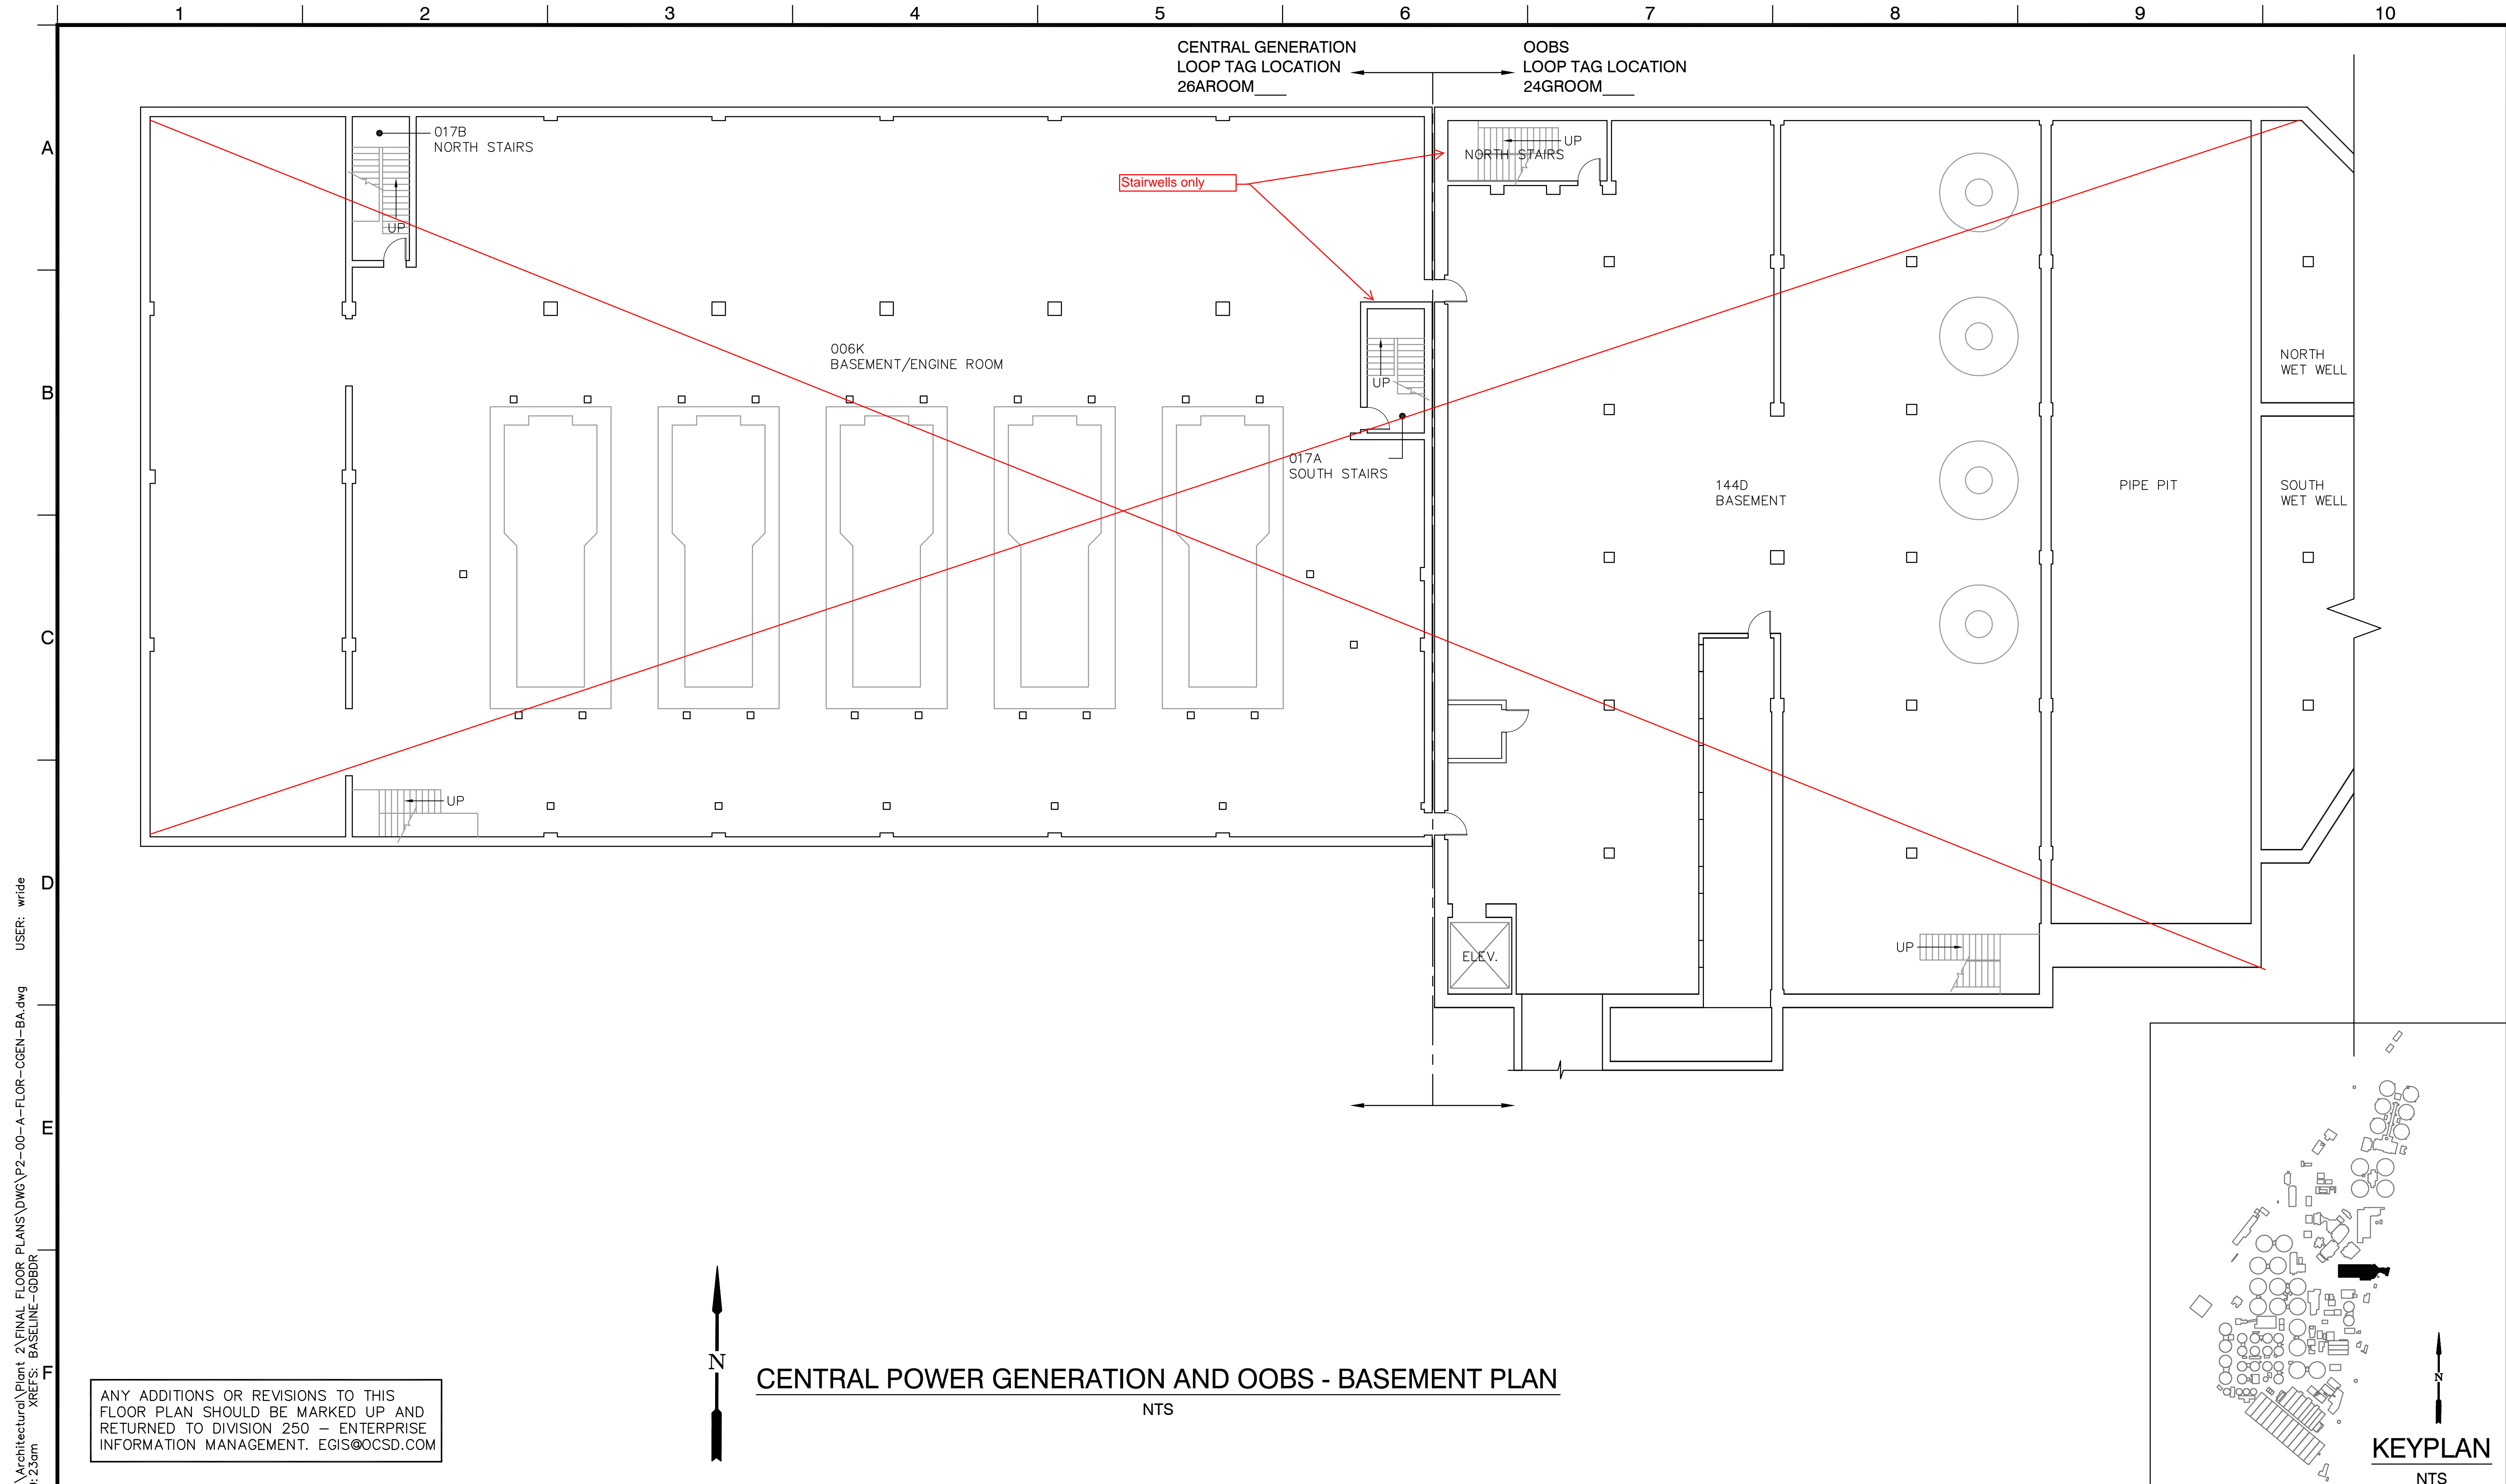

ANY ADDITIONS OR REVISIONS TO THIS FLOOR PLAN SHOULD BE MARKED UP AND RETURNED TO DIVISION 250 - ENTERPRISE INFORMATION MANAGEMENT. EGIS@OCSD.COM



CENTRAL POWER GENERATION AND OOBs - BASEMENT PLAN
NTS

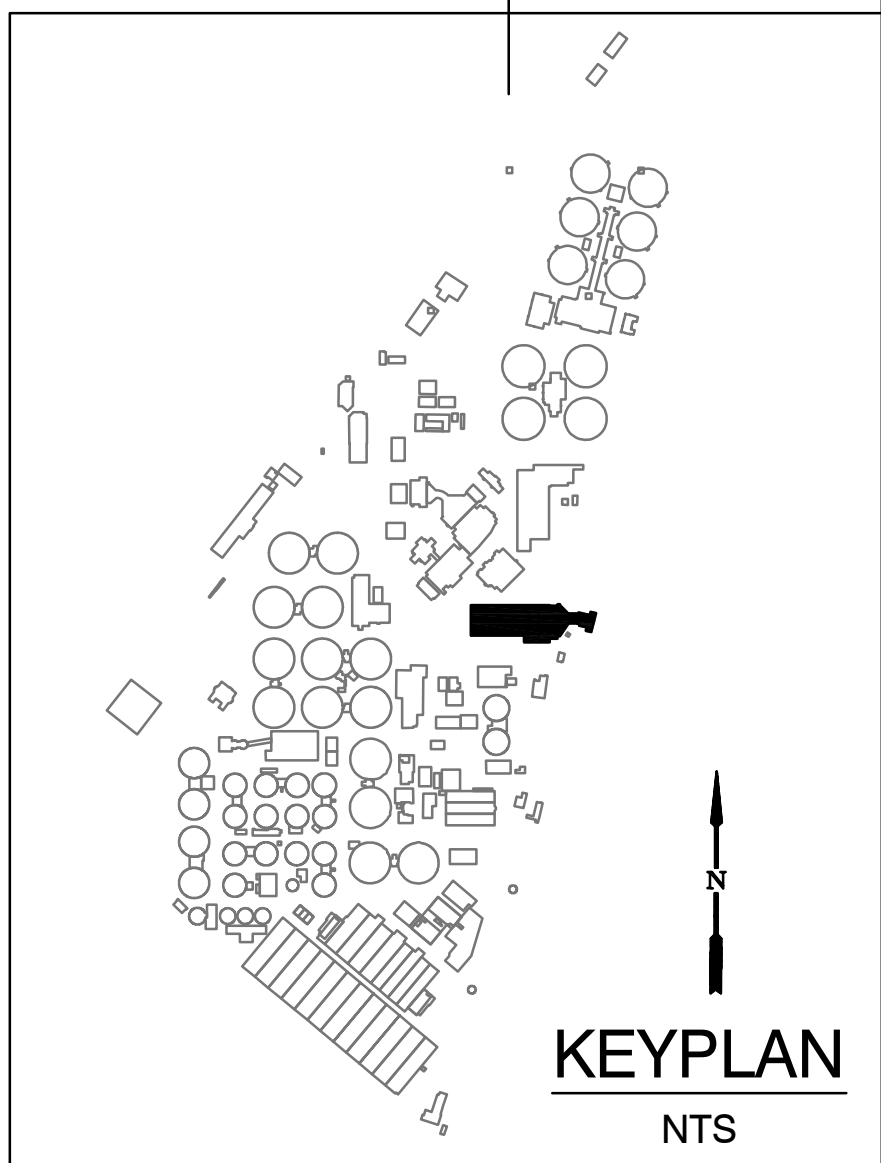


KEYPLAN
NTS

DWG: j:\Facility Models\Architectural\Plant 2\FINAL FLOOR PLANS\DWG\P2-00-A-FLOOR-CGEN-BA.dwg USER: wide
 DATE: Feb 20, 2014 9:23am XREFS: BASELINE-GUDDK

MARK	DESCRIPTION	DATE	APPR.

DESIGNED BY: _____
 DRAWN BY: RT - 06/13
 CHECKED BY: _____
 LINE IS 2 INCHES
 AT FULL SIZE
 (IF NOT 2" - SCALE ACCORDINGLY)

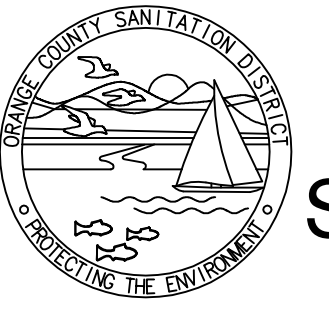


**ORANGE COUNTY
SANITATION DISTRICT**

PLANT NO. 2
 BASELINE BUILDING FLOOR PLAN
**CENTRAL POWER GENERATION
 AND OOBs BASEMENT FLOOR
 LAYOUT PLAN**

PROJECT NO. BASELINE
 DRAWING NO. _____
 OF _____

CONSTRUCTION MANAGEMENT TRAILERS

LOOP TAG NUMBER 29FROOM_____

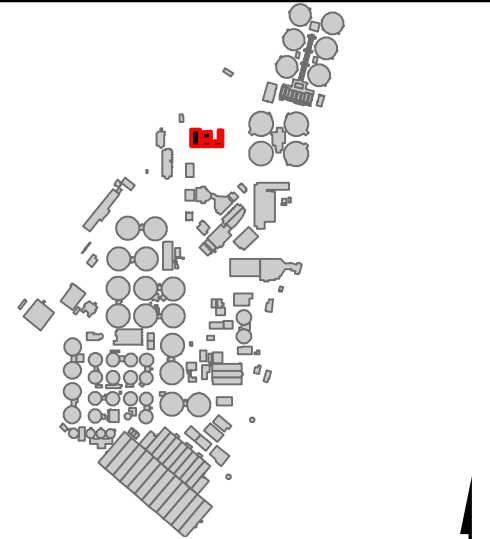

KEY MAP
NTS

DIVISION


- 161
- 230
- 740
- 750
- 760
- 770
- AED
- Fire Extinguisher
- First Aid Kit
- Pull Station
- Water Dispenser
- USB Scanning Station

ADDITIONS OR REVISIONS TO THIS FLOOR PLAN SHOULD BE MARKED UP AND RETURNED TO DIVISION 250 - ENTERPRISE INFORMATION MANAGEMENT. EGIS@OCS.D.COM





ORANGE COUNTY
SANITATION DISTRICT


P2 CM TRAILER #4
29FSTRC002

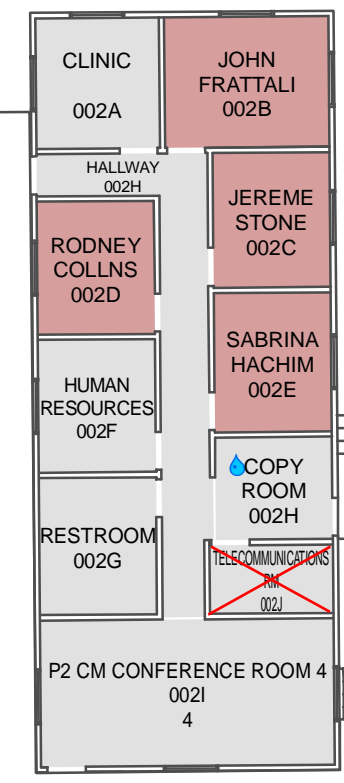


P2 CM TRAILER #5
29FSTRC007

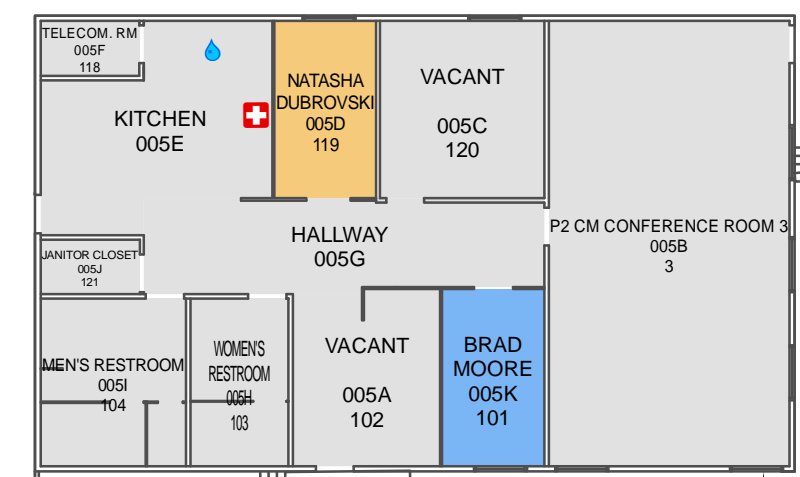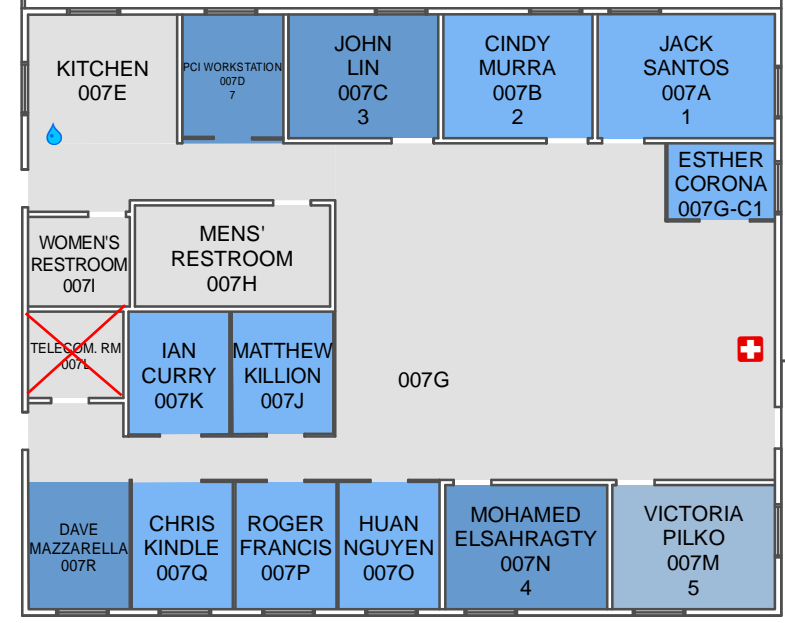

P2 CM TRAILER #2
29FSTRC006

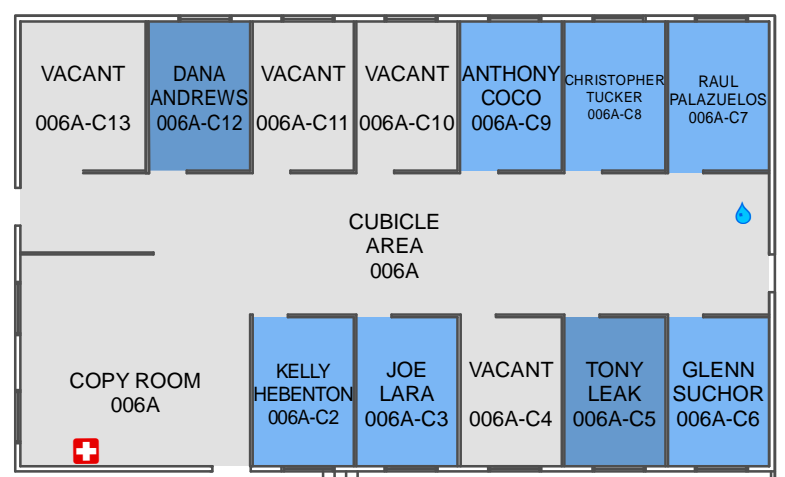


P2 CM TRAILER #1
29FSTRC008

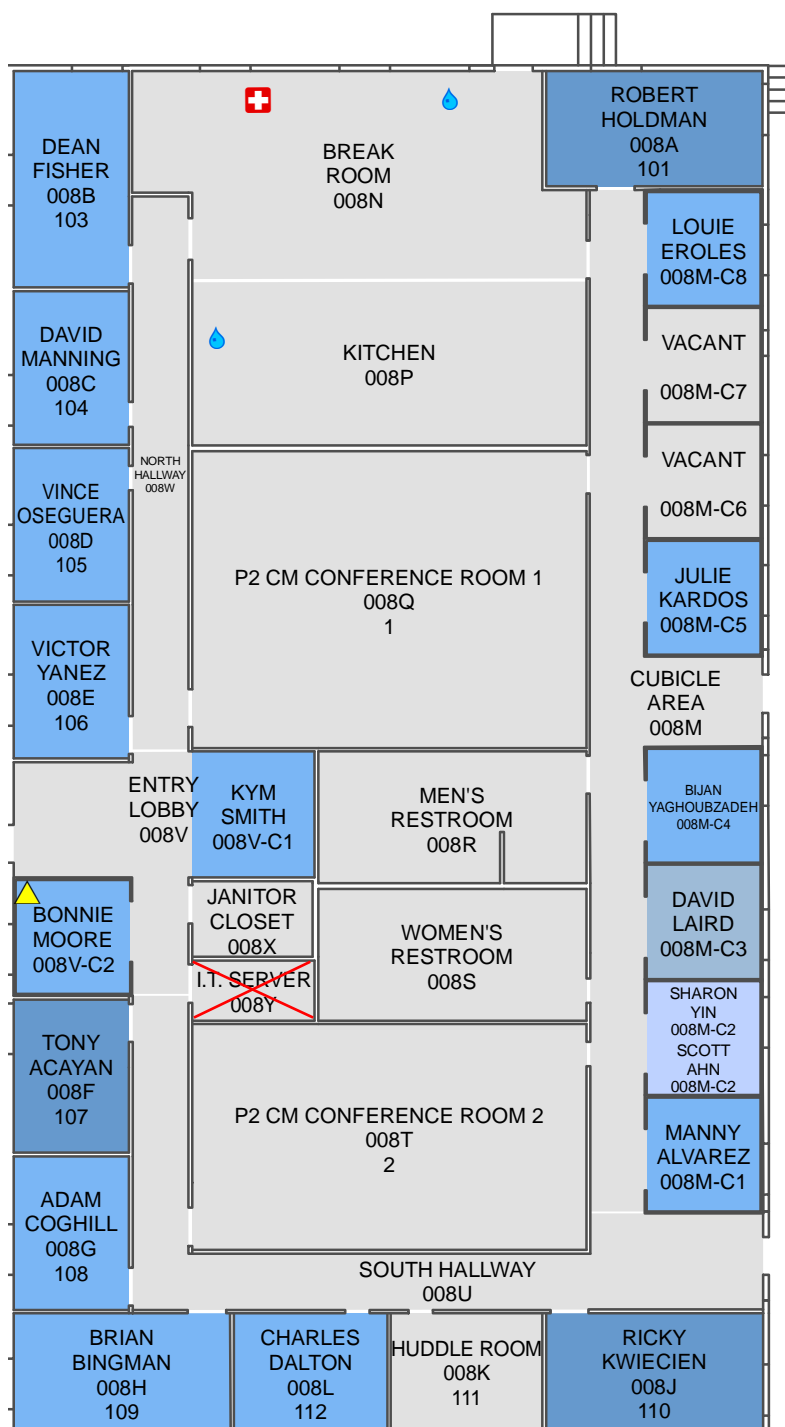


REVISED: 7/13/2020

LOOP TAG LOCATION
22IROOM___

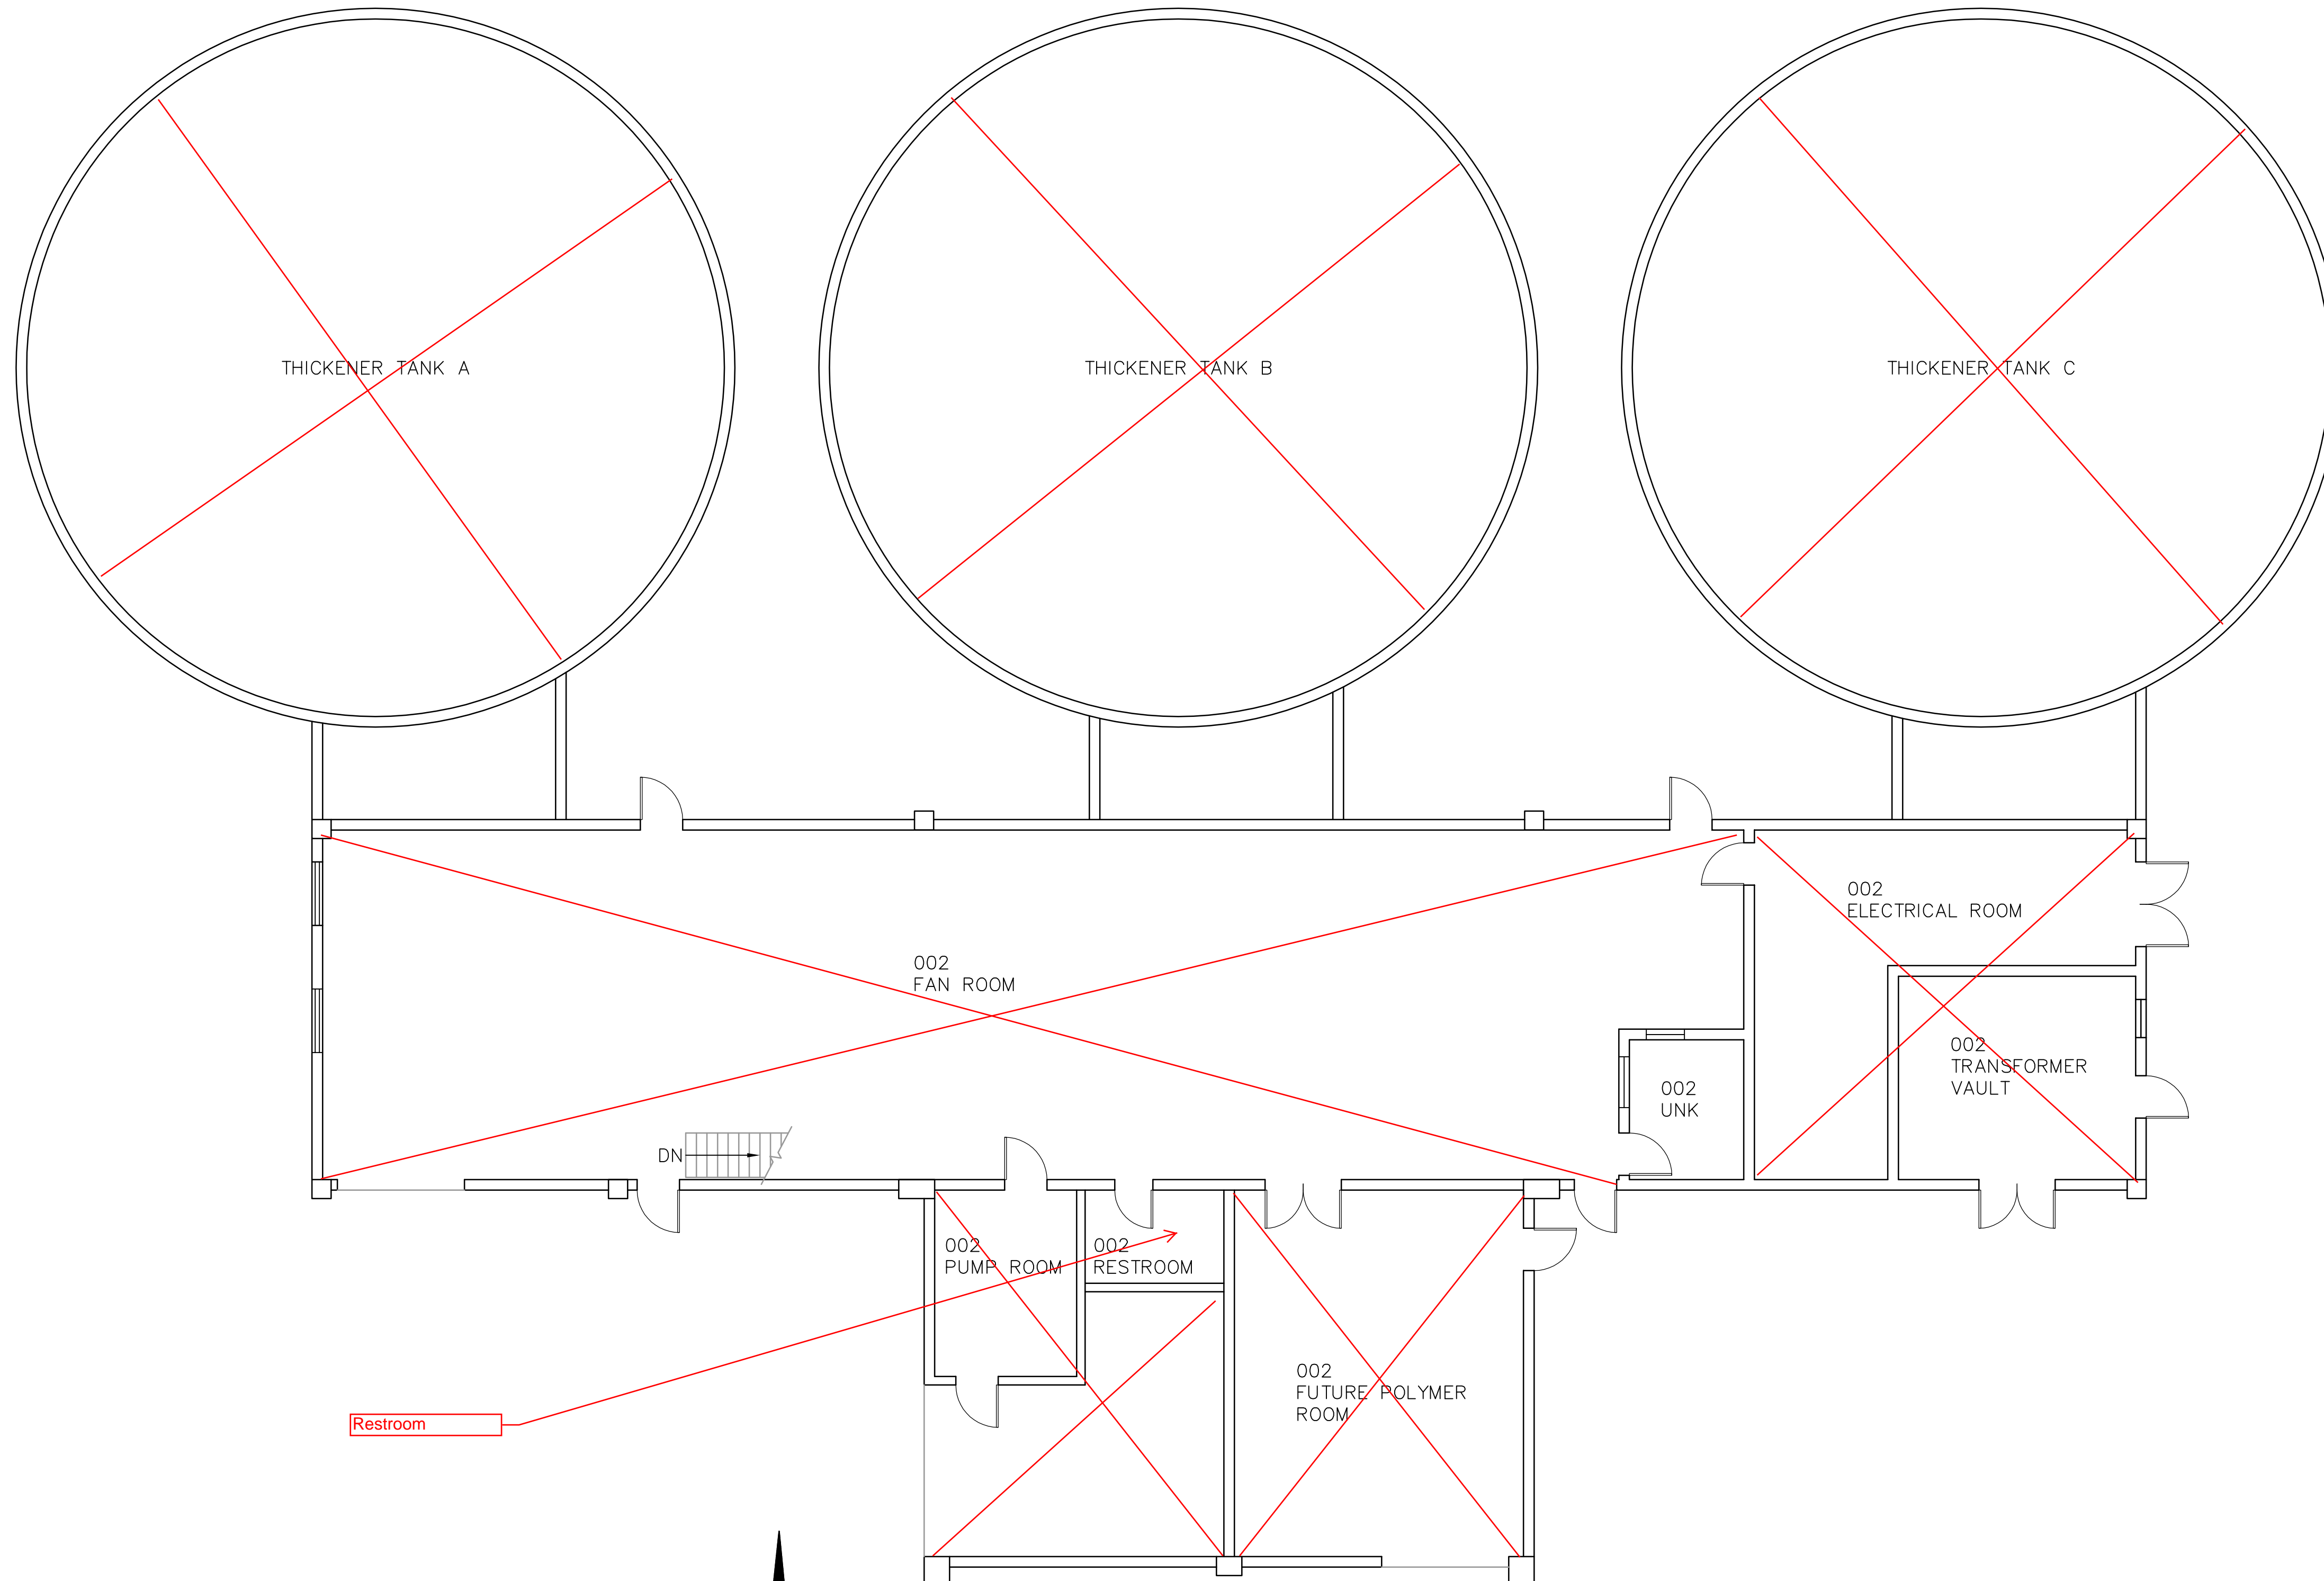

DAFT BUILDING - FLOOR PLAN
NTS

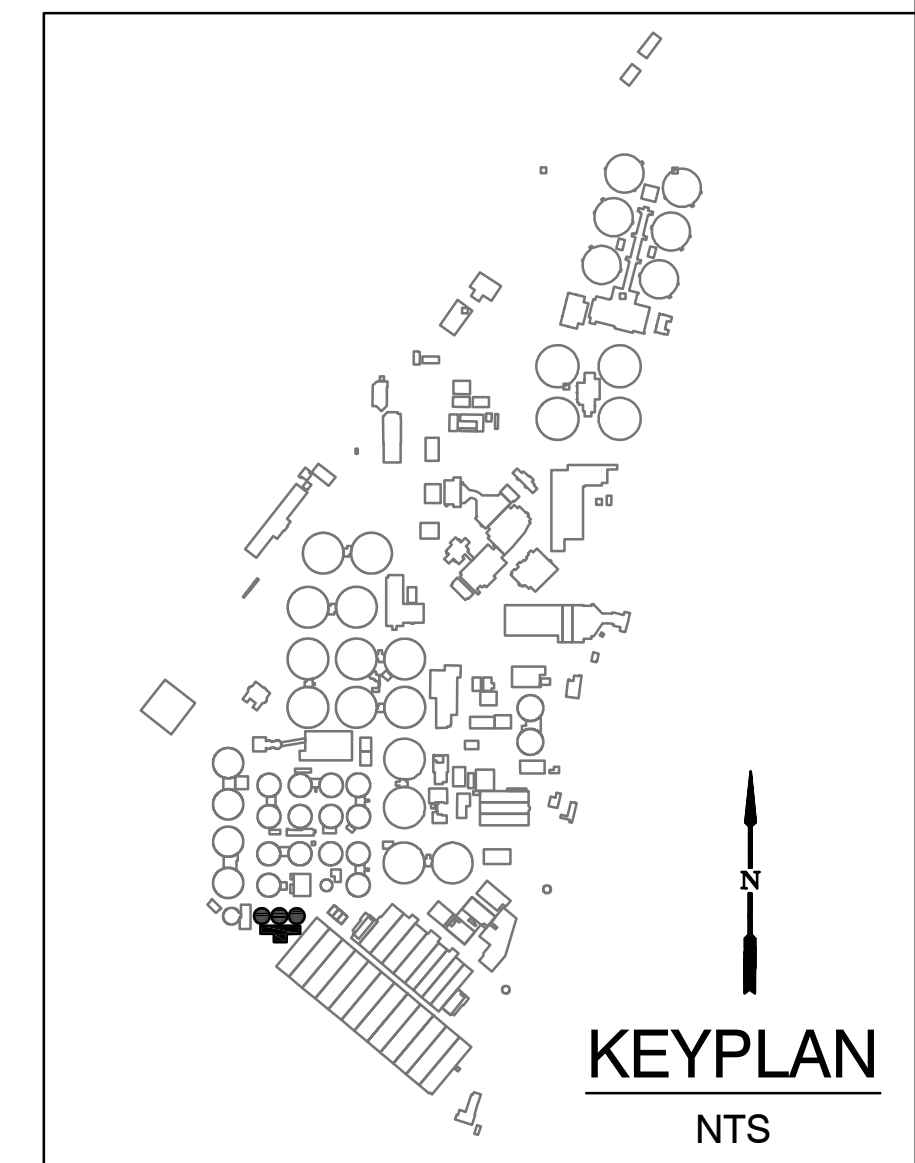


ANY ADDITIONS OR REVISIONS TO THIS FLOOR PLAN SHOULD BE MARKED UP AND RETURNED TO DIVISION 250 - ENTERPRISE INFORMATION MANAGEMENT. EGIS@OCSD.COM



DWG: j:\Facility Models\Architectural\Plant 2\FINAL FLOOR PLANS\DWG\P2-00-A-FLOOR-DAFT-01.dwg
 DATE: Feb 20, 2014 9:23am
 USER: wride
 XREFS: BASELINE-GUDDK

DESIGNED BY: _____
 DRAWN BY: RT - 06/13
 CHECKED BY: _____

LINE IS 2 INCHES
 AT FULL SIZE
 (IF NOT 2" - SCALE ACCORDINGLY)

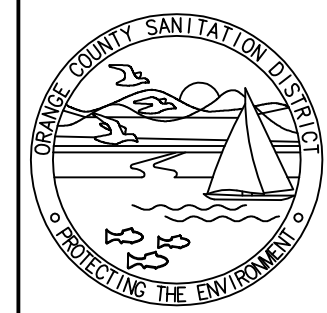

**ORANGE COUNTY
 SANITATION DISTRICT**

PLANT NO. 2
 BASELINE BUILDING FLOOR PLAN


**DAFT BUILDING
 FIRST FLOOR
 LAYOUT PLAN**

PROJECT NO. BASELINE


DRAWING NO. _____
 OF _____

MARK	DESCRIPTION	DATE	APPR.


LOOP TAG LOCATION
23AROOM___

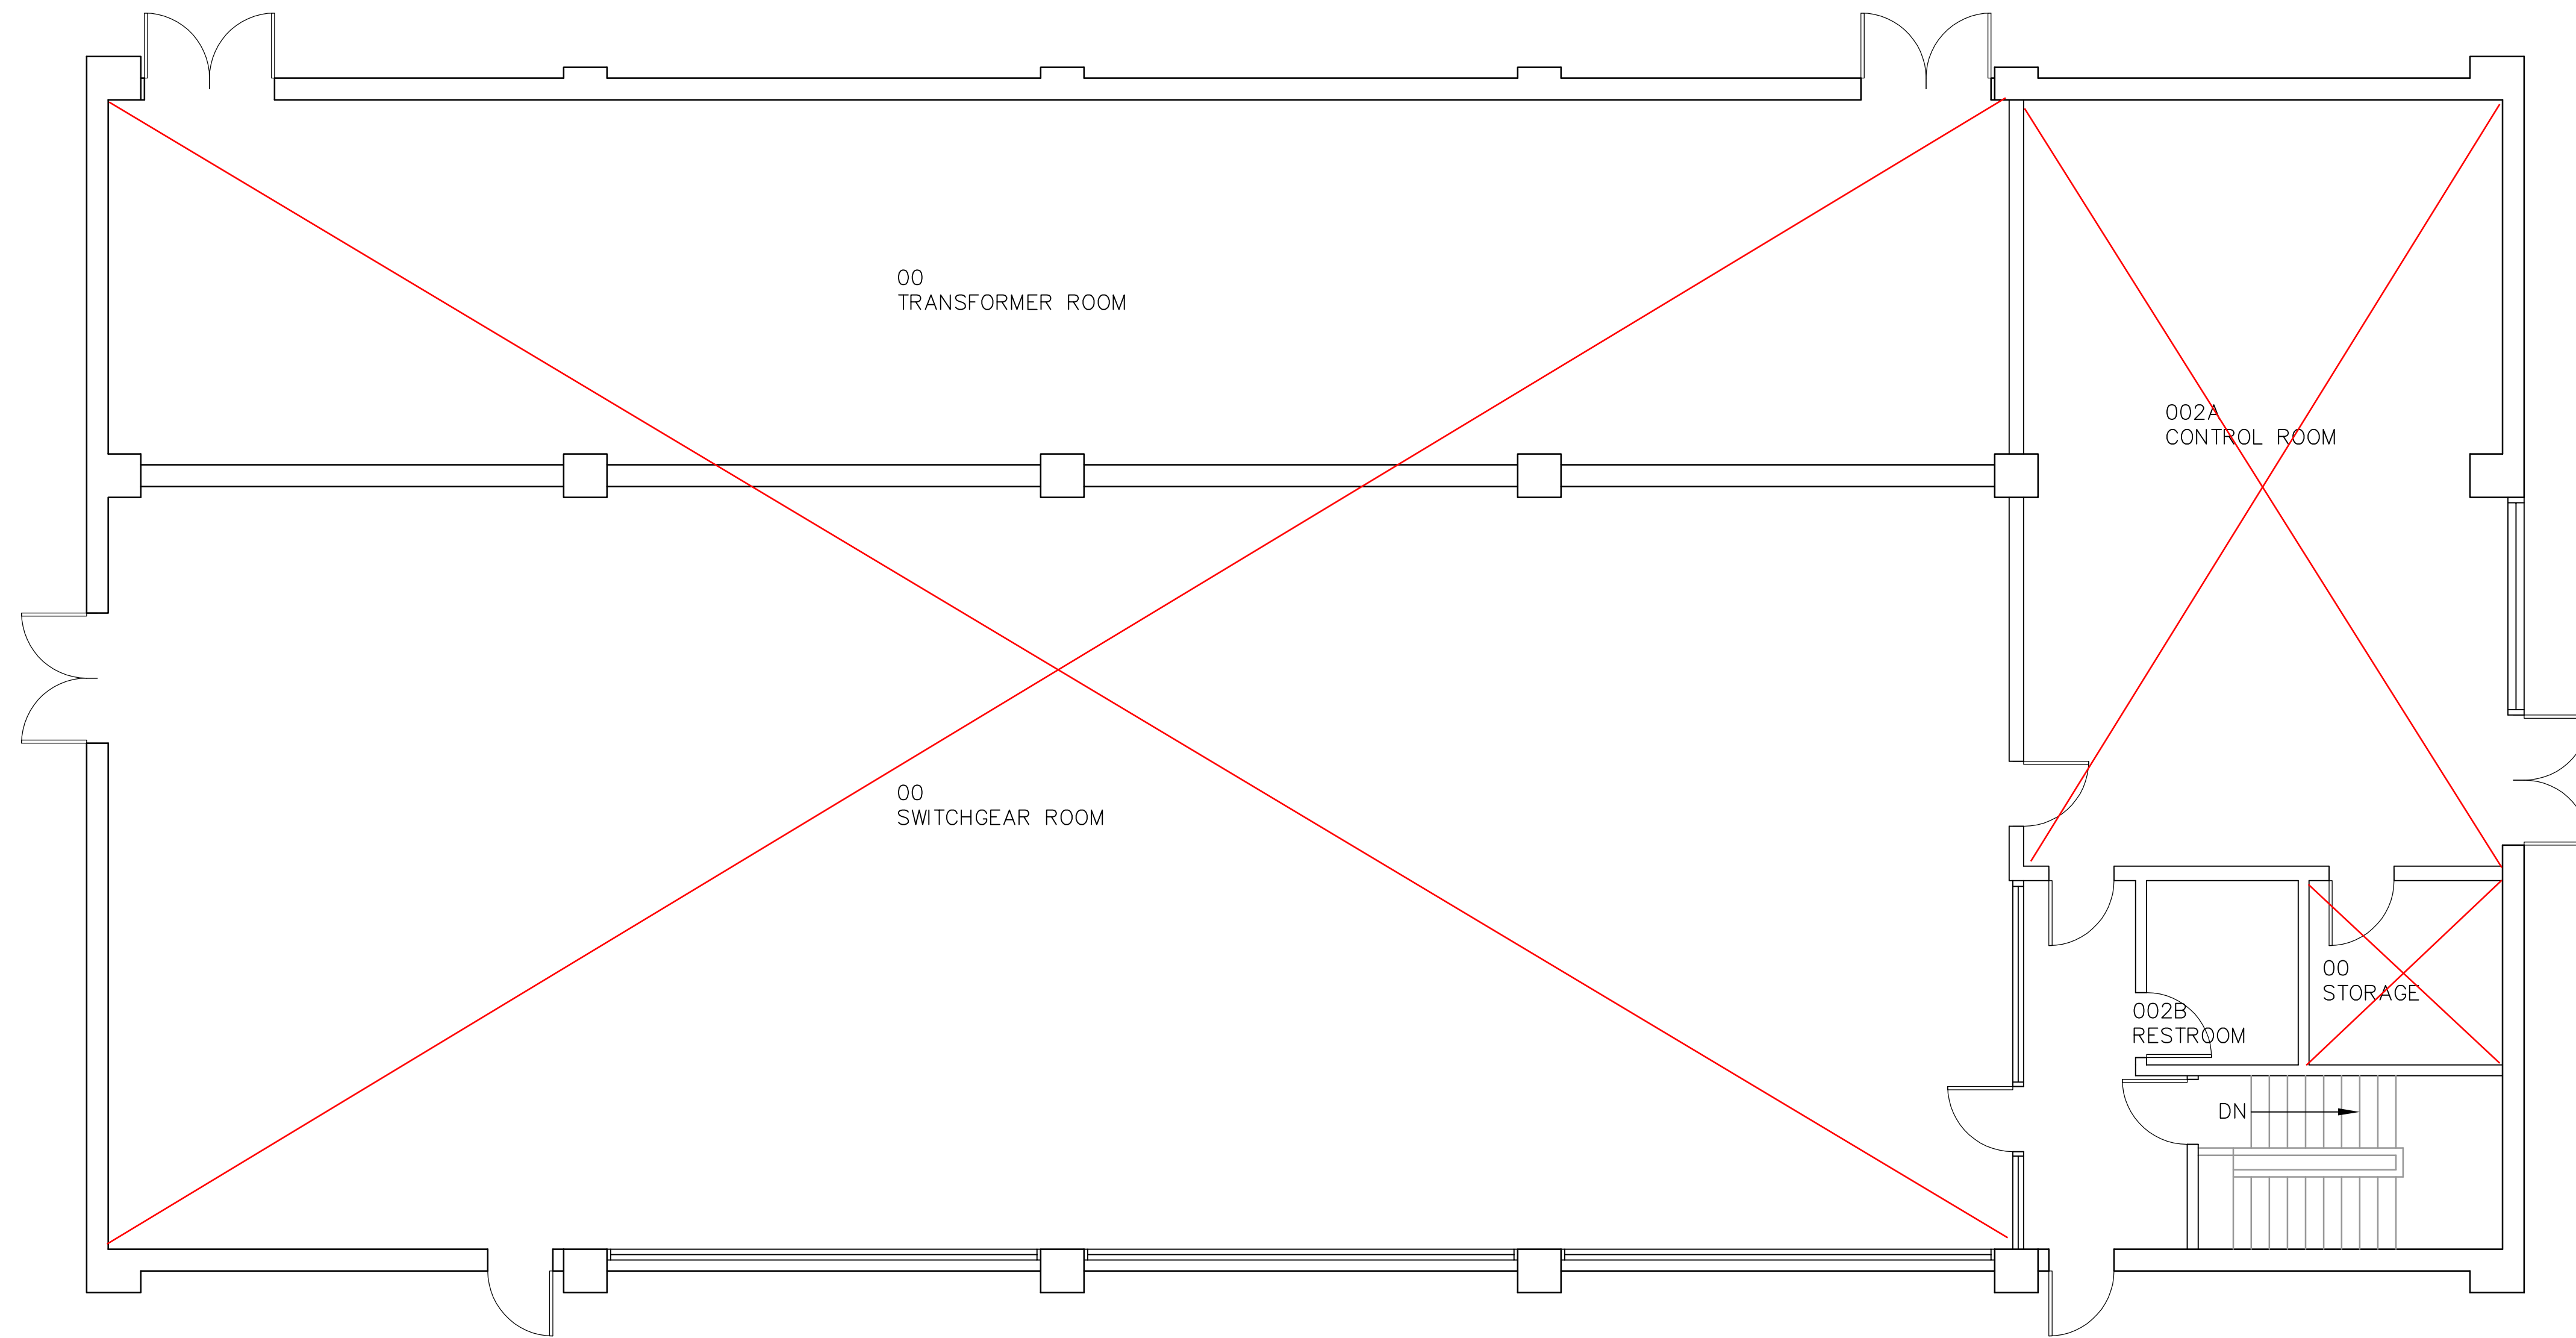

ANY ADDITIONS OR REVISIONS TO THIS FLOOR PLAN SHOULD BE MARKED UP AND RETURNED TO DIVISION 250 - ENTERPRISE INFORMATION MANAGEMENT. EGIS@OCSD.COM

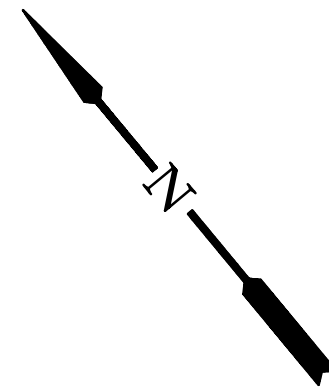


12KV DISTRIBUTION CENTER B - FIRST FLOOR PLAN
NTS

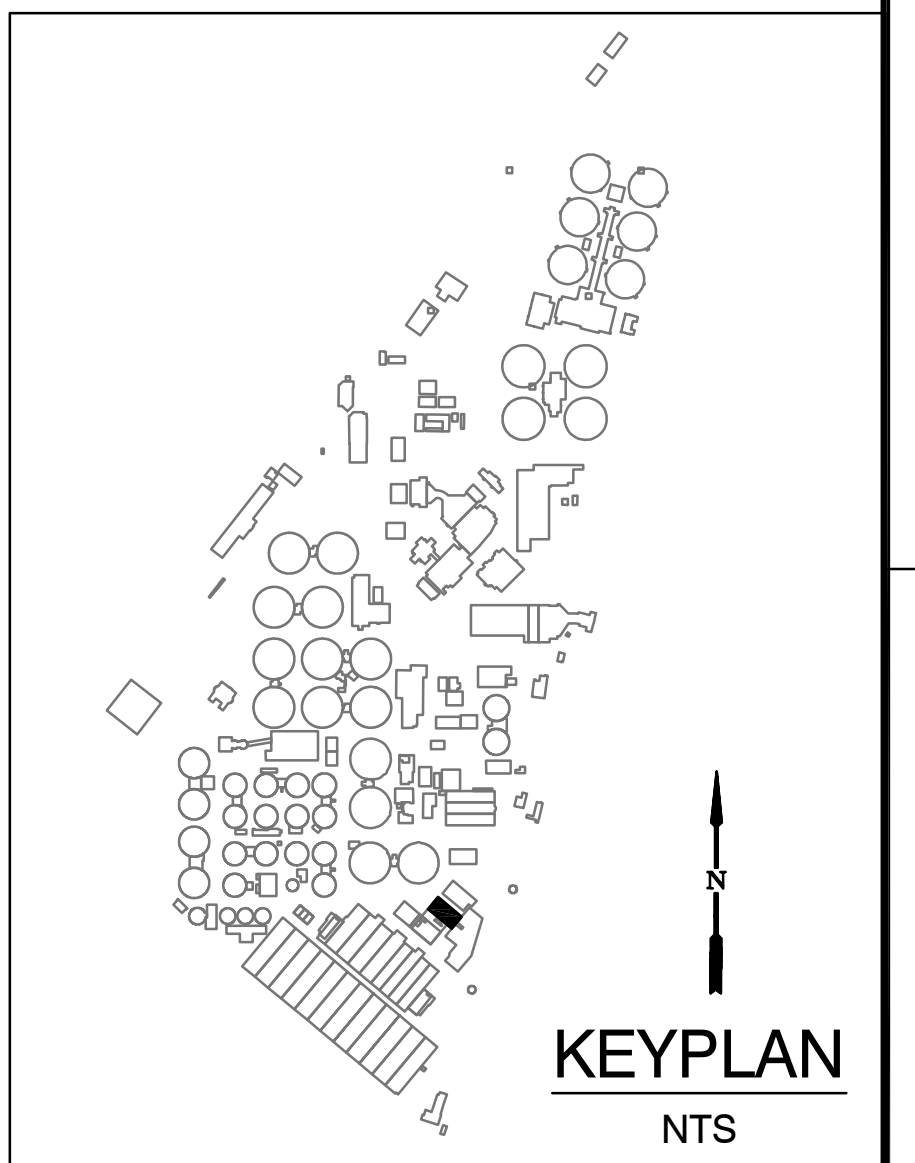

DWG: j:\Facility Models\Architectural\Plant 2\FINAL FLOOR PLANS\DWG\P2-00-A-FLOOR-DSTB-01.dwg
 DATE: Feb 20, 2014 9:22am
 USER: wwide
 XREFS: BASELINE-GUDDK

MARK	DESCRIPTION	DATE	APPR.

DESIGNED BY: _____
 DRAWN BY: RT - 06/13
 CHECKED BY: _____
 LINE IS 2 INCHES
 AT FULL SIZE
 (IF NOT 2" - SCALE ACCORDINGLY)

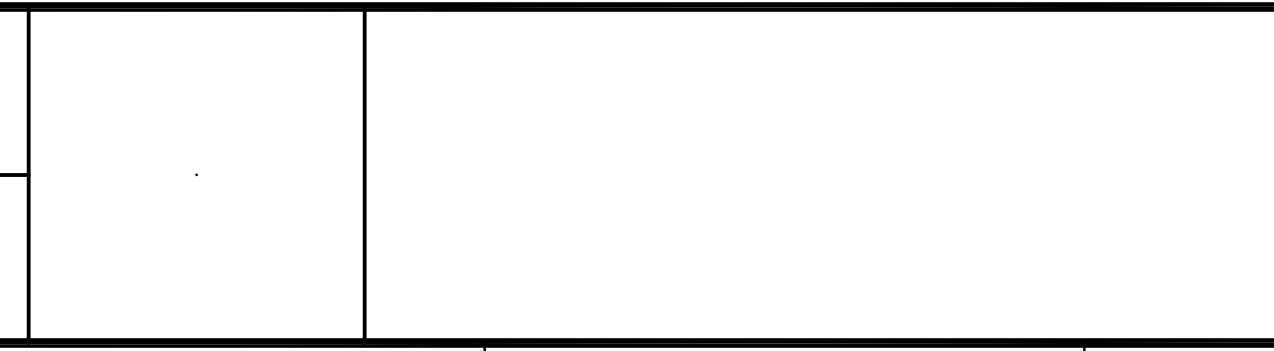


**ORANGE COUNTY
SANITATION DISTRICT**

PLANT NO. 2
 BASELINE BUILDING FLOOR PLAN
**12KV DISTRIBUTION CENTER B
 FIRST FLOOR
 LAYOUT PLAN**


PROJECT NO. BASELINE
 DRAWING NO. _____
 OF _____

LOOP TAG LOCATION
28IRROOM__

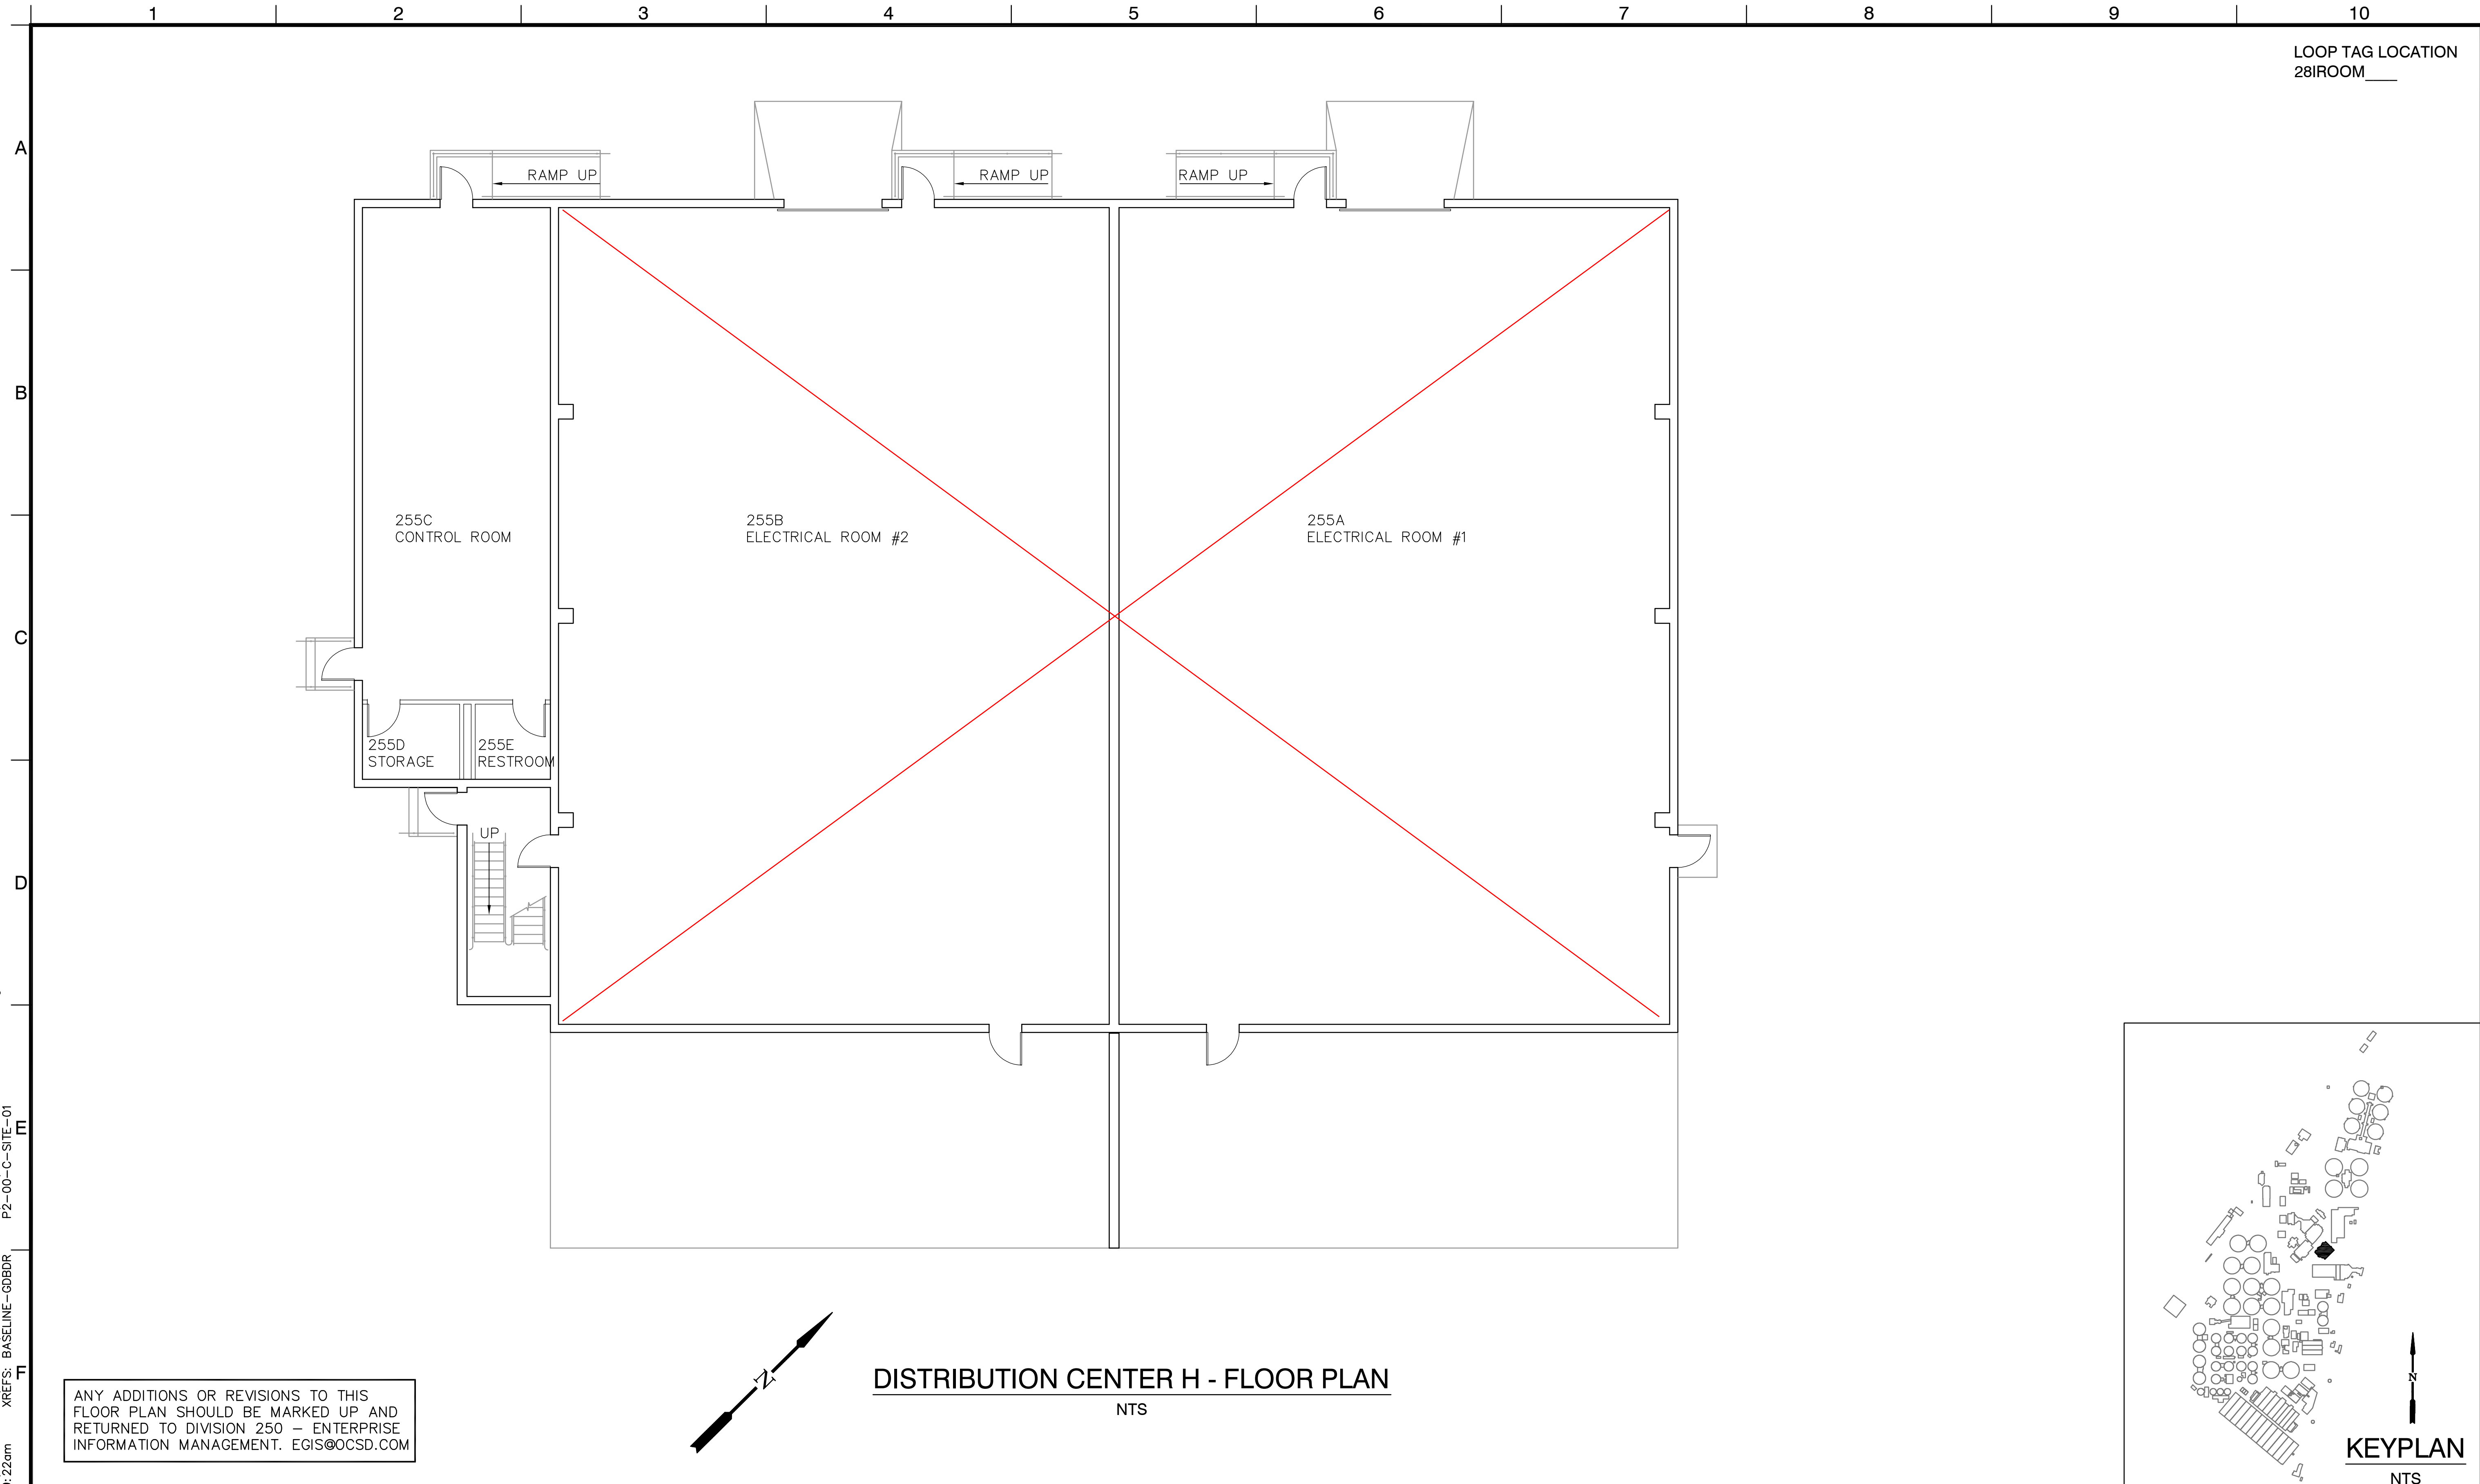


ANY ADDITIONS OR REVISIONS TO THIS FLOOR PLAN SHOULD BE MARKED UP AND RETURNED TO DIVISION 250 - ENTERPRISE INFORMATION MANAGEMENT. EGIS@OCSD.COM

DISTRIBUTION CENTER H - FLOOR PLAN
NTS

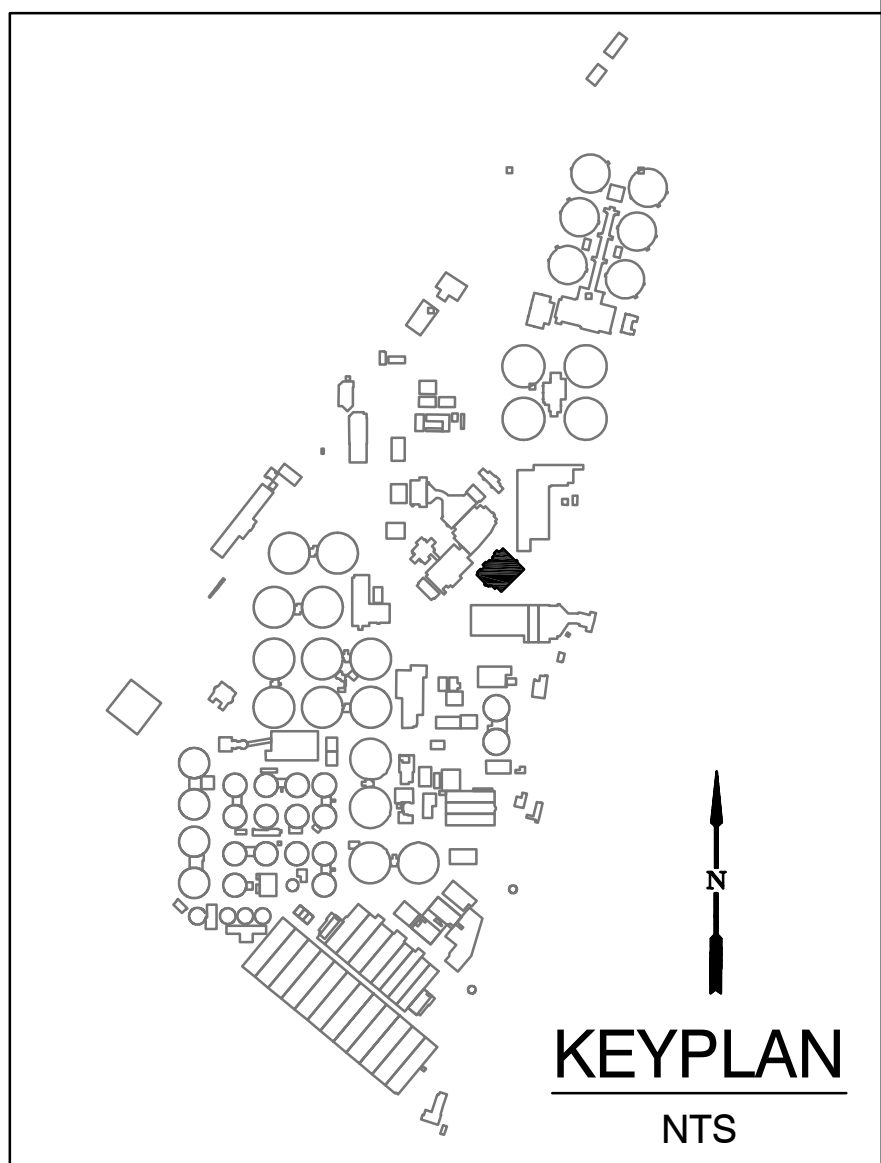

DWG: j:\Facility Models\Architectural\Plant 2\FINAL FLOOR PLANS\DWG\P2-00-A-FLOR-DSTH-01.dwg
 DATE: Feb 20, 2014 9:22am
 USER: wrwide
 XREFS: BASELINE-GUDDK P2-00-C-SITE-01

DESIGNED BY: _____
 DRAWN BY: RT - 06/13
 CHECKED BY: _____
 LINE IS 2 INCHES
 AT FULL SIZE
 (IF NOT 2" - SCALE ACCORDINGLY)

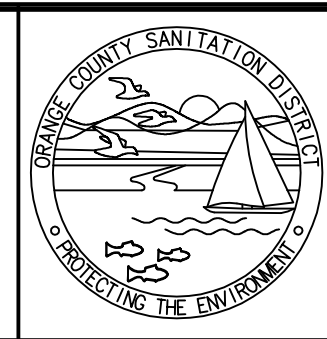


**ORANGE COUNTY
SANITATION DISTRICT**

PLANT NO. 2
 BASELINE BUILDING FLOOR PLAN
**DISTRIBUTION CENTER H
 FIRST FLOOR
 LAYOUT PLAN**


PROJECT NO. BASELINE
 DRAWING NO. _____
 OF _____

MARK	DESCRIPTION	DATE	APPR.


LOOP TAG LOCATION
28KROOM _____

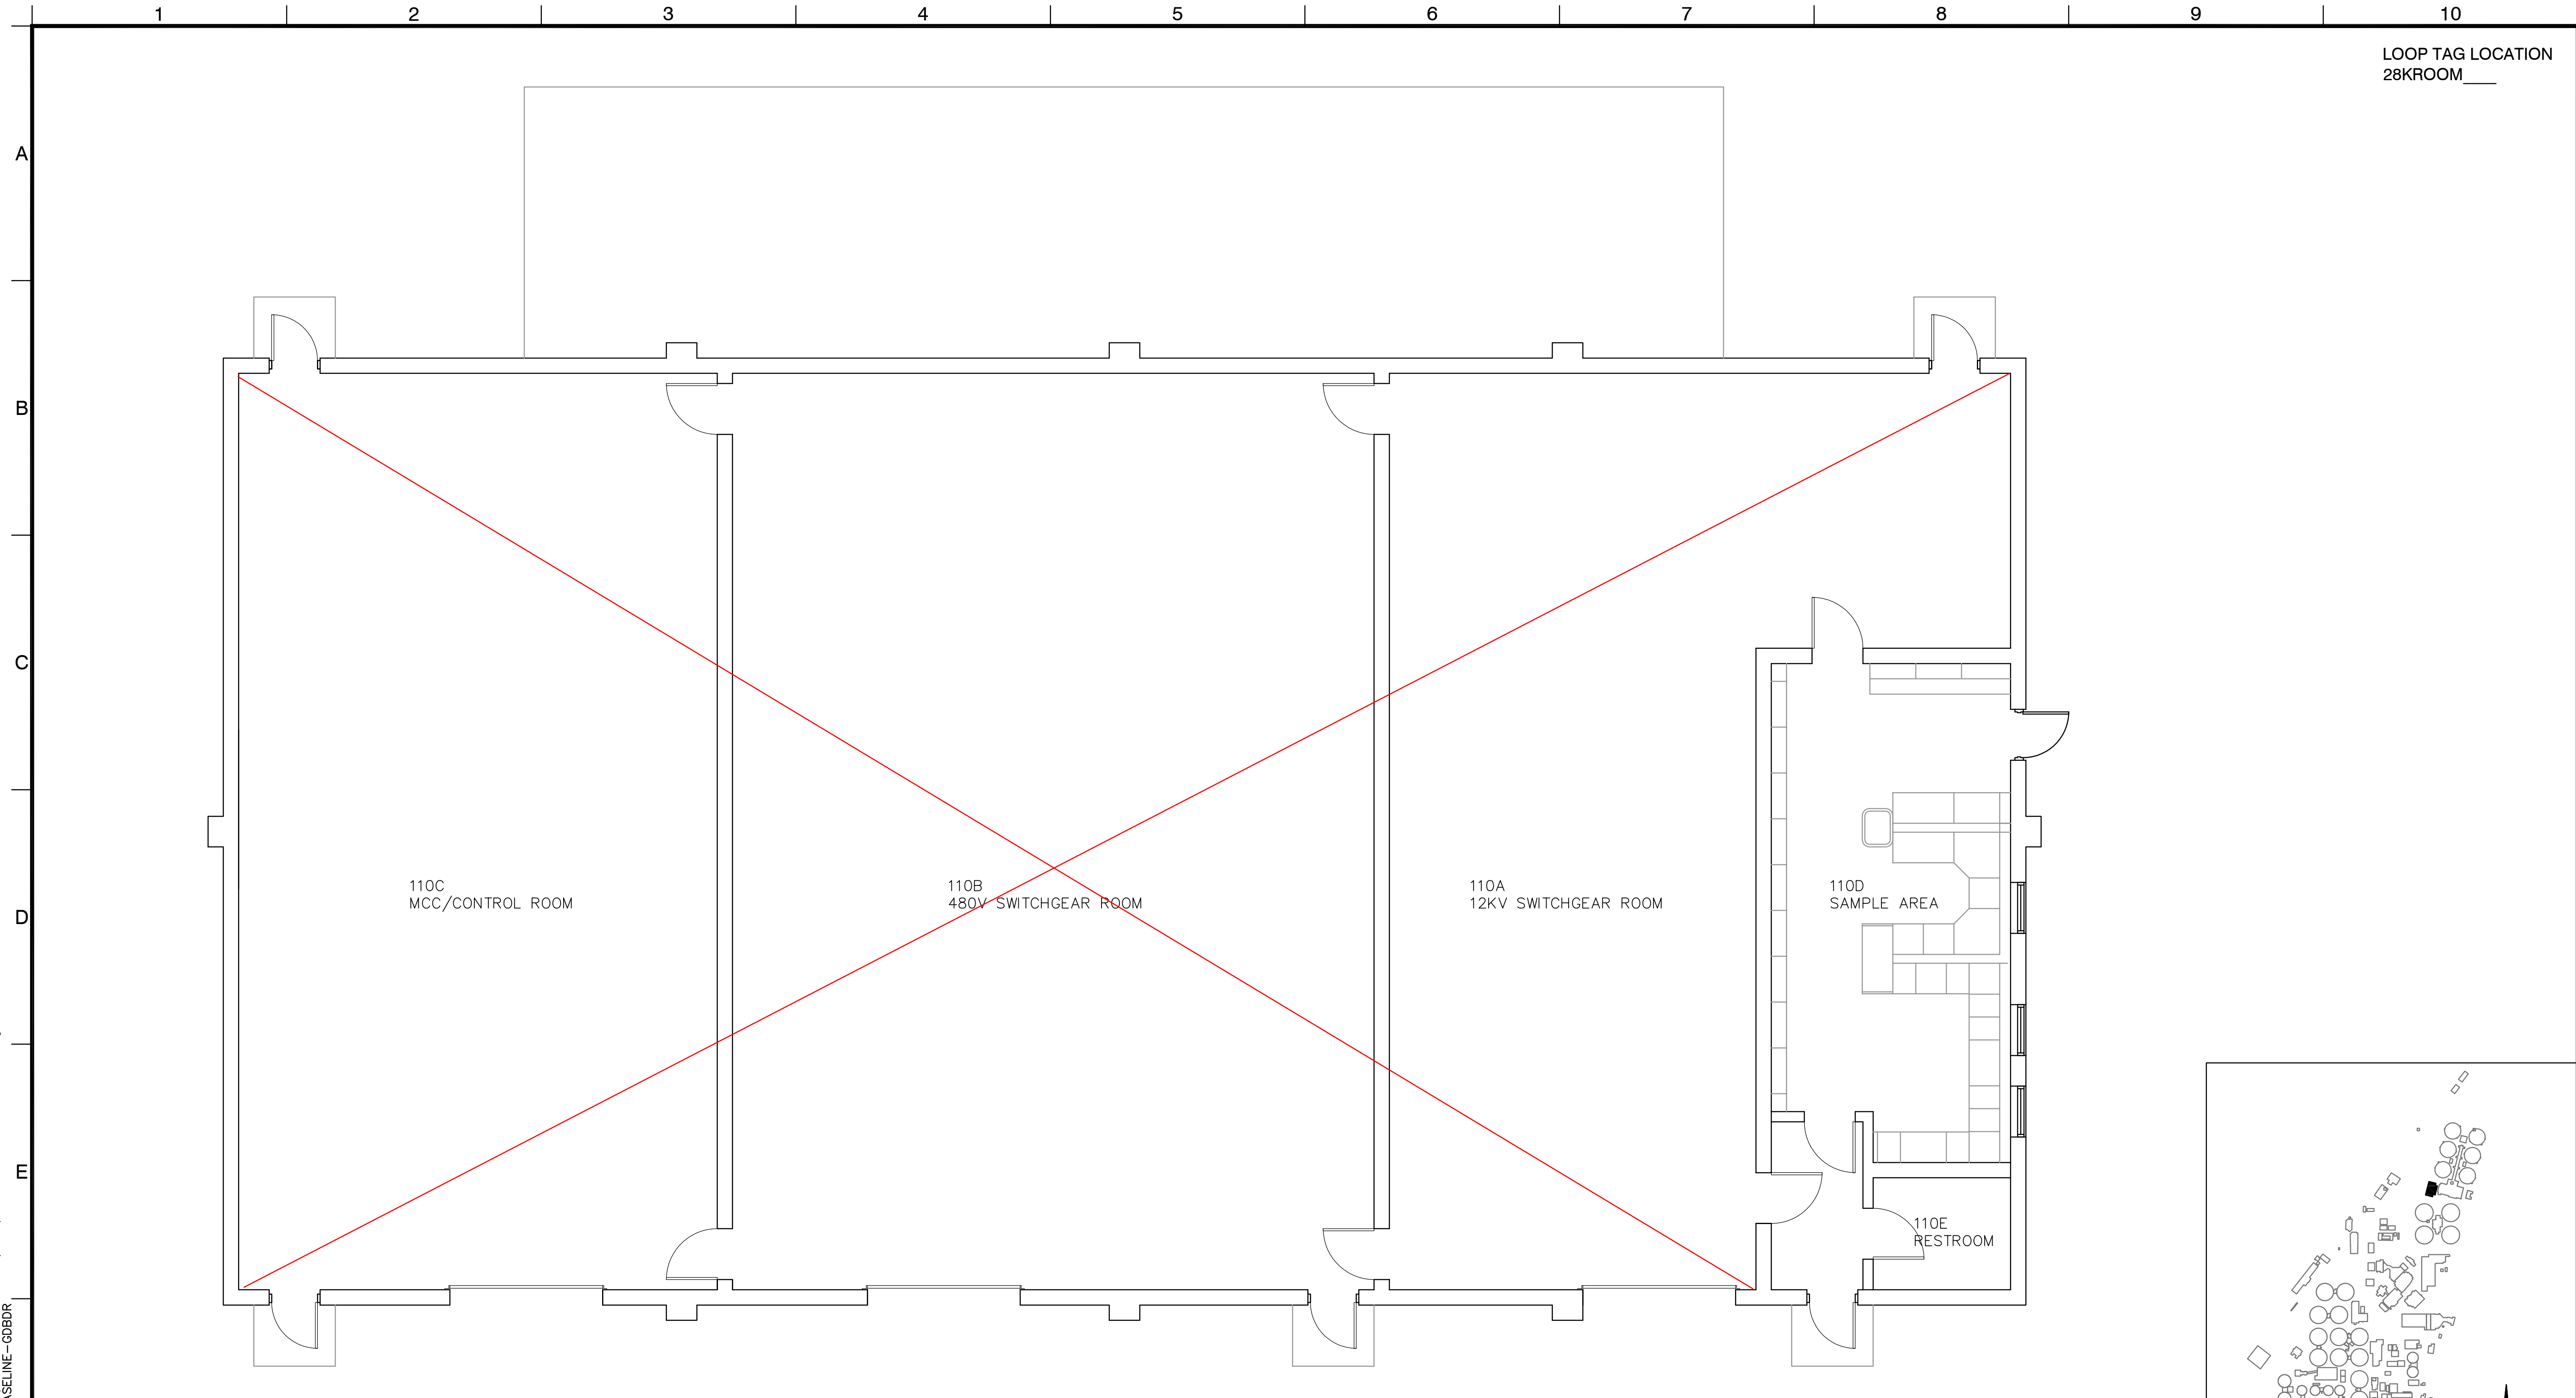

ANY ADDITIONS OR REVISIONS TO THIS FLOOR PLAN SHOULD BE MARKED UP AND RETURNED TO DIVISION 250 - ENTERPRISE INFORMATION MANAGEMENT. EGIS@OCSD.COM

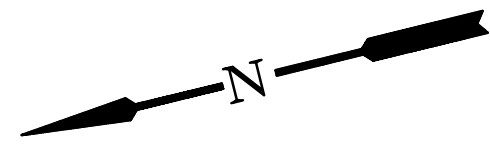


DISTRIBUTION CENTER "J" - FIRST FLOOR PLAN
NTS

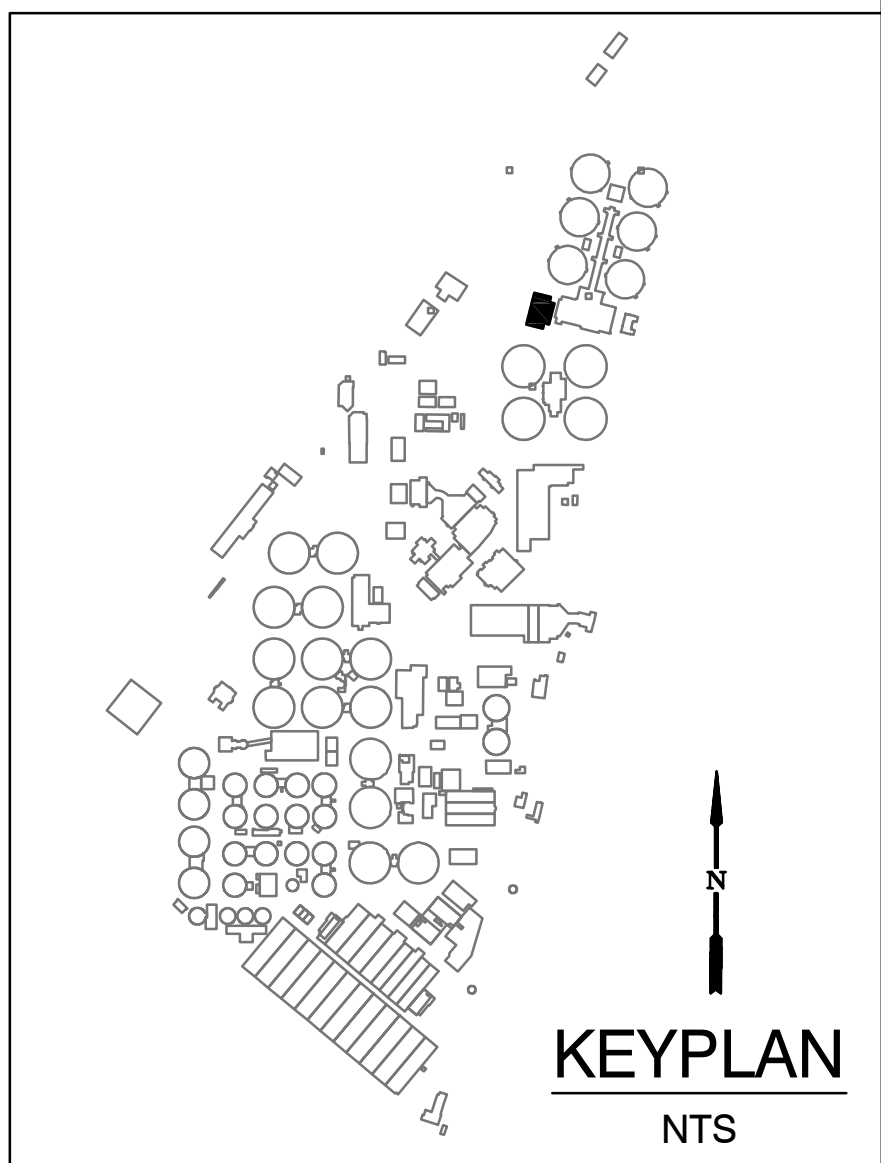

DWG: j:\Facility Models\Architectural\Plant 2\FINAL FLOOR PLANS\DWG\P2-00-A-FLOOR-DSTJ-01.dwg
 DATE: Feb 20, 2014 9:22am
 USER: wrilde
 XREFS: BASELINE-G000K

MARK	DESCRIPTION	DATE	APPR.

DESIGNED BY: _____
 DRAWN BY: RT - 06/13
 CHECKED BY: _____
 LINE IS 2 INCHES
 AT FULL SIZE
 (IF NOT 2" - SCALE ACCORDINGLY)

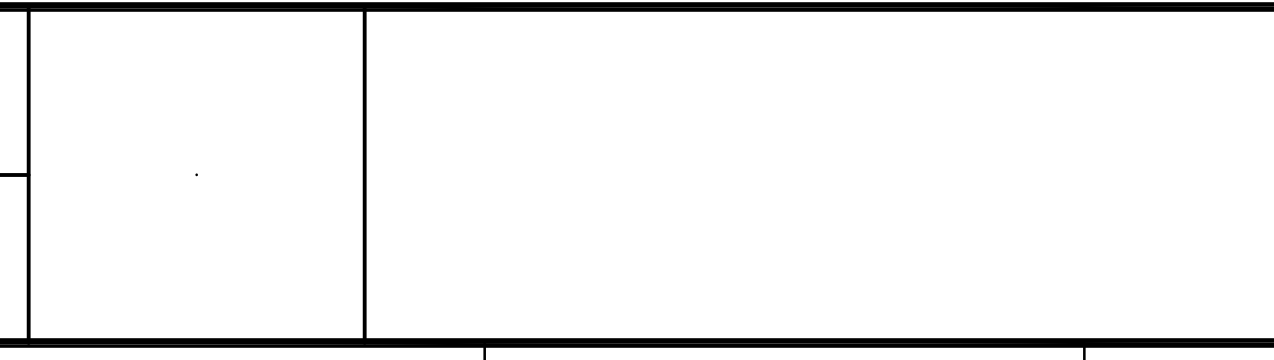


**ORANGE COUNTY
SANITATION DISTRICT**

PLANT NO. 2
 BASELINE BUILDING FLOOR PLAN
**DISTRIBUTION CENTER J
 FIRST FLOOR
 LAYOUT PLAN**

PROJECT NO. BASELINE
 DRAWING NO. _____
 OF _____


LOOP TAG LOCATION
22CROOM___

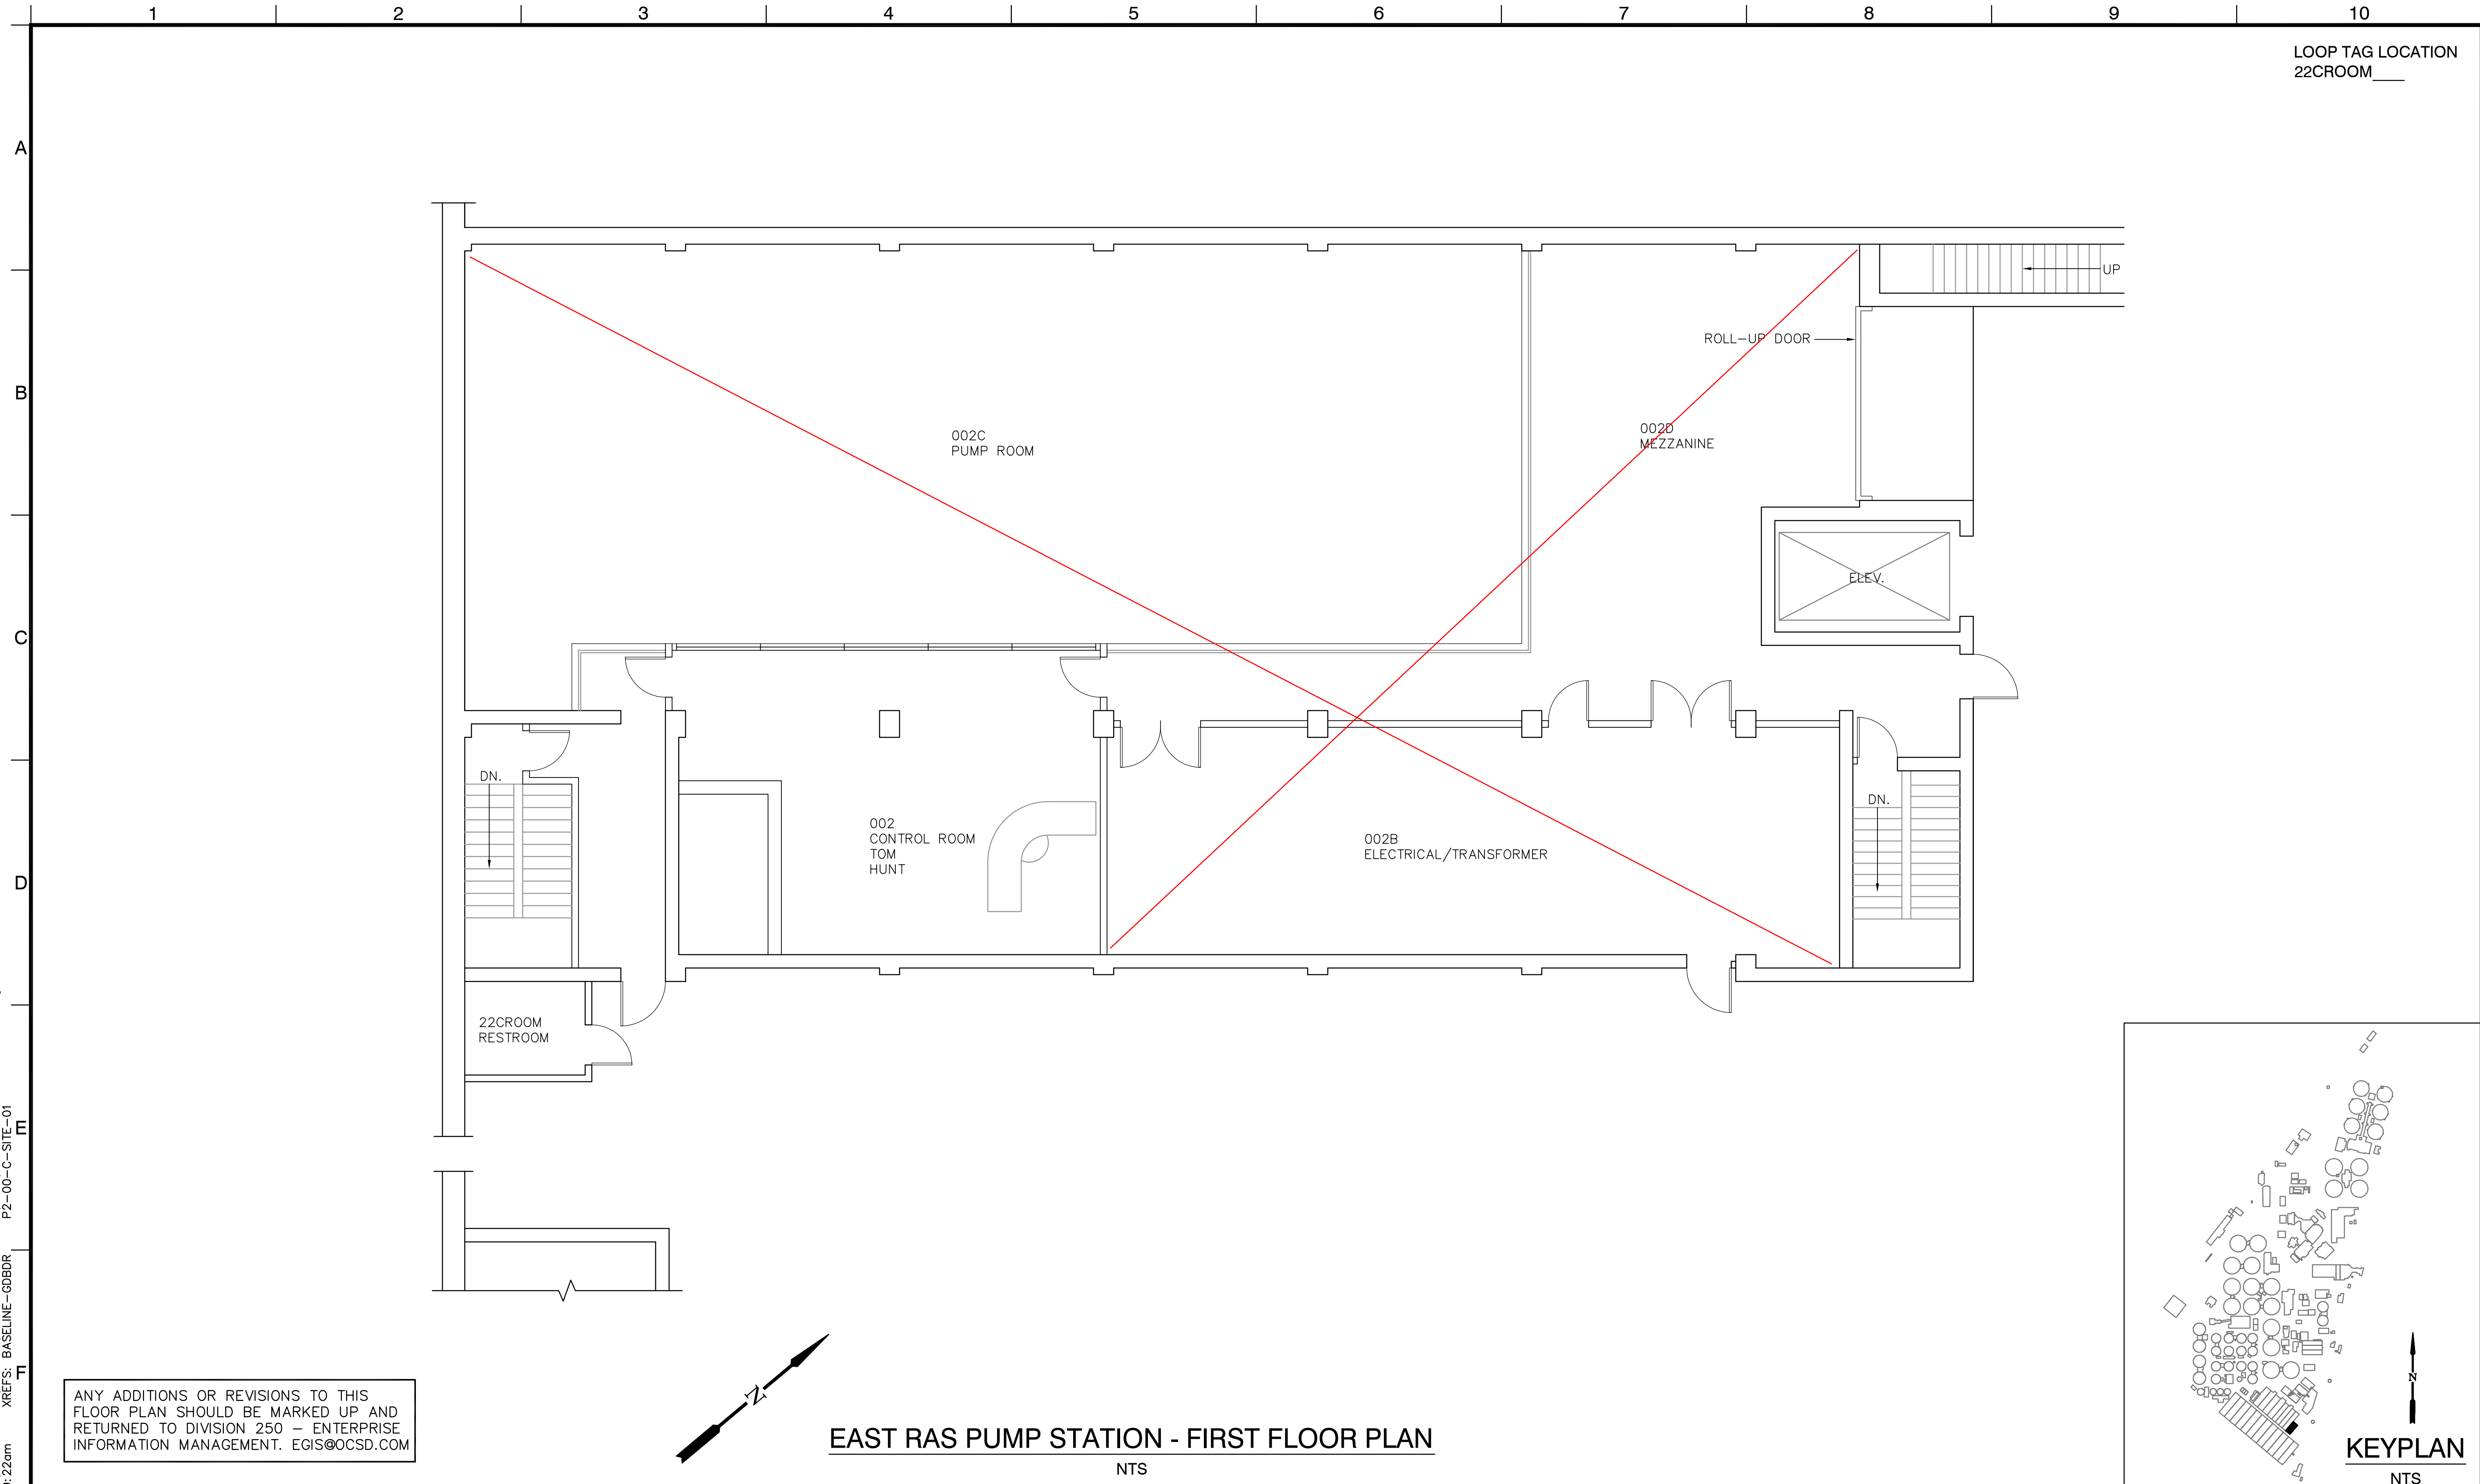

ANY ADDITIONS OR REVISIONS TO THIS FLOOR PLAN SHOULD BE MARKED UP AND RETURNED TO DIVISION 250 - ENTERPRISE INFORMATION MANAGEMENT. EGIS@OCSD.COM

EAST RAS PUMP STATION - FIRST FLOOR PLAN

NTS

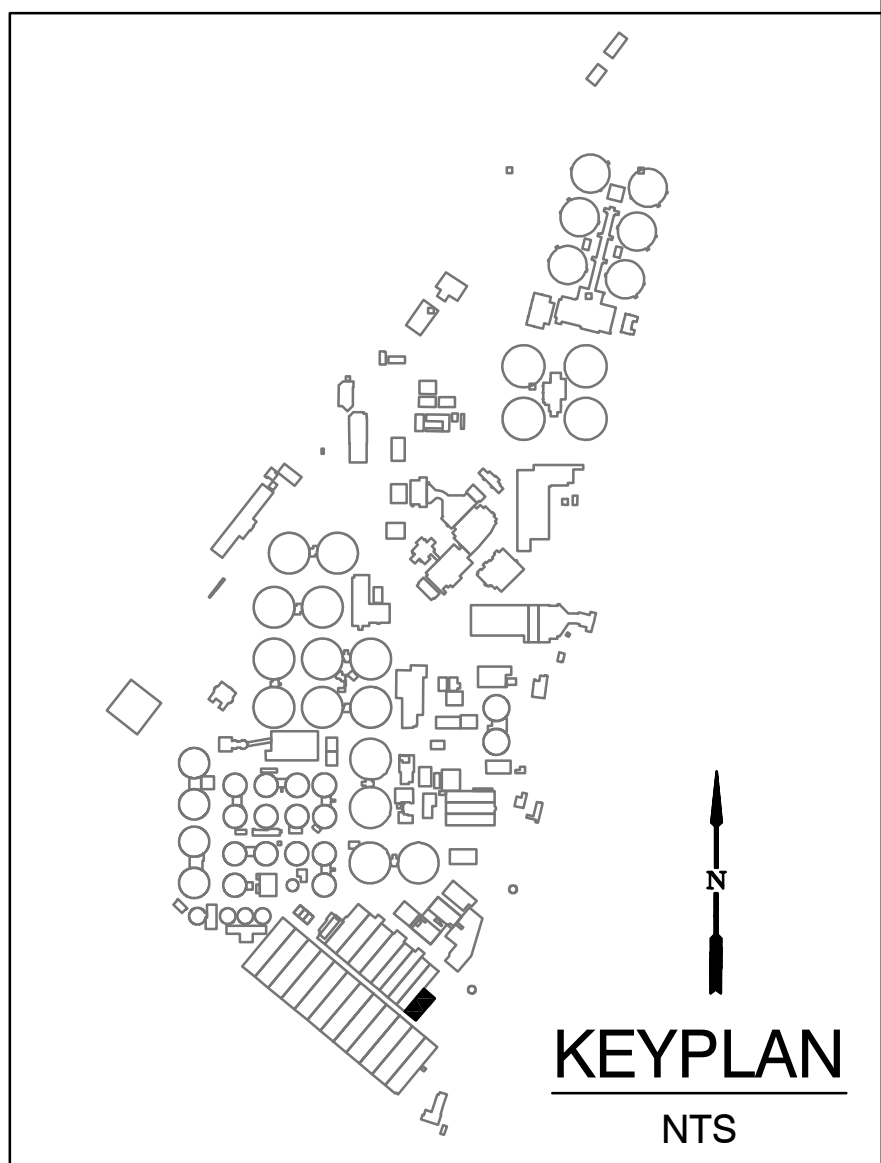


KEYPLAN

NTS

DWG: j:\Facility Models\Architectural\Plant 2\FINAL FLOOR PLANS\DWG\P2-00-A-FLOOR-ERAS-01.dwg
 DATE: Feb 20, 2014 9:22am
 USER: wrwide
 XREFS: BASELINE-GBBDR P2-00-C-SITE-01

MARK	DESCRIPTION	DATE	APPR.

DESIGNED BY: _____
 DRAWN BY: RT - 06/13
 CHECKED BY: _____
 LINE IS 2 INCHES
 AT FULL SIZE
 (IF NOT 2"=SCALE ACCORDINGLY)

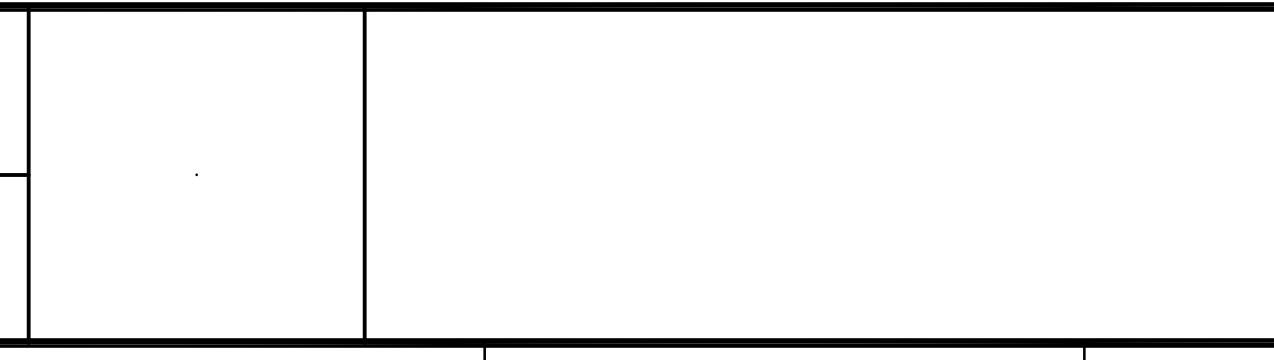

**ORANGE COUNTY
SANITATION DISTRICT**

PLANT NO. 2
 BASELINE BUILDING FLOOR PLAN
**EAST RAS PUMP STATION
 FIRST FLOOR
 LAYOUT PLAN**

PROJECT NO. BASELINE
 DRAWING NO. _____
 OF _____

MAINTENANCE BUILDING - FIRST FLOOR

LOOP TAG NUMBER 29KROOM_____



KEY MAP
NTS


DIVISION

- 820
- 870 / 880
- Water Dispenser
- Fire Extinguisher
- First Aid

ADDITIONS OR REVISIONS TO THIS FLOOR PLAN SHOULD BE MARKED UP AND RETURNED TO DIVISION 250 - ENTERPIRSE INFORMATION MANAGEMENT. EGIS@OCS.D.COM



ORANGE COUNTY
SANITATION DISTRICT

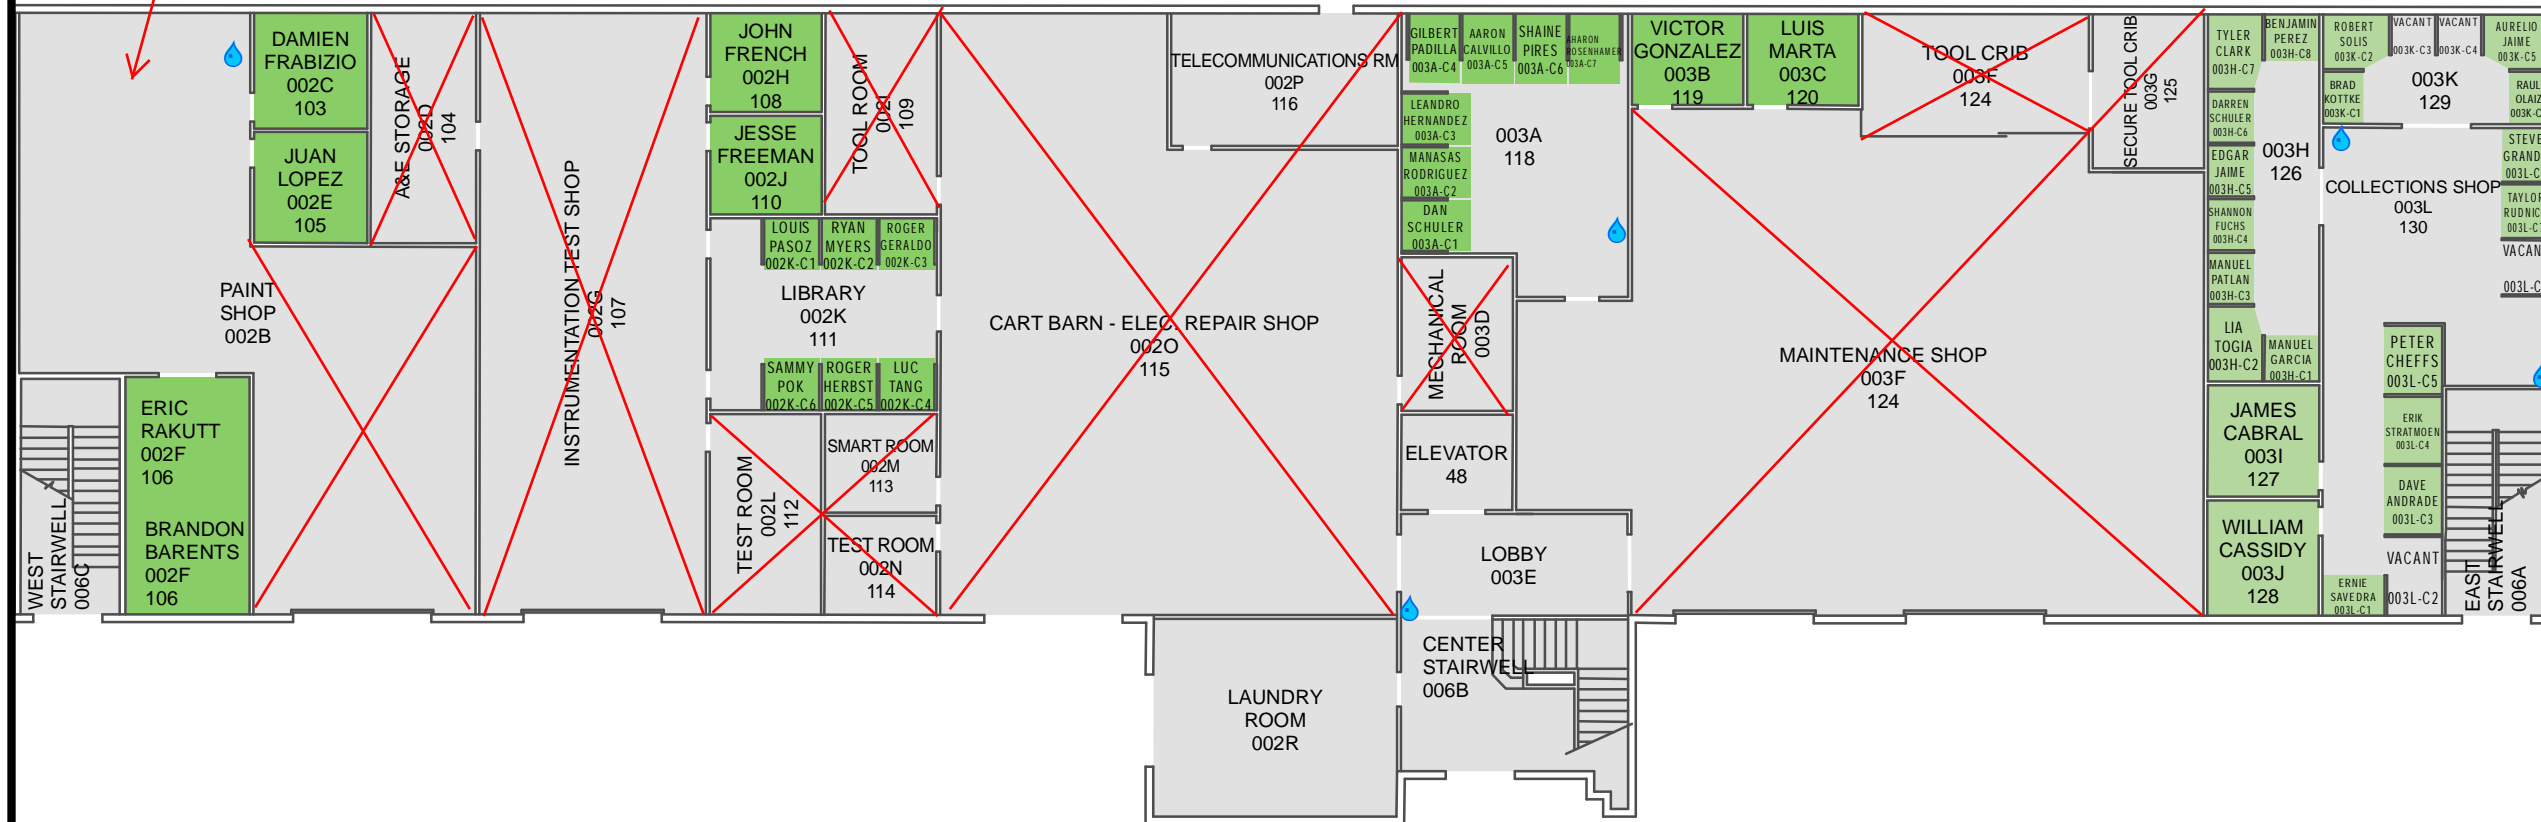


29KSTRC001

MAINTENANCE BUILDING - SECOND FLOOR

LOOP TAG NUMBER 29KROOM_____



KEY MAP
NTS

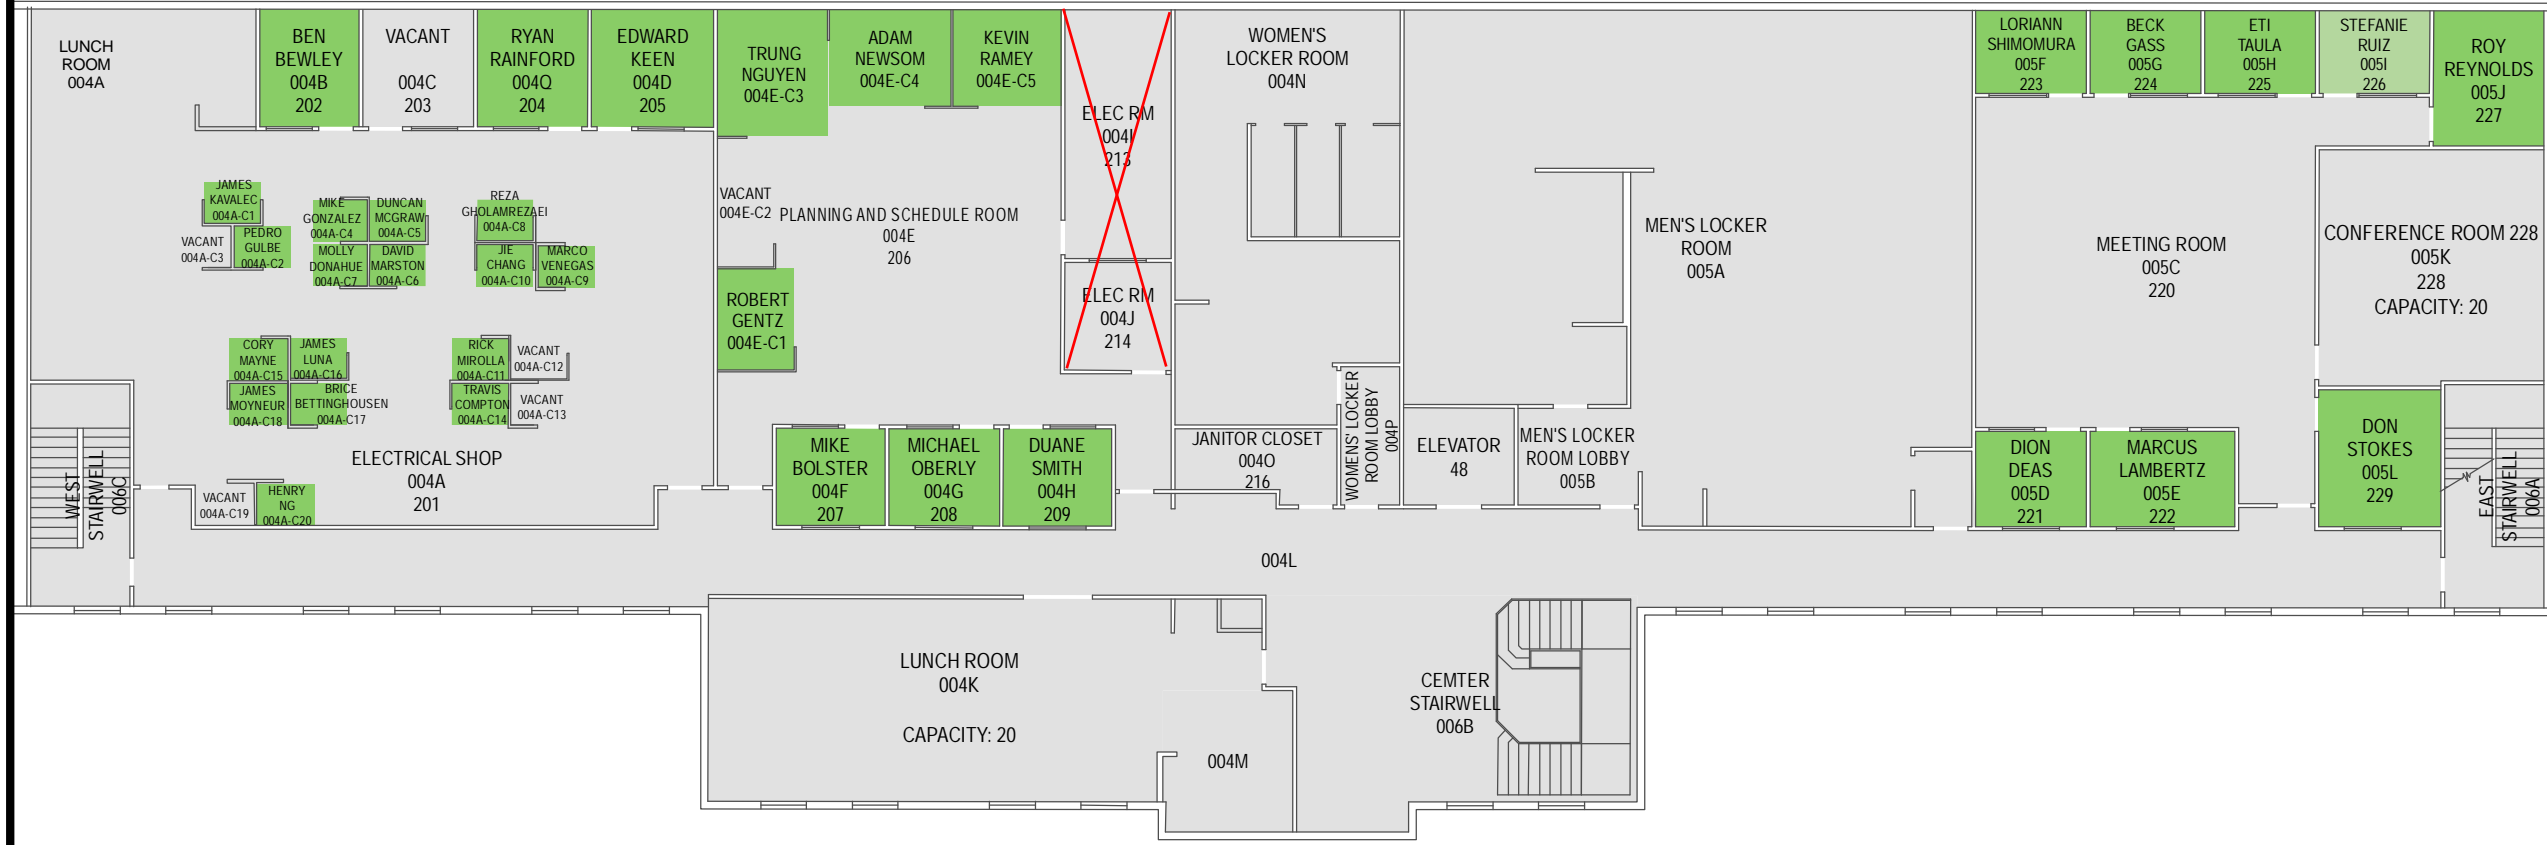


DIVISION

110	610	820
120	620	822
140	630	840
160	710	880
161	740	
210	750	
220	760	
230	770	
250	810	

ADDITIONS OR REVISIONS TO THIS FLOOR PLAN SHOULD BE MARKED UP AND RETURNED TO DIVISION 250 - ENTERPIRSE INFORMATION MANAGEMENT. EGIS@OCS.D.COM




ORANGE COUNTY
SANITATION DISTRICT

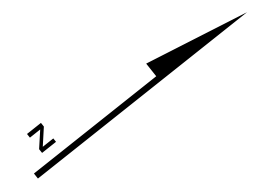


OPERATIONS CENTER - FIRST FLOOR

LOOP TAG NUMBER 29 ROOM _____

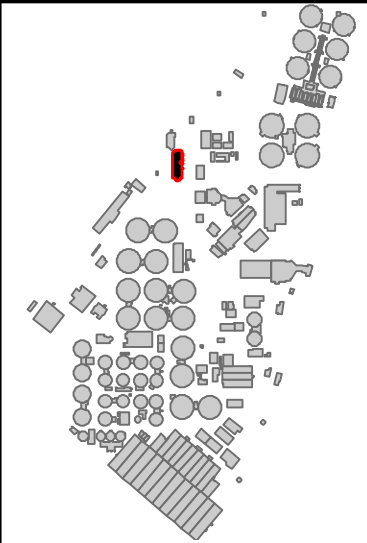

KEY MAP
NTS

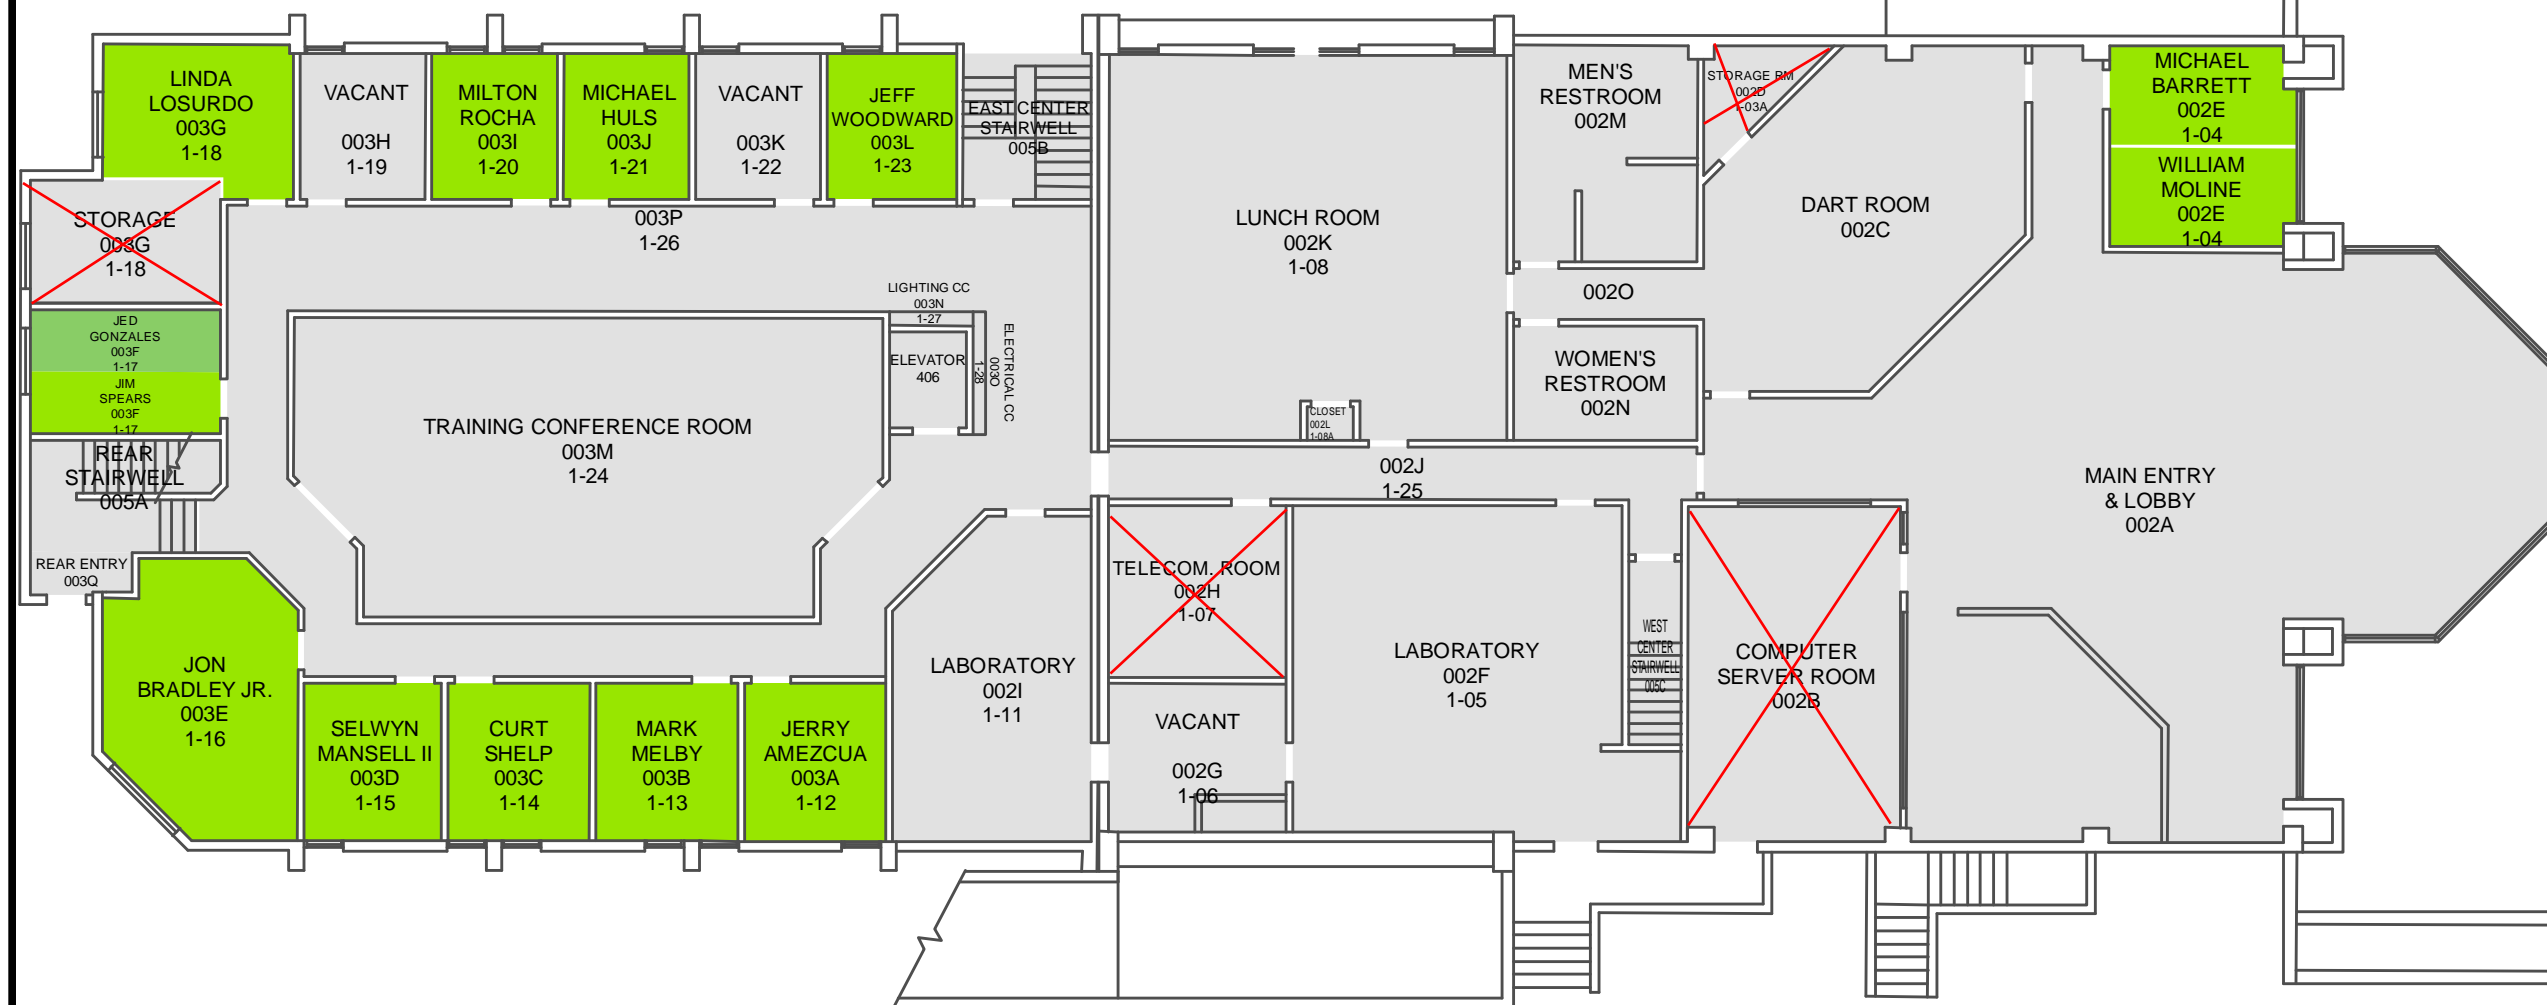

DIVISION

110	610	820
120	620	822
140	630	840
160	710	880
161	740	
210	750	
220	760	
230	770	
250	810	

ADDITIONS OR REVISIONS TO THIS FLOOR PLAN SHOULD BE MARKED UP AND RETURNED TO DIVISION 250 - ENTERPRISE INFORMATION MANAGEMENT. EGIS@OCS.D.COM





ORANGE COUNTY
SANITATION DISTRICT



OPERATIONS CENTER - BASEMENT

LOOP TAG NUMBER 29EROOM_____

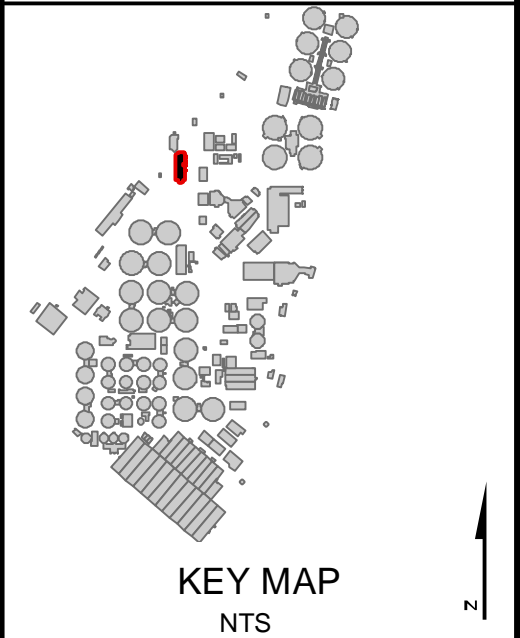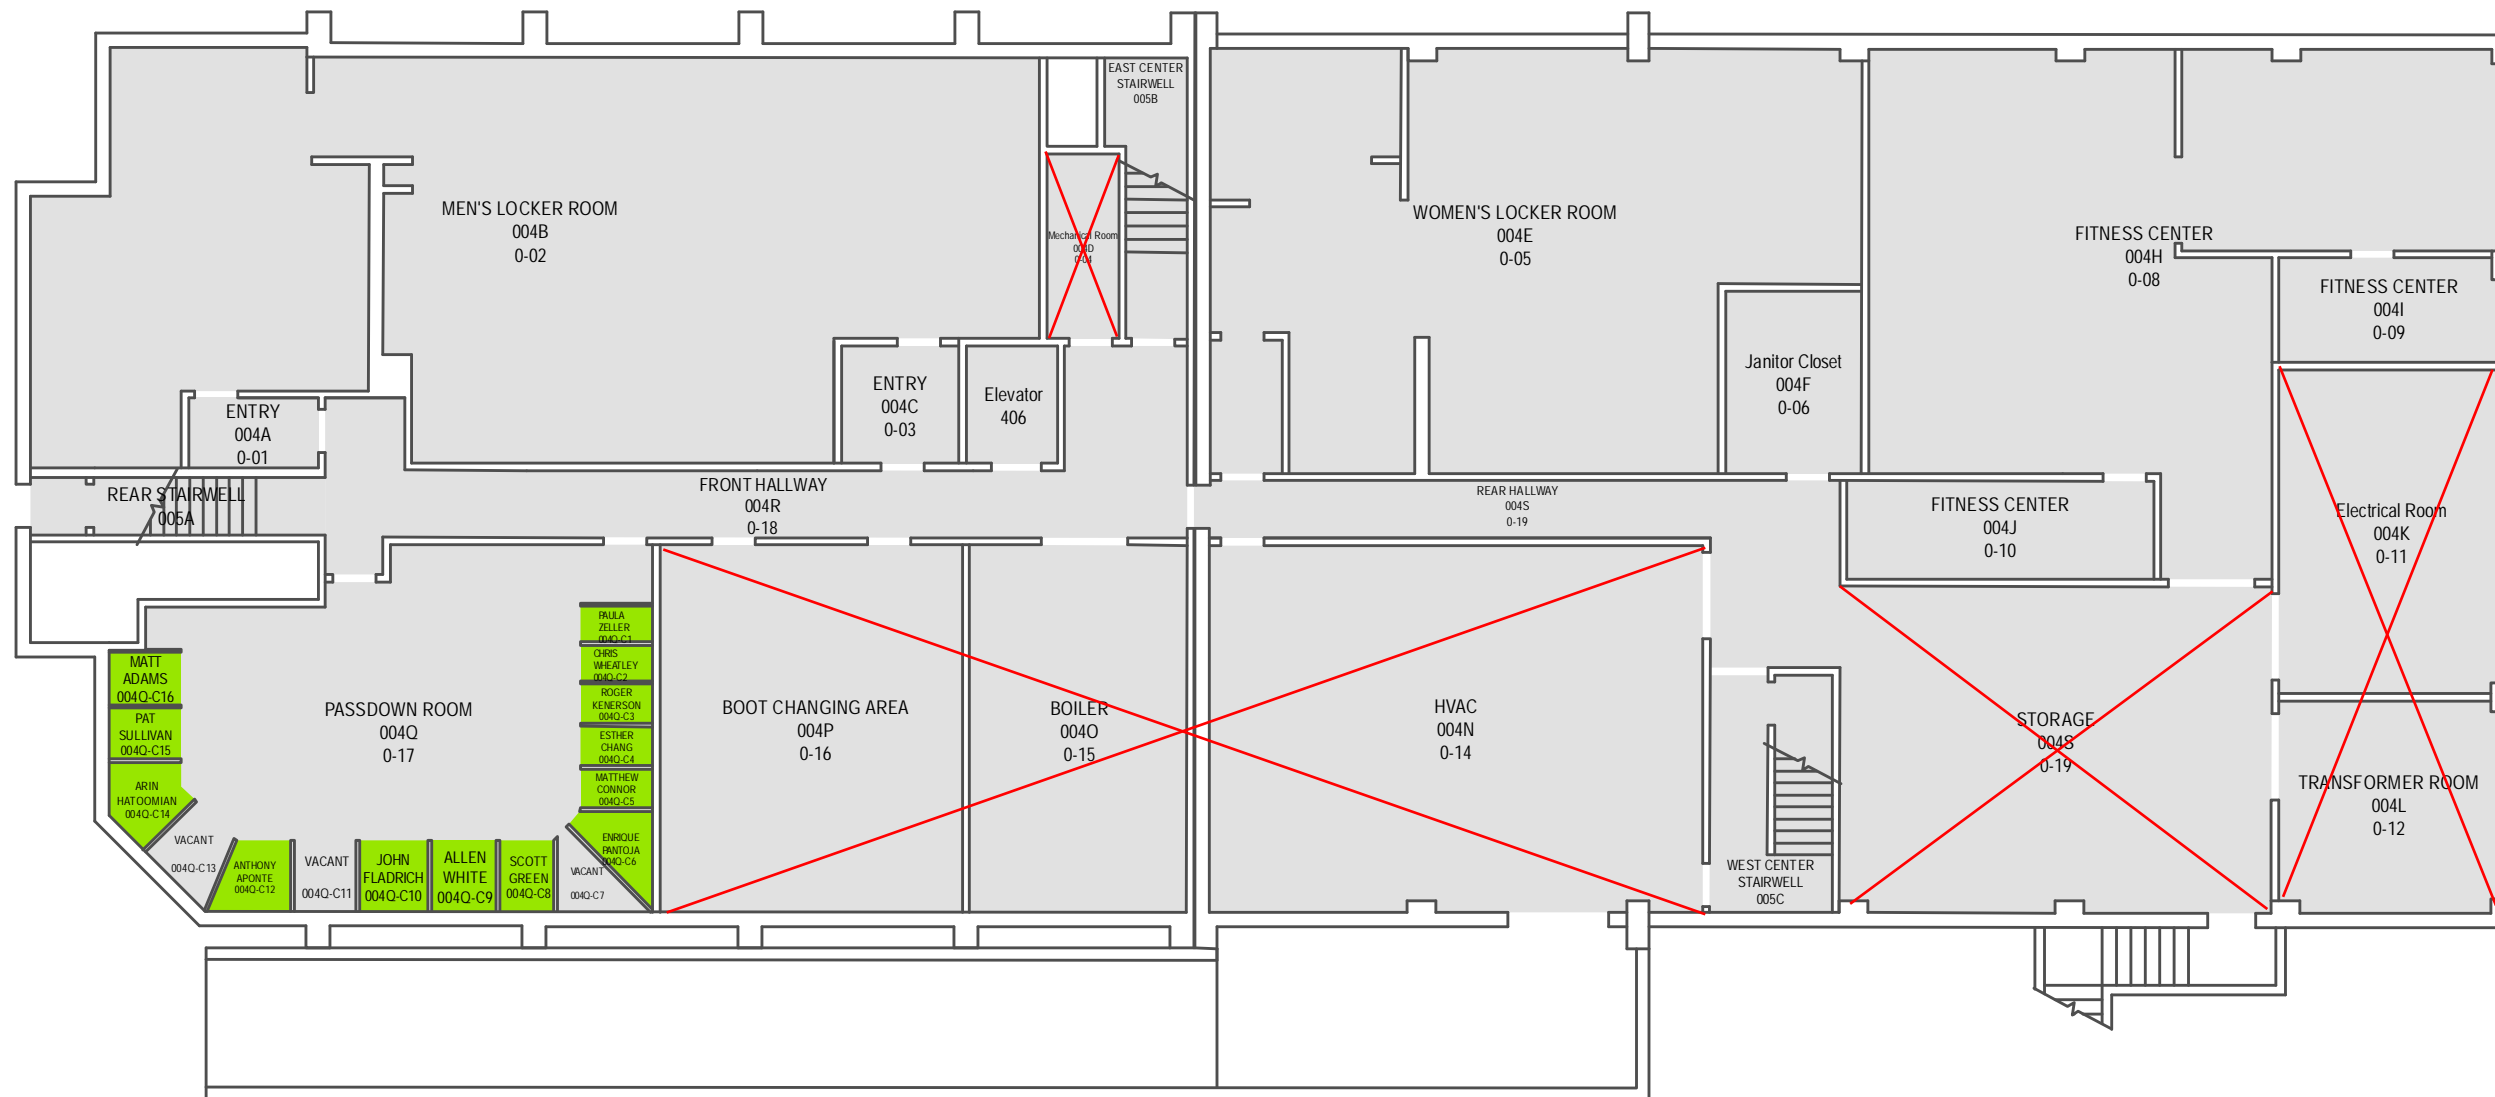

DIVISION

110	610	820
120	620	822
140	630	840
160	710	880
161	740	
210	750	
220	760	
230	770	
250	810	


ADDITIONS OR REVISIONS TO THIS FLOOR PLAN SHOULD BE MARKED UP AND RETURNED TO DIVISION 250 - ENTERPIRSE INFORMATION MANAGEMENT. EGIS@OCS.D.COM



**ORANGE COUNTY
SANITATION DISTRICT**




LOOP TAG LOCATION
25JROOM___

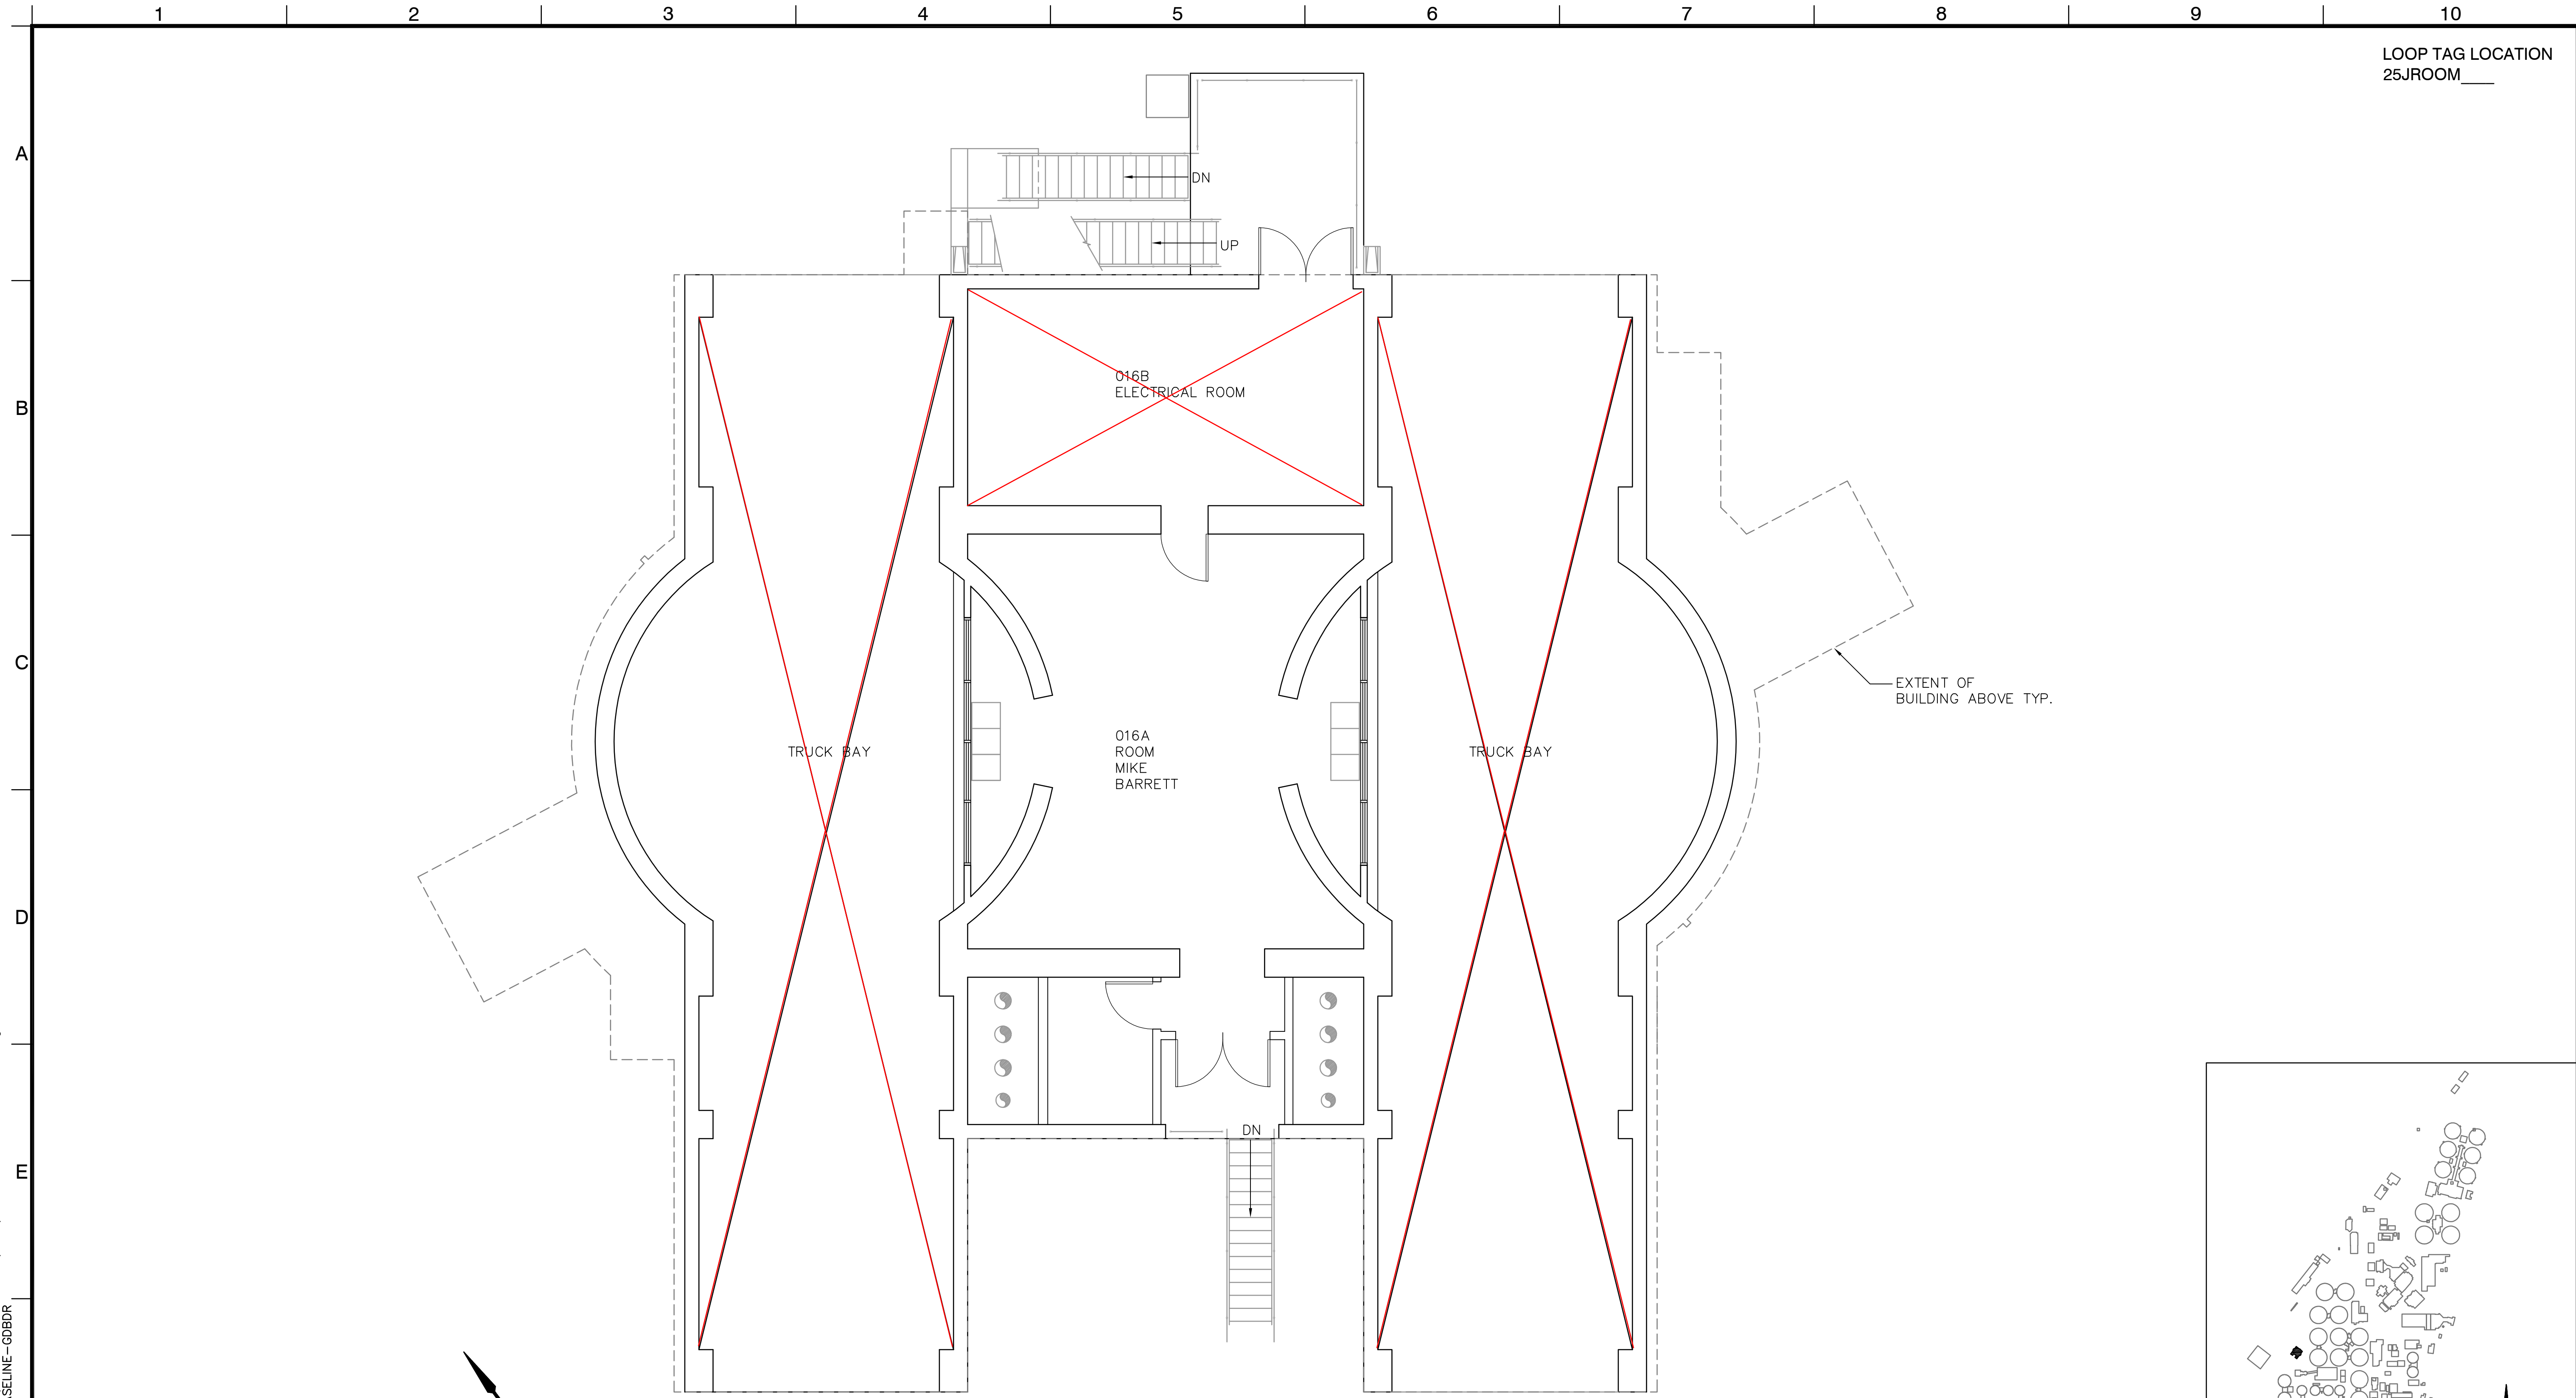

ANY ADDITIONS OR REVISIONS TO THIS FLOOR PLAN SHOULD BE MARKED UP AND RETURNED TO DIVISION 250 - ENTERPRISE INFORMATION MANAGEMENT. EGIS@OCSD.COM

SOLIDS STORAGE AND TRUCK LOADING - SECOND FLOOR PLAN


NTS

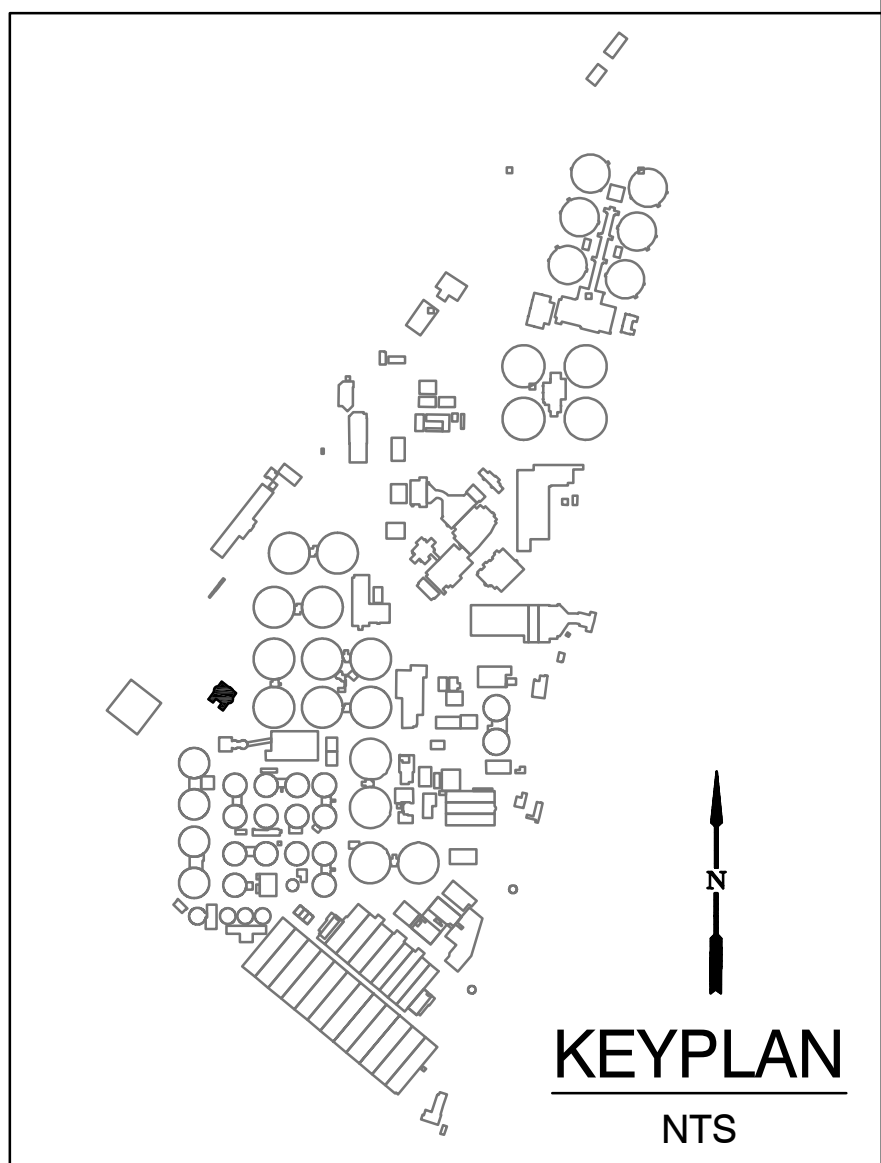

DWG: j:\Facility Models\Architectural\Plant 2\FINAL FLOOR PLANS\DWG\P2-00-A-FLOOR-SSTL-01.dwg
 DATE: Feb 20, 2014 9:21am
 USER: wrilde
 XREFS: BASELINE-GDBDR

MARK	DESCRIPTION	DATE	APPR.

DESIGNED BY: _____
 DRAWN BY: RT - 06/13
 CHECKED BY: _____
 LINE IS 2 INCHES
 AT FULL SIZE
 (IF NOT 2" - SCALE ACCORDINGLY)

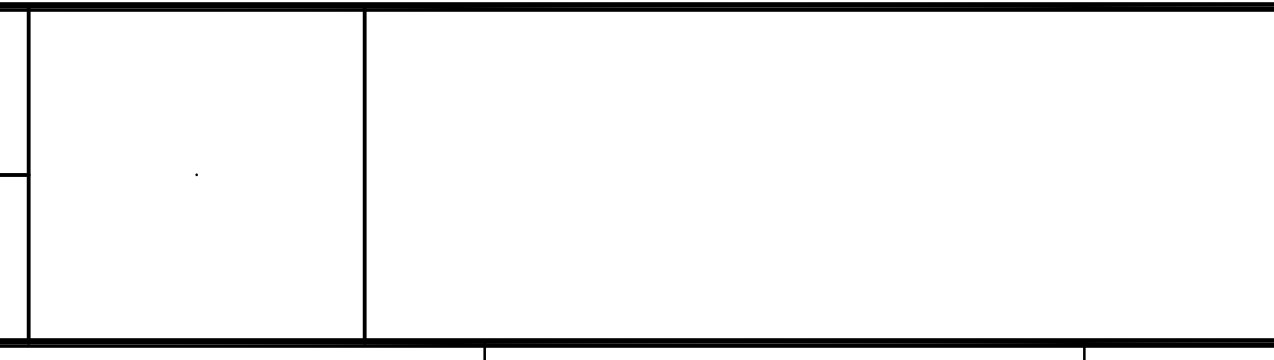


**ORANGE COUNTY
SANITATION DISTRICT**

PLANT NO. 2
 BASELINE BUILDING FLOOR PLAN
**SOLIDS STORAGE AND TRUCK
 LOADING FACILITY SECOND FLOOR
 LAYOUT PLAN**

PROJECT NO. BASELINE
 DRAWING NO. _____
 OF _____


LOOP TAG LOCATION
25JROOM___

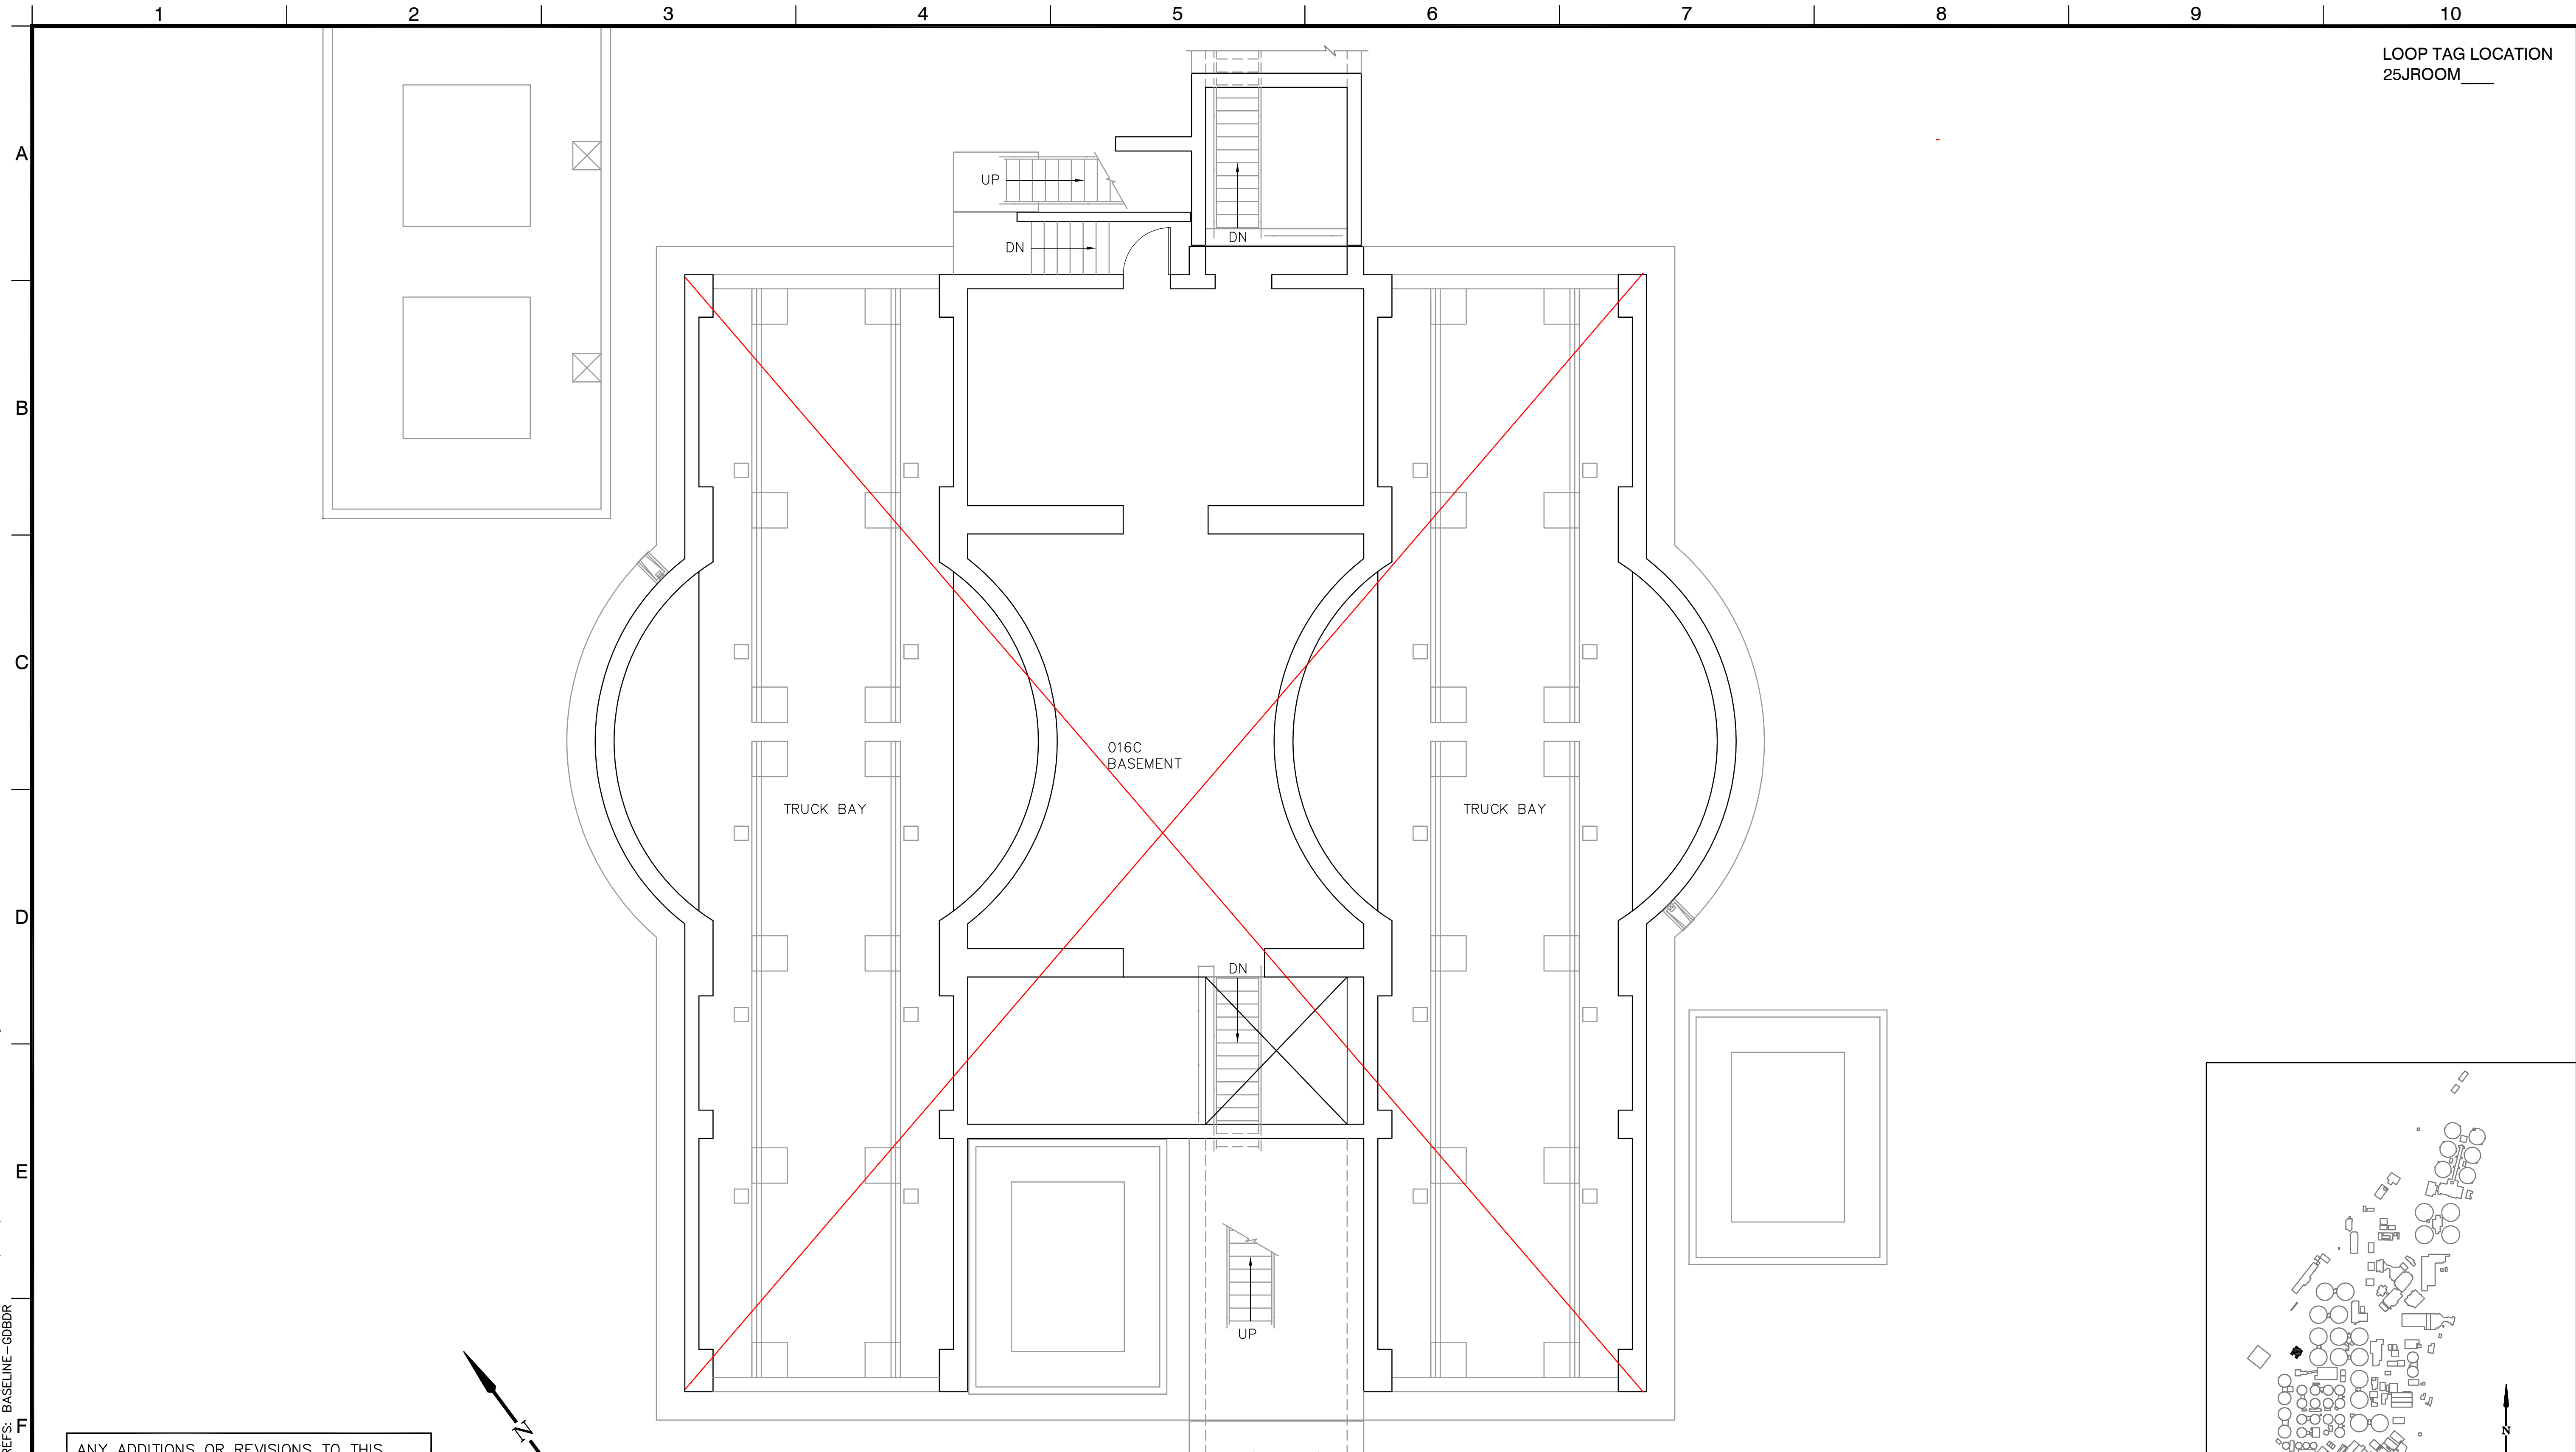

SOLIDS STORAGE AND TRUCK LOADING - BASEMENT PLAN

NTS


ANY ADDITIONS OR REVISIONS TO THIS FLOOR PLAN SHOULD BE MARKED UP AND RETURNED TO DIVISION 250 - ENTERPRISE INFORMATION MANAGEMENT. EGIS@OCSD.COM

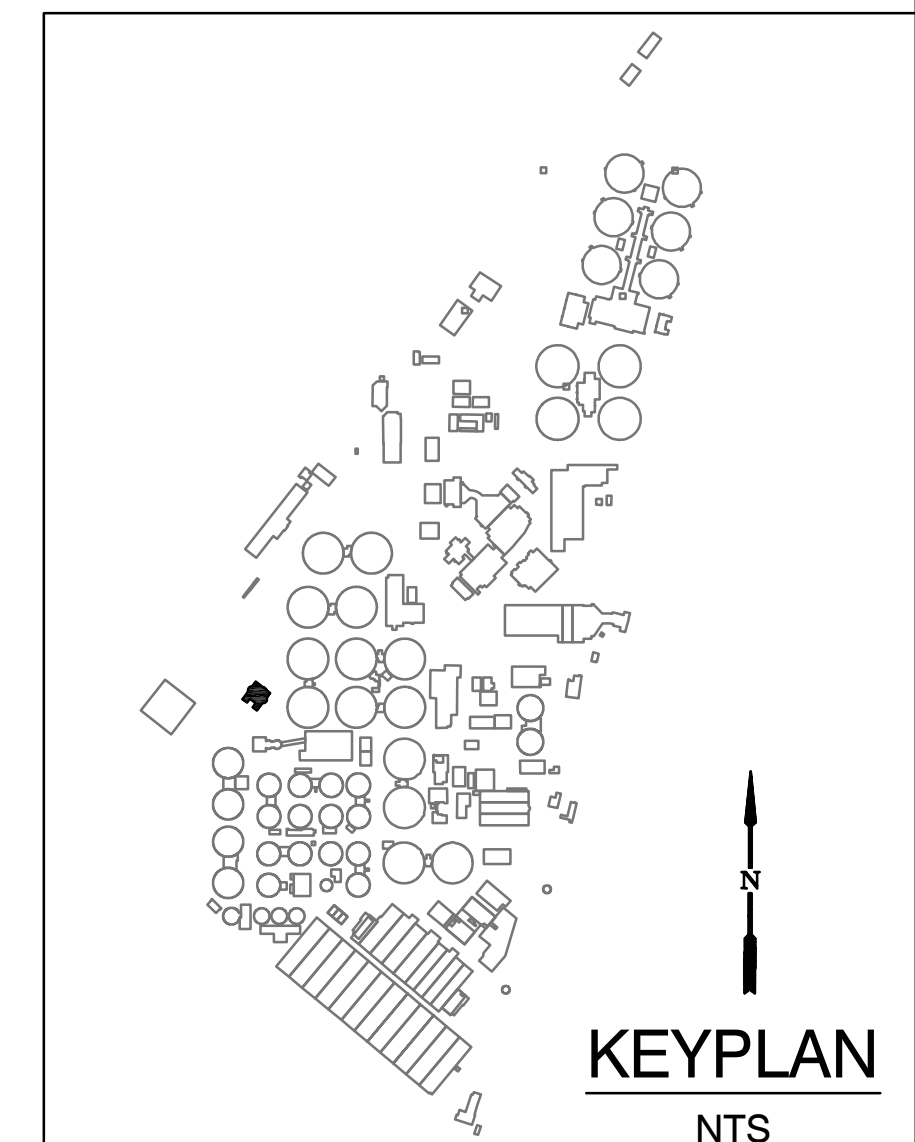

DWG: j:\Facility Models\Architectural\Plant_2\FINAL FLOOR PLANS\DWG\P2-00-A-FLOOR-SSTL-BA.dwg USER: wrfide
 DATE: Feb 20, 2014 9:21am XREFS: BASELINE-GDBDR

MARK	DESCRIPTION	DATE	APPR.

DESIGNED BY: _____
 DRAWN BY: RT - 06/13
 CHECKED BY: _____
 LINE IS 2 INCHES
 AT FULL SIZE
 (IF NOT 2" - SCALE ACCORDINGLY)

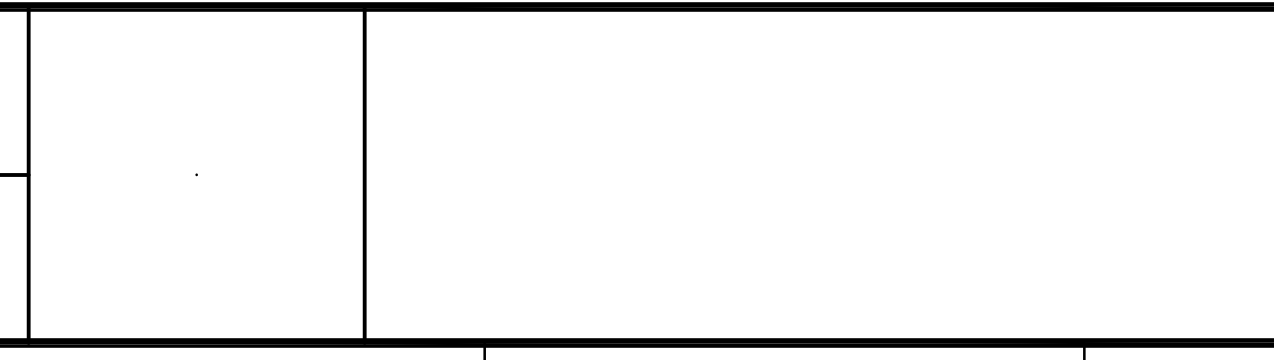

**ORANGE COUNTY
SANITATION DISTRICT**

PLANT NO. 2
 BASELINE BUILDING FLOOR PLAN
**SOLIDS STORAGE AND TRUCK
 LOADING FACILITY BASEMENT
 LAYOUT PLAN**

PROJECT NO. BASELINE
 DRAWING NO. _____
 OF _____

WAREHOUSE BUILDING - FIRST FLOOR

LOOP TAG NUMBER 29CROOM_____



KEY MAP
NTS




DIVISION

110	610	820
120	620	822
140	630	840
160	710	880
161	740	
210	750	
220	760	
230	770	
250	810	



ADDITIONS OR REVISIONS TO THIS FLOOR PLAN SHOULD BE MARKED UP AND RETURNED TO DIVISION 250 - ENTERPRISE INFORMATION MANAGEMENT. EGIS@OCS.D.COM



ORANGE COUNTY
SANITATION DISTRICT

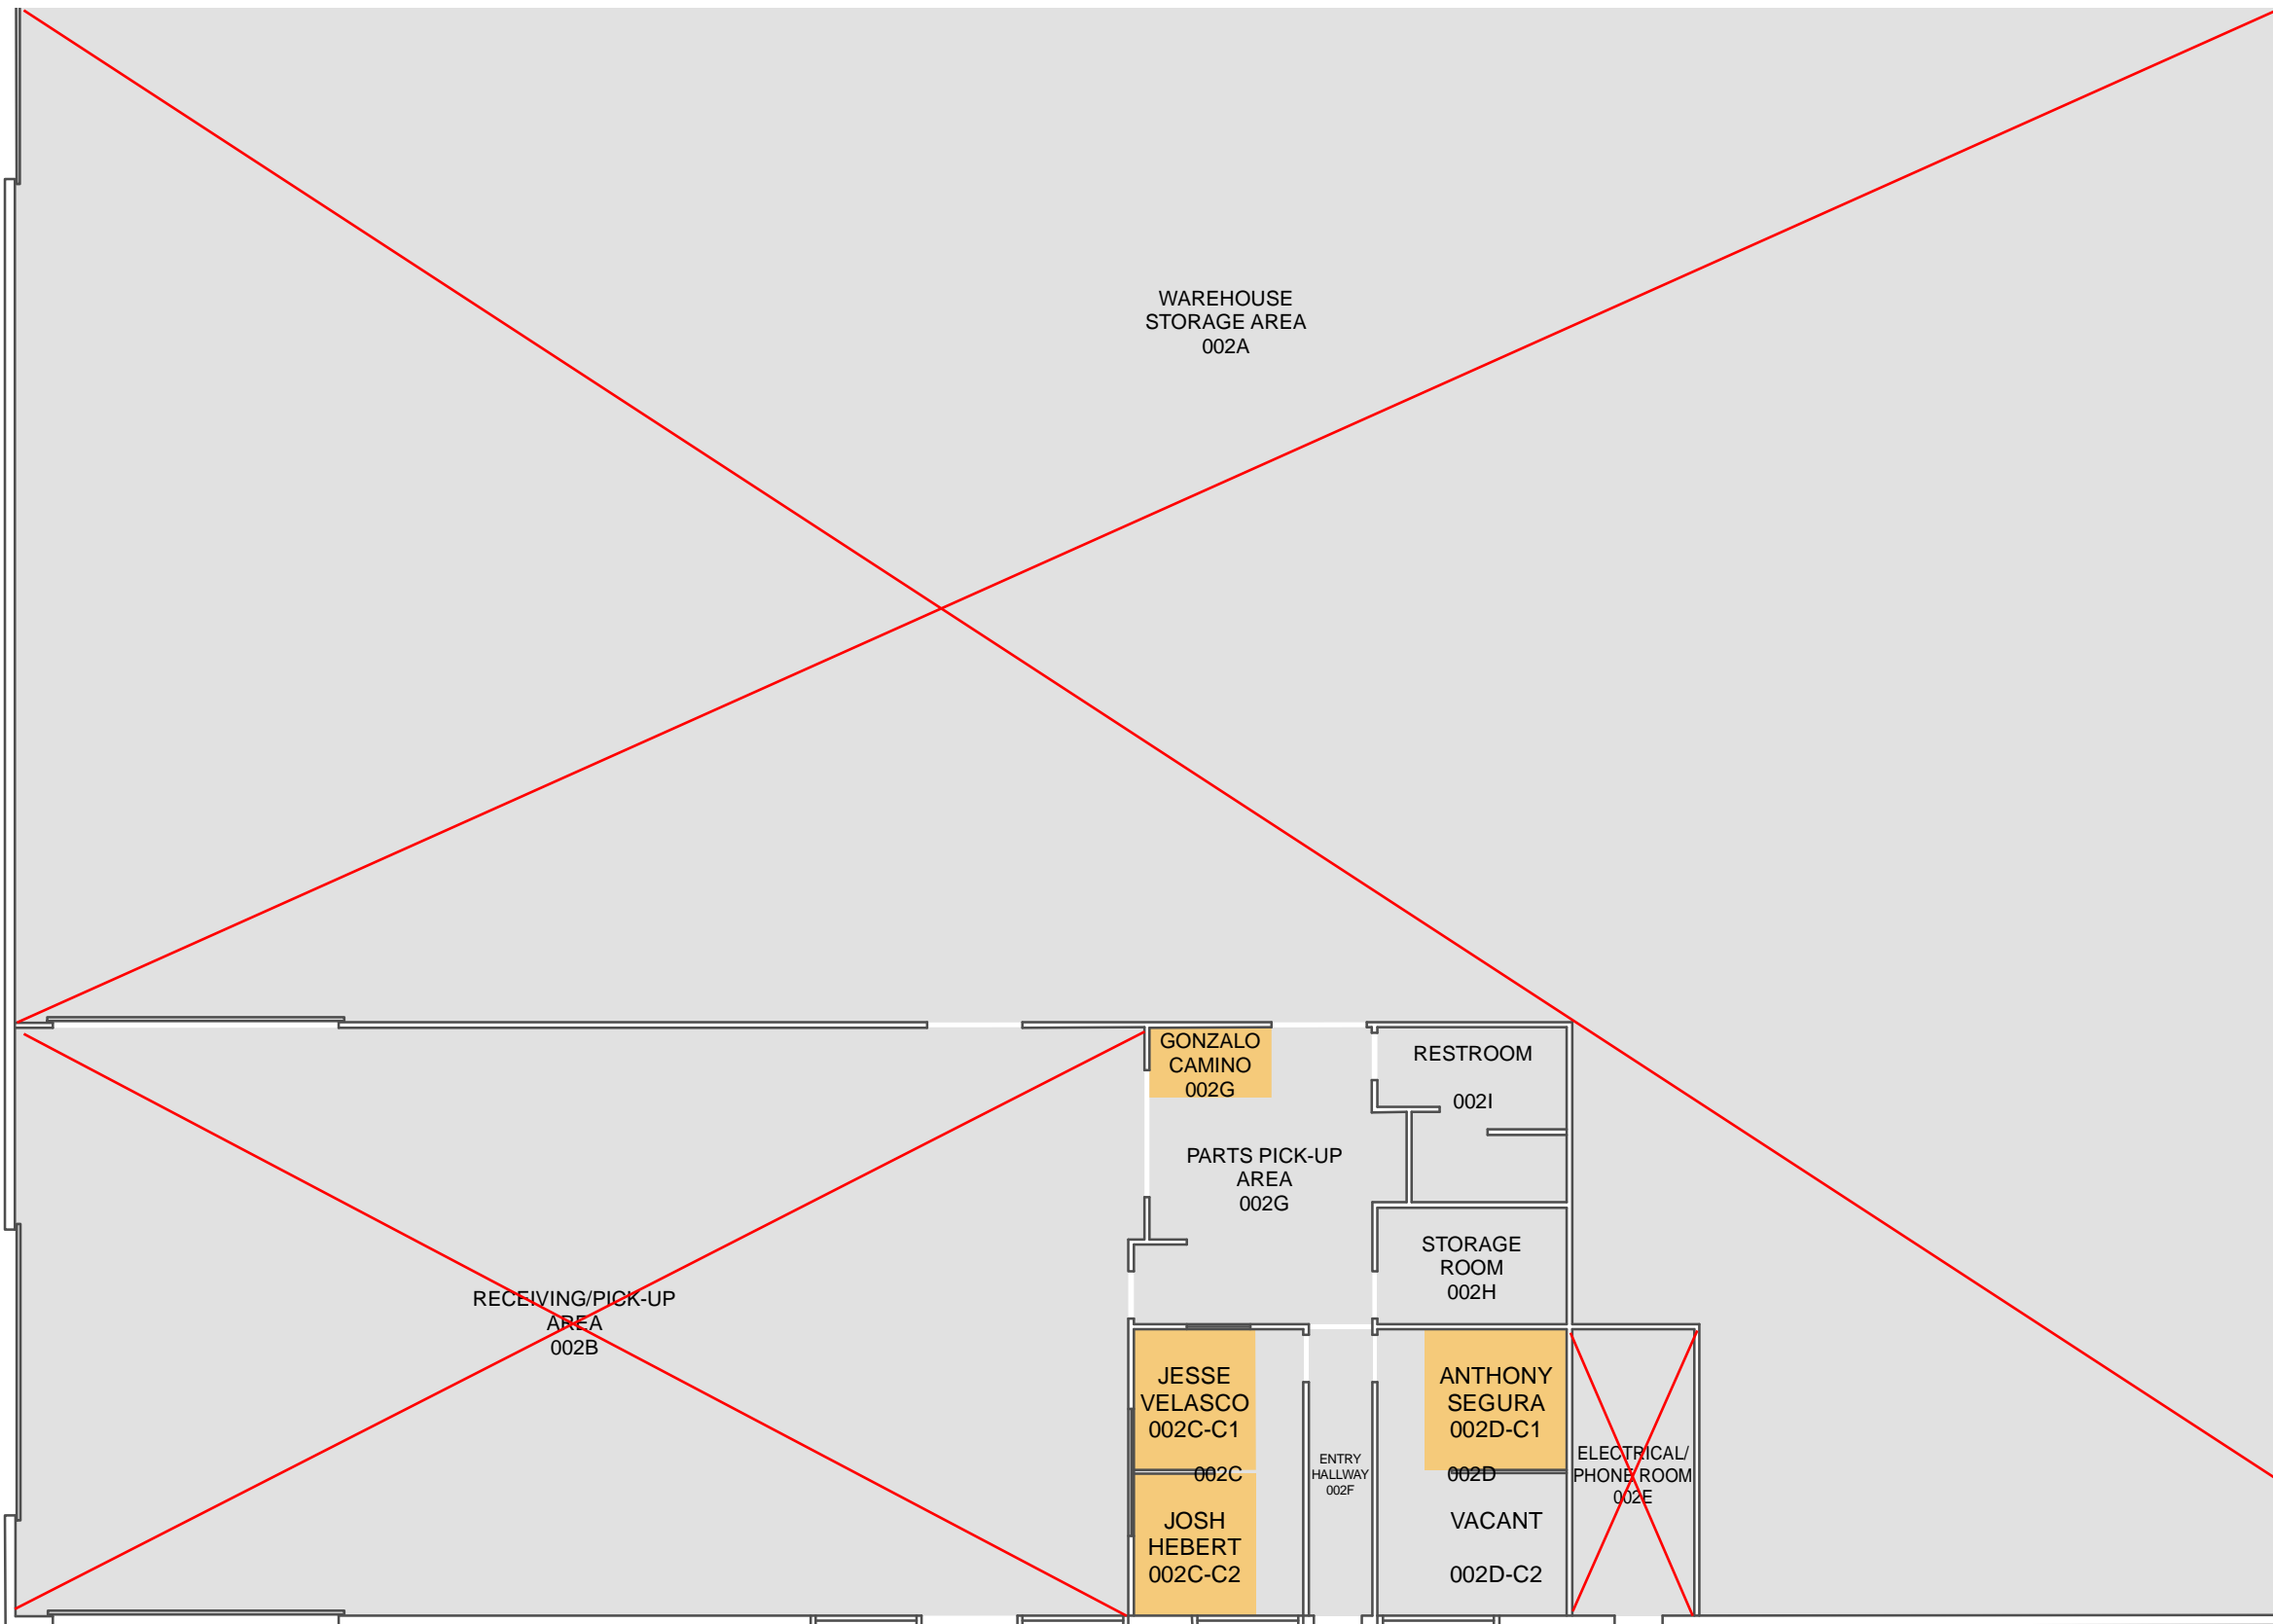

LOOP TAG LOCATION
22DROOM___

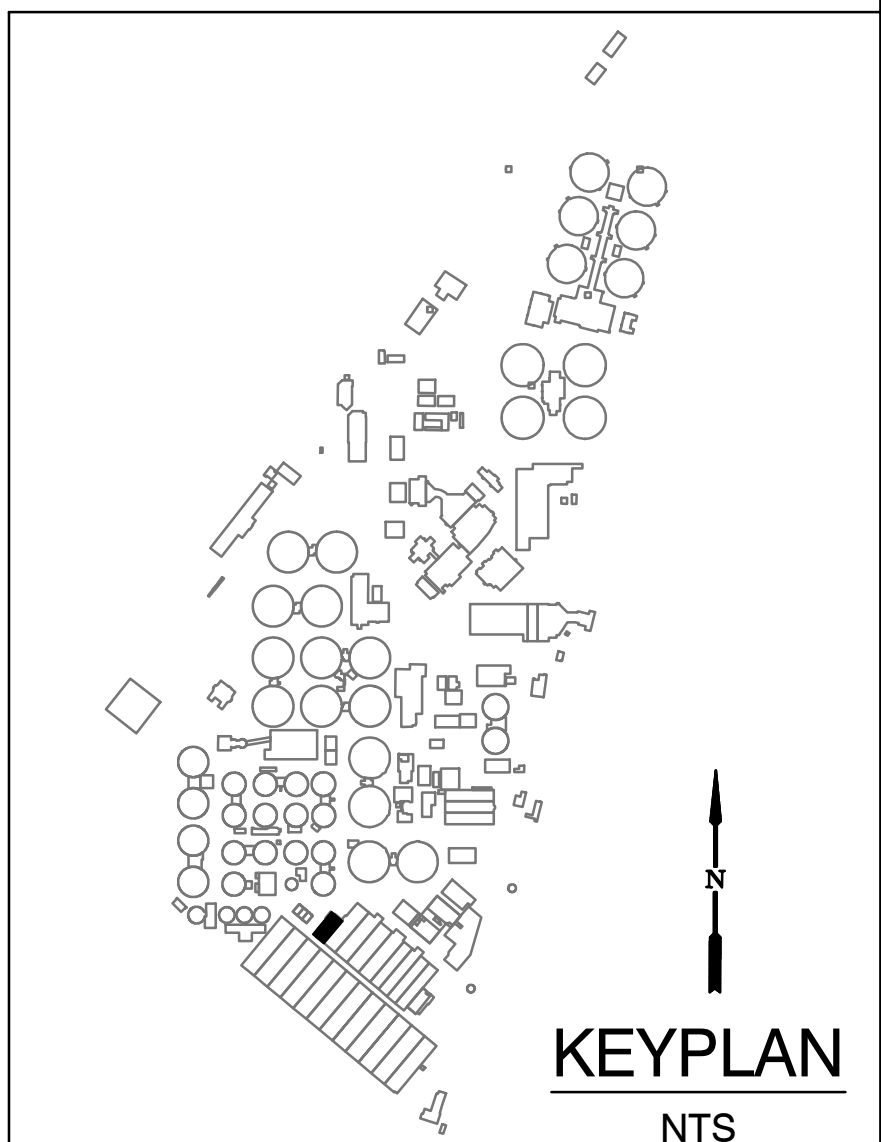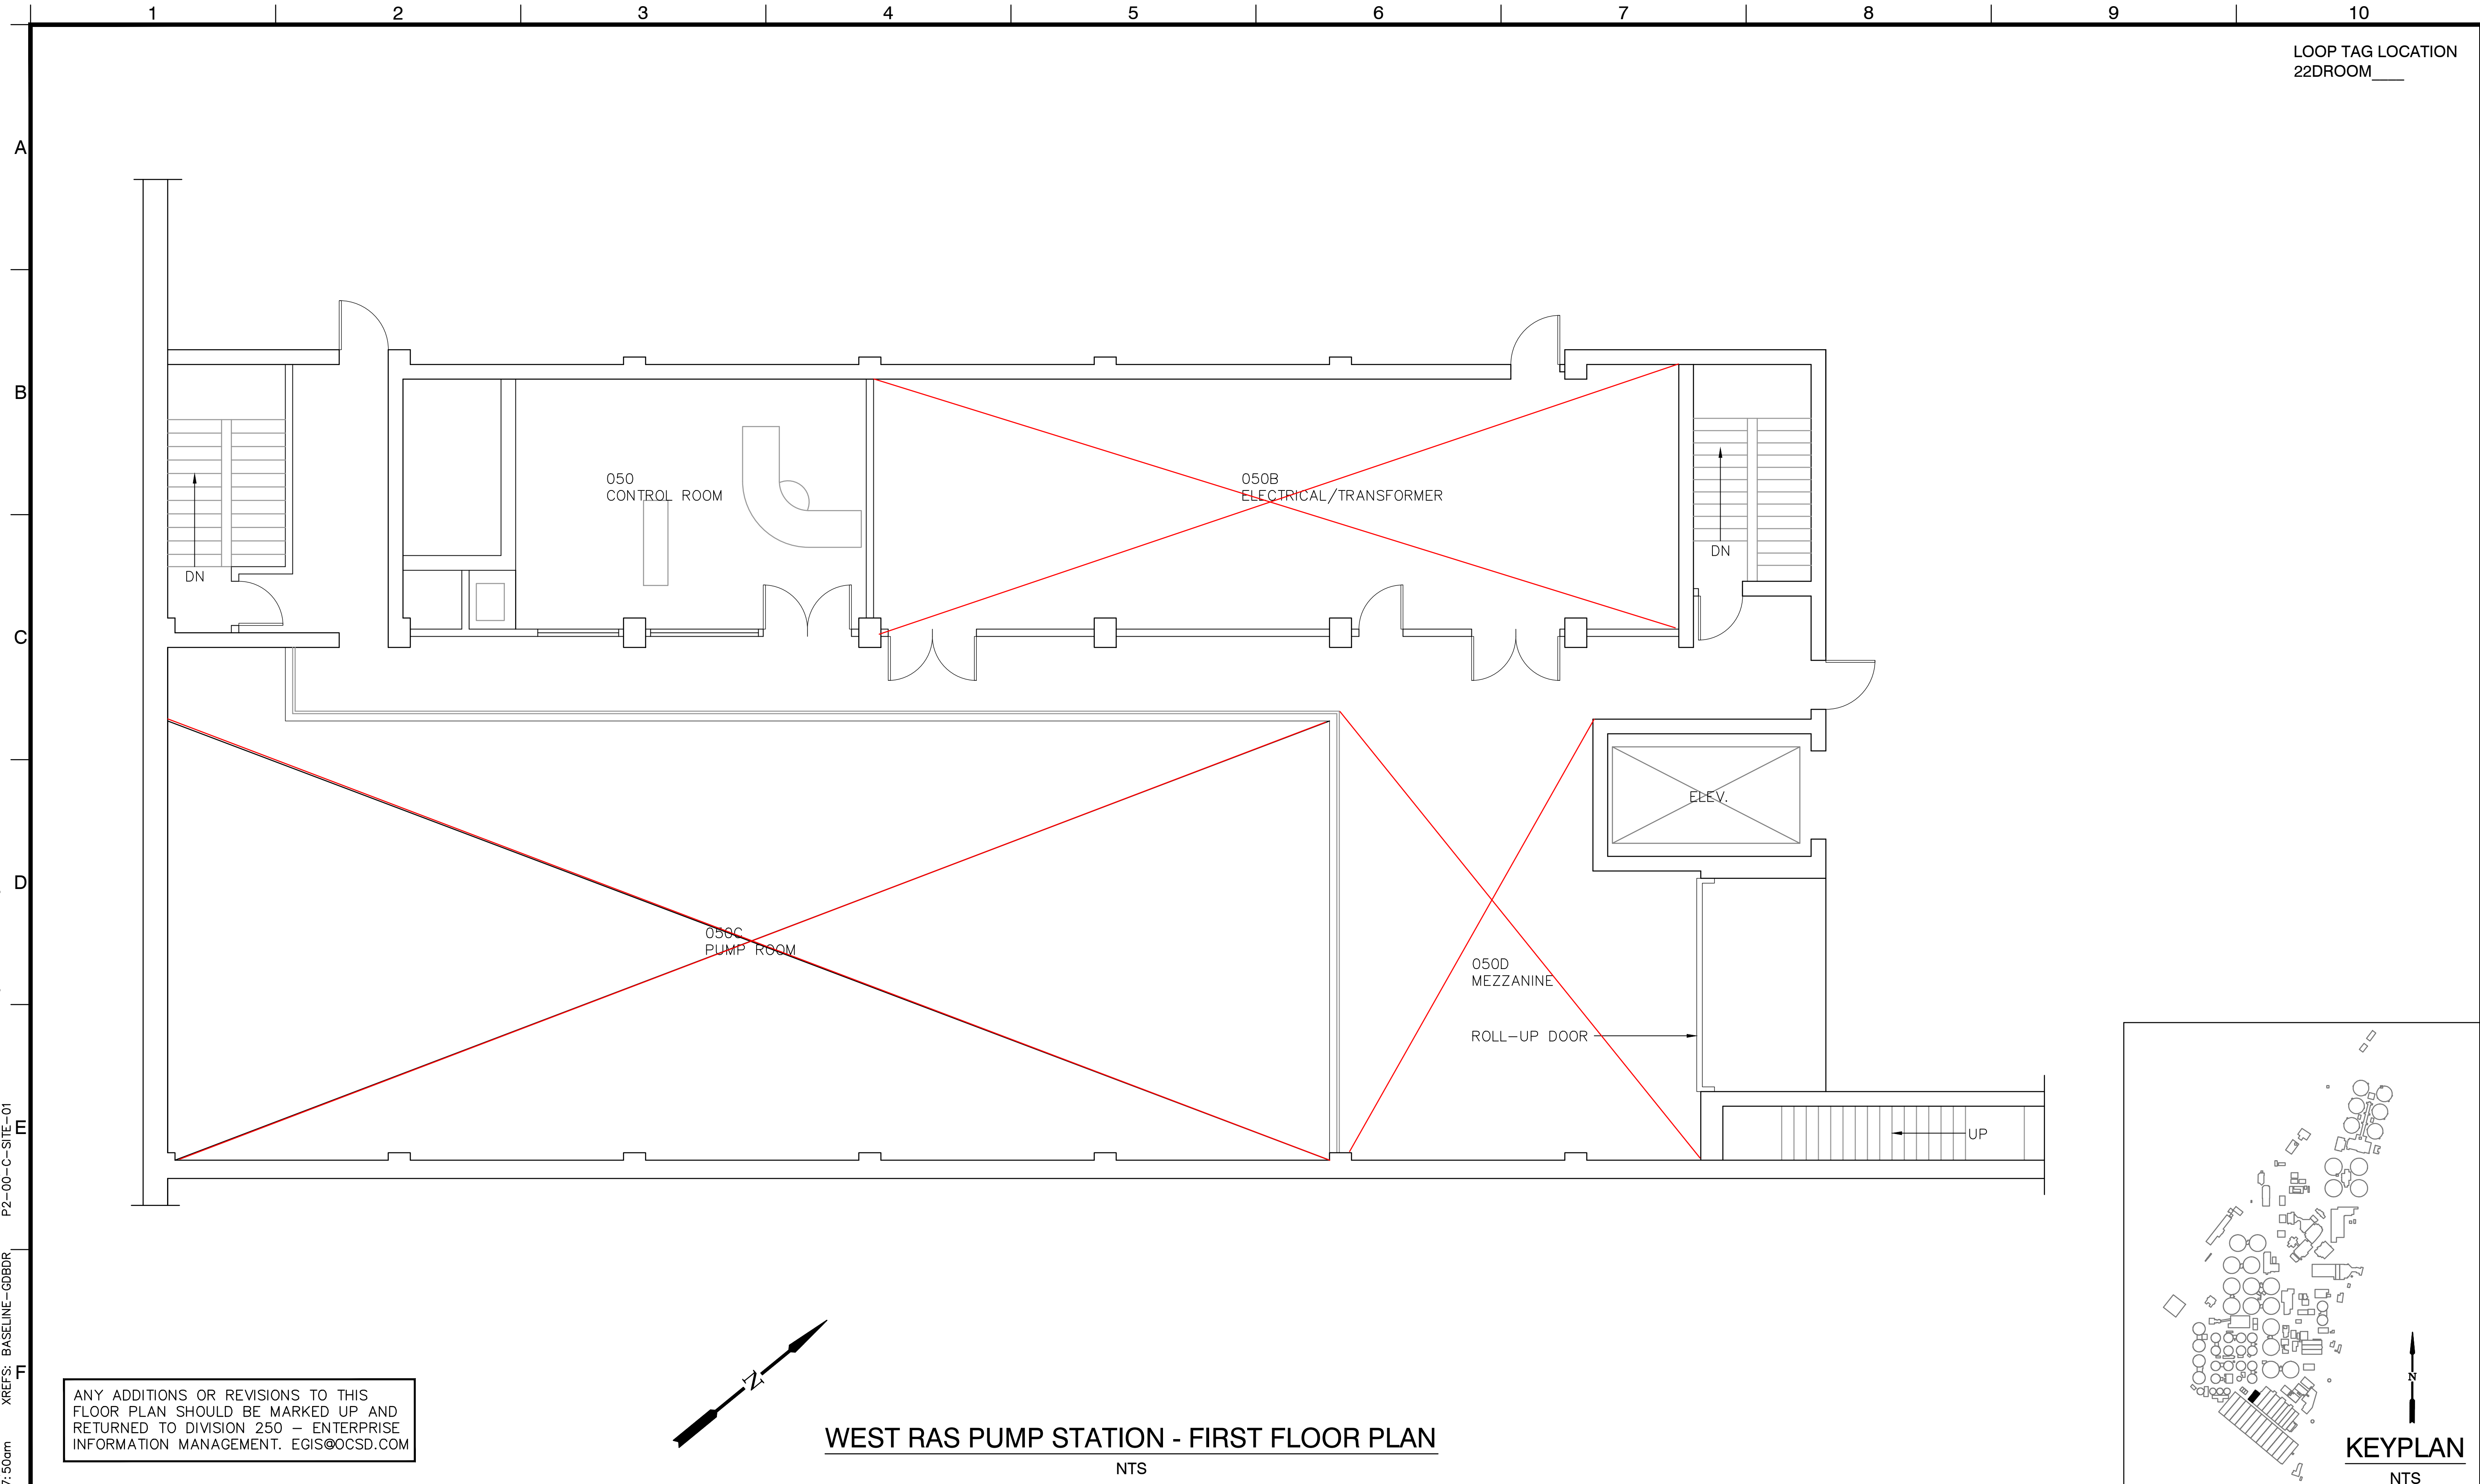


ANY ADDITIONS OR REVISIONS TO THIS FLOOR PLAN SHOULD BE MARKED UP AND RETURNED TO DIVISION 250 - ENTERPRISE INFORMATION MANAGEMENT. EGIS@OCSD.COM

WEST RAS PUMP STATION - FIRST FLOOR PLAN
NTS

KEYPLAN
NTS

DESIGNED BY: _____
DRAWN BY: RT - 06/13
CHECKED BY: _____
LINE IS 2 INCHES AT FULL SIZE
(IF NOT 2" - SCALE ACCORDINGLY)

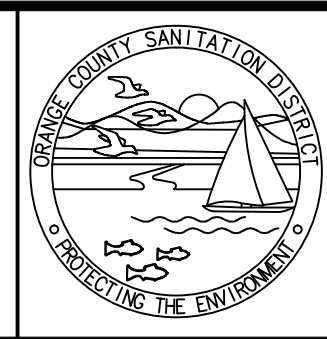

**ORANGE COUNTY
SANITATION DISTRICT**

PLANT NO. 2
BASELINE BUILDING FLOOR PLAN
**WEST RAS PUMP ROOM
FIRST FLOOR
LAYOUT PLAN**

PROJECT NO. BASELINE
DRAWING NO. _____
OF _____

DWG: J:\Facility Models\Architectural\Plant 2\FINAL FLOOR PLANS\DWG\P2-00-A-FLOOR-WRAS-01.dwg
 DATE: Aug 04, 2014 7:50am
 USER: tagumosi
 XREFS: BASELINE-GBBDR
 P2-00-C-SITE-01

MARK	DESCRIPTION	DATE	APPR.

Appendix A-4

JANITORIAL SQUARE FOOTAGE & PLUMBING FIXTURES OF STRUCTURES

For

Janitorial & Floor Maintenance Service at Plants 1 & 2

Exhibit A-4

OC SAN

SQUARE FOOTAGE AND PLUMBING FIXTURES OF STRUCTURES

Revised 8/4/2021

PLANT 1	carpet (FT ²)	vinyl/VCT/ceramic (FT ²)	concrete	stalls w toilets	urinals	showers	sinks	roll paper towel dispenser s	foam soap dispenser s	water dispenser s	Stoko Heavy Duty Hand Cleanser Dispenser	Refresh Foam Hand Sanitiser	Tork Hand Sanitiser	refrigerator s	microwave ovens	notes
MAIN GUARD SHACK		136		1			1	1	1	1				1	1	
WASTE HAULER DUMP STATION		453		1			1	1		1				1		
M & D BUILDING		312		1			1	1	1							
ADMINISTRATION BUILDING (1 elevator with carpet)	28,685	2,925		22	9	1	22	14	18	7			3	4	6	WATERLESS URINALS, 4 tampon/napkin dispensers
ENVIRONMENTAL LAB (1 elevator with vinyl floor) (Do not clean labroom sinks or counters)	7,395	18,174	1,428	12	4	6	16	25	9	6		2	4	2	4	2 tampon/napkin dispensers
HUMAN RESOURCES BUILDING	3,493	456		3	1		3	3	3	1		3		1	1	
FLEET SERVICES		923		2	2		4	5	4	1				1	2	
PURCHASING/WAREHOUSE BUILDINGS	3,402	296		5	2	1	6	2	2	3		2		2	5	
BUILDING 5 & 6 (1 elevator with carpet)	4,831	3726		8	4	8	10	8	8	6	3			6	8	1 tampon/napkin dispenser
BUILDING A	326	922		2	2	2	3	5	6	4	1	1		1	1	1 liquid soap paint shop
BUILDING B		654					4	2	2	2	2			2	3	Lunchroom and computer rooms have painted concrete floors
CONTROL CENTER	1,636	7,430		20	8	12	14	8	11	6				3	4	
CONTROL CENTER CART BARN			2,940													Sweep and trashcan liner replacement
CENTRAL GENERATION BUILDING (1 elevator with vinyl floor)		1,873		4	3	3	7	4	5	2	2			2	1	
BLOWER BUILDING 1		468		1	1		1	1	1	1						
THICKENING AND DEWATERING FACILITY		2,744		3		1	4	4	4	2				1	1	
SOLIDS STORAGE & TRUCKLOADING FACILITY		960		1	1		3	1	1	1						
DAF THICKENERS (Do not clean lab sinks or counters)		400		2	1		2	3	2	1		2		1	1	Raised computer floor in control room & hall
ENGINEERING TRAILER A	8,616	264		4	2		4	2	2	3		3		1	1	
ENGINEERING TRAILER B	7,662	914		5	2		5	3	4	3		4		2	2	
ENGINEERING TRAILER E	3,000	112		2			2	2	2	1		2				
ENGINEERING TRAILER F	6,372	572		3	1		4	3	4	1				2	2	
POWER BUILDING 3A		896														
DIGESTER CONTROL ROOM		560								1						
P1-37 RESTROOM		64		1			1	1	1	1						1 multifold dispenser
PLANT WATER STATION																
POWER BUILDING 6		1,140														Annual floor maintenance
RAS PUMP STATION LAB (Do not clean lab sink or counters)			108					1	1							
BLOWER BUILDING 2 (Do not clean lab sink or counters)			562	1			2	2	1	1	1					
GARFIELD PORTABLE GUARD SHACK		96						1		1					1	
POWER BUILDING 4		547														Annual floor maintenance
TOTALS	75,418	47,374	5,038	104	43		120	102	93	56	9	19	7	33	44	

Exhibit A-4
OC SAN
SQUARE FOOTAGE AND PLUMBING FIXTURES OF STRUCTURES

	carpet (FT ²)	vinyl/VCT/ceramic (FT ²)	concrete	stalls w toilets	urinals	showers	sinks	roll paper towel dispenser s	foam soap dispenser s	water dispenser s	Stoko Heavy Duty Hand Cleanser Dispenser	Refresh Foam Hand Sanitizer	Tork hand sanitizer dispenser s	refrigerator s	microwave ovens	notes
PLANT 2																
MAINTENANCE BUILDING (1 elevator with vinyl floor)	1,705	10,979		8	6	10	13	7	8	8	3			8	10	2 multifold, 1 tampon, 1 napkin dispenser in women's
OPERATIONS CENTER (1 elevator with vct) (Do not clean lab sinks or counters)		10,360		12	8	14	14	9	10	4	5	3		3	3	3 tissue dispensers, 1 tampon, 1 napkin dispensers in women's, gym with rubber and concrete floor, raised computer floor in computer room and lobby
OPERATIONS CART BARN			4,000													Sweep and trashcan liner replacement
WAREHOUSE	902	130		1		1	2	3	3	2				1	1	
CENTRAL GENERATION/OOBS		5,533		5	2	7	7	4	6	3	2			3	2	Under construction
CENTRAL GENERATION MECHANICS OFFICE AREA			812				1	1	1	1	1		1	2	2	
CONSTRUCTION MANAGEMENT / ENGINEERING TRAILERS/SAFETY TRAILER	8,245	524		8	6	1	12	9	8	6	1	6		5	5	
P2 MAIN ENTRANCE GUARD SHACK		290		1			1	1	1	1				1	1	
SOLIDS STORAGE & TRUCKLOADING FACILITY		945		1			1	1	1	1	1	1		1	1	
WEST RAS (Do not clean lab sink or counters)		600					1	1	1	1						
EAST RAS (Do not clean lab sink or counters)		663		1			2	1	1	1					1	
PDF BUILDING		912		1	1		1	1	1							
OXYGEN BUILDING DO NOT ENTER 12kv DISTRIBUTION B		1,136		1			1	1	1		1				1	
CENTRIFUGE BUILDING		81	864	1			2	2	2	1				1	1	
FINAL SAMPLE BUILDING (No Wax Vinyl Floor)	160		1,440				1	2	2							
DISTRIBUTION CENTER H		49		1			1	1	1	1		1				
DISTRIBUTION CENTER J (Do not clean lab sinks or counters)		524		1			1	1	1	1						
BUSHARD PORTABLE GUARD SHACK		100						1		1					1	
BANNING PORTABLE GUARD SHACK		288						1		1					1	
DAFT BUILDING		25		1			1	1	1							
TOTALS	11,012	33,139	7,116	42	23	33	61	48	48	33	14	11	1	25	30	

Appendix A-5
Contract Janitorial Daily Work Performance Log
For
Janitorial & Floor Maintenance Service at Plants 1 & 2



Appendix A-5
Contract Janitorial Daily Work Performance Log
(Submit to OC San Every Monday)

PLANT: ____ LOCATION: _____

Start Date: _____ End Date: _____ Company Name: _____

All Custodial Work Must Be Completed Upon Completion of This Document

Daily Services (General): Check each line below following the task for each day of the week: M T W TH F S SU

- Hard Floors (incl. corners): sweep & damp mop ____
Counters, sinks, tables & appliance exteriors: clean & disinfect ____
Carpets: spot clean and vacuum scraper mats ____
Water coolers and trays: clean, restock cups ____
Desks, tables, office furn. & partitions: dust ____
Paper towel, Tissue, Soap and Feminine Product dispensers: fill ____
Door handles: disinfect ____
Tables and chairs (lunch, meeting, & conference rooms): damp wipe ____
Doors, glass, frames, windowsills & baseboards: spot clean ____
Paper shredder & recycle receptacles: empty ____
Trash: empty, disinfect & replace liners ____
Elevators: sweep, damp mop, remove smudges ____
Fuel Station: pick up, empty trash, replace liners ____
Entryways: sweep decks & stairs, wet wipe handrails ____
Appliance exteriors: spot clean ____
Disinfect door handles, light switches, rails ____

Comments: _____

Weekly Services (General): Check the box once task is completed

- Elevators: clean thresholds, polish stainless steel, vacuum
Carpets: vacuum
Microwave and conventional ovens: clean interiors
15 gallon recycle paper bins (bi-weekly): empty
Baseboards, door jambs and kick plates: clean
Walls, counters, windowsills, partitions, sills: dust & spot clean
Doors (kick plates, frames & glass): clean & polish
Window blinds: clean

Comments: _____

Monthly Services (General): Fill in dates after completing task

- HVAC vents: clean DATES: _____
Refrigerators & Freezers: clean interior DATES: _____ Light Fixtures: dust and remove cobwebs DATES: _____
Skylights and Openings: dust & remove cobwebs DATES: _____

Comments: _____

Quarterly Services (General and Restrooms): Fill in dates after completing task

- Wash/scrub and disinfect wall tiles and partitions DATES: _____ Hard surface floors include restrooms: spray & buff DATES: _____

Comments: _____

Daily Service (Restrooms): Check each line following the task for each day of the week: M T W TH F S SU

- Floors: sweep & mopped (disinfectant solution) ____
Toilets & seats: disinfect, inside, outside & underneath ____
Sinks, counters & fixtures: clean & disinfect ____
Urinals: disinfect, inside, outside & underneath ____
Floor drains: pour water to prime drain ____ (spot clean)
Door Handles & Light Switchers: disinfect ____
Showers: walls, floors, partitions, curtains, fixtures & mats: scrub & disinfect ____
Trash: empty, clean, disinfect & insert new liners ____
Dispensers (all paper, soap, feminine prod, hand sanitizer, etc.): fill ____
Lockers & Benches: spot clean ____
Doors, locker room walls, partitions, glass & mirrors ____

Comments: _____

Weekly Services (Restroom): Check the box once task is completed

- Toilet stall partitions: clean & polish
Doors, jams, wall partitions: clean & polish
Mirrors, Chrome & Stainless Steel fixtures: clean & polish
Showers: walls, floors, partitions, curtains, fixtures & mats: scrub & disinfect: spot clean

Comments: _____

Monthly Services (Restroom): Fill in dates after completing task

- Hard Surface Floors: scrub DATES: _____ Lockers: clean & disinfect exterior DATES: _____
Light Fixtures: dust & remove cobwebs DATES: _____
Skylights & Openings: dust & remove cobwebs DATES: _____ HVAC Vents: clean DATES: _____

Comments: _____

Contractor Representative Date
(acknowledges completion of "checked" boxes)

OCSan Representative Date
(acknowledges receipt of document from Contractor Representative)